




REV 1 - 04.09.24
REV 2 - 05.24.24

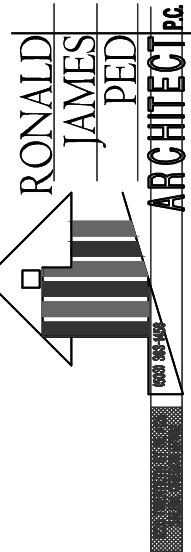


LANDSCAPE KEY

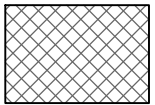

BARKDUST

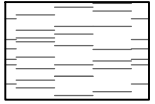

LAWN

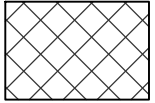

EXISTING
LANDSCAPE




ON SITE STORM
RETENTION

LANDSCAPE
AREA: ~~540~~/20
PU REQ: 27
TREE PU MIN: 27x.4=10.8
TREE PU PROVIDED: 15
GC: ~~328~~/50=6.56 PU
SHRUBS: 15 (1PU)
PU PROVIDED: 36.56

LANDSCAPE
AREA: ~~318~~/20
PU REQ: 15.9
TREE PU MIN: 15.9x.4=6.36
TREE PU PROVIDED: 25
SHRUBS: 8 (1PU)
PU PROVIDED: 33

LANDSCAPE
AREA: ~~2260~~/20
PU REQ: 113
TREE PU MIN: 113x.4=45.2
TREE PU PROVIDED: 80
GC: ~~1,725~~/50=34.5 PU
SHRUBS: 26 (1PU)
PU PROVIDED: 140.50

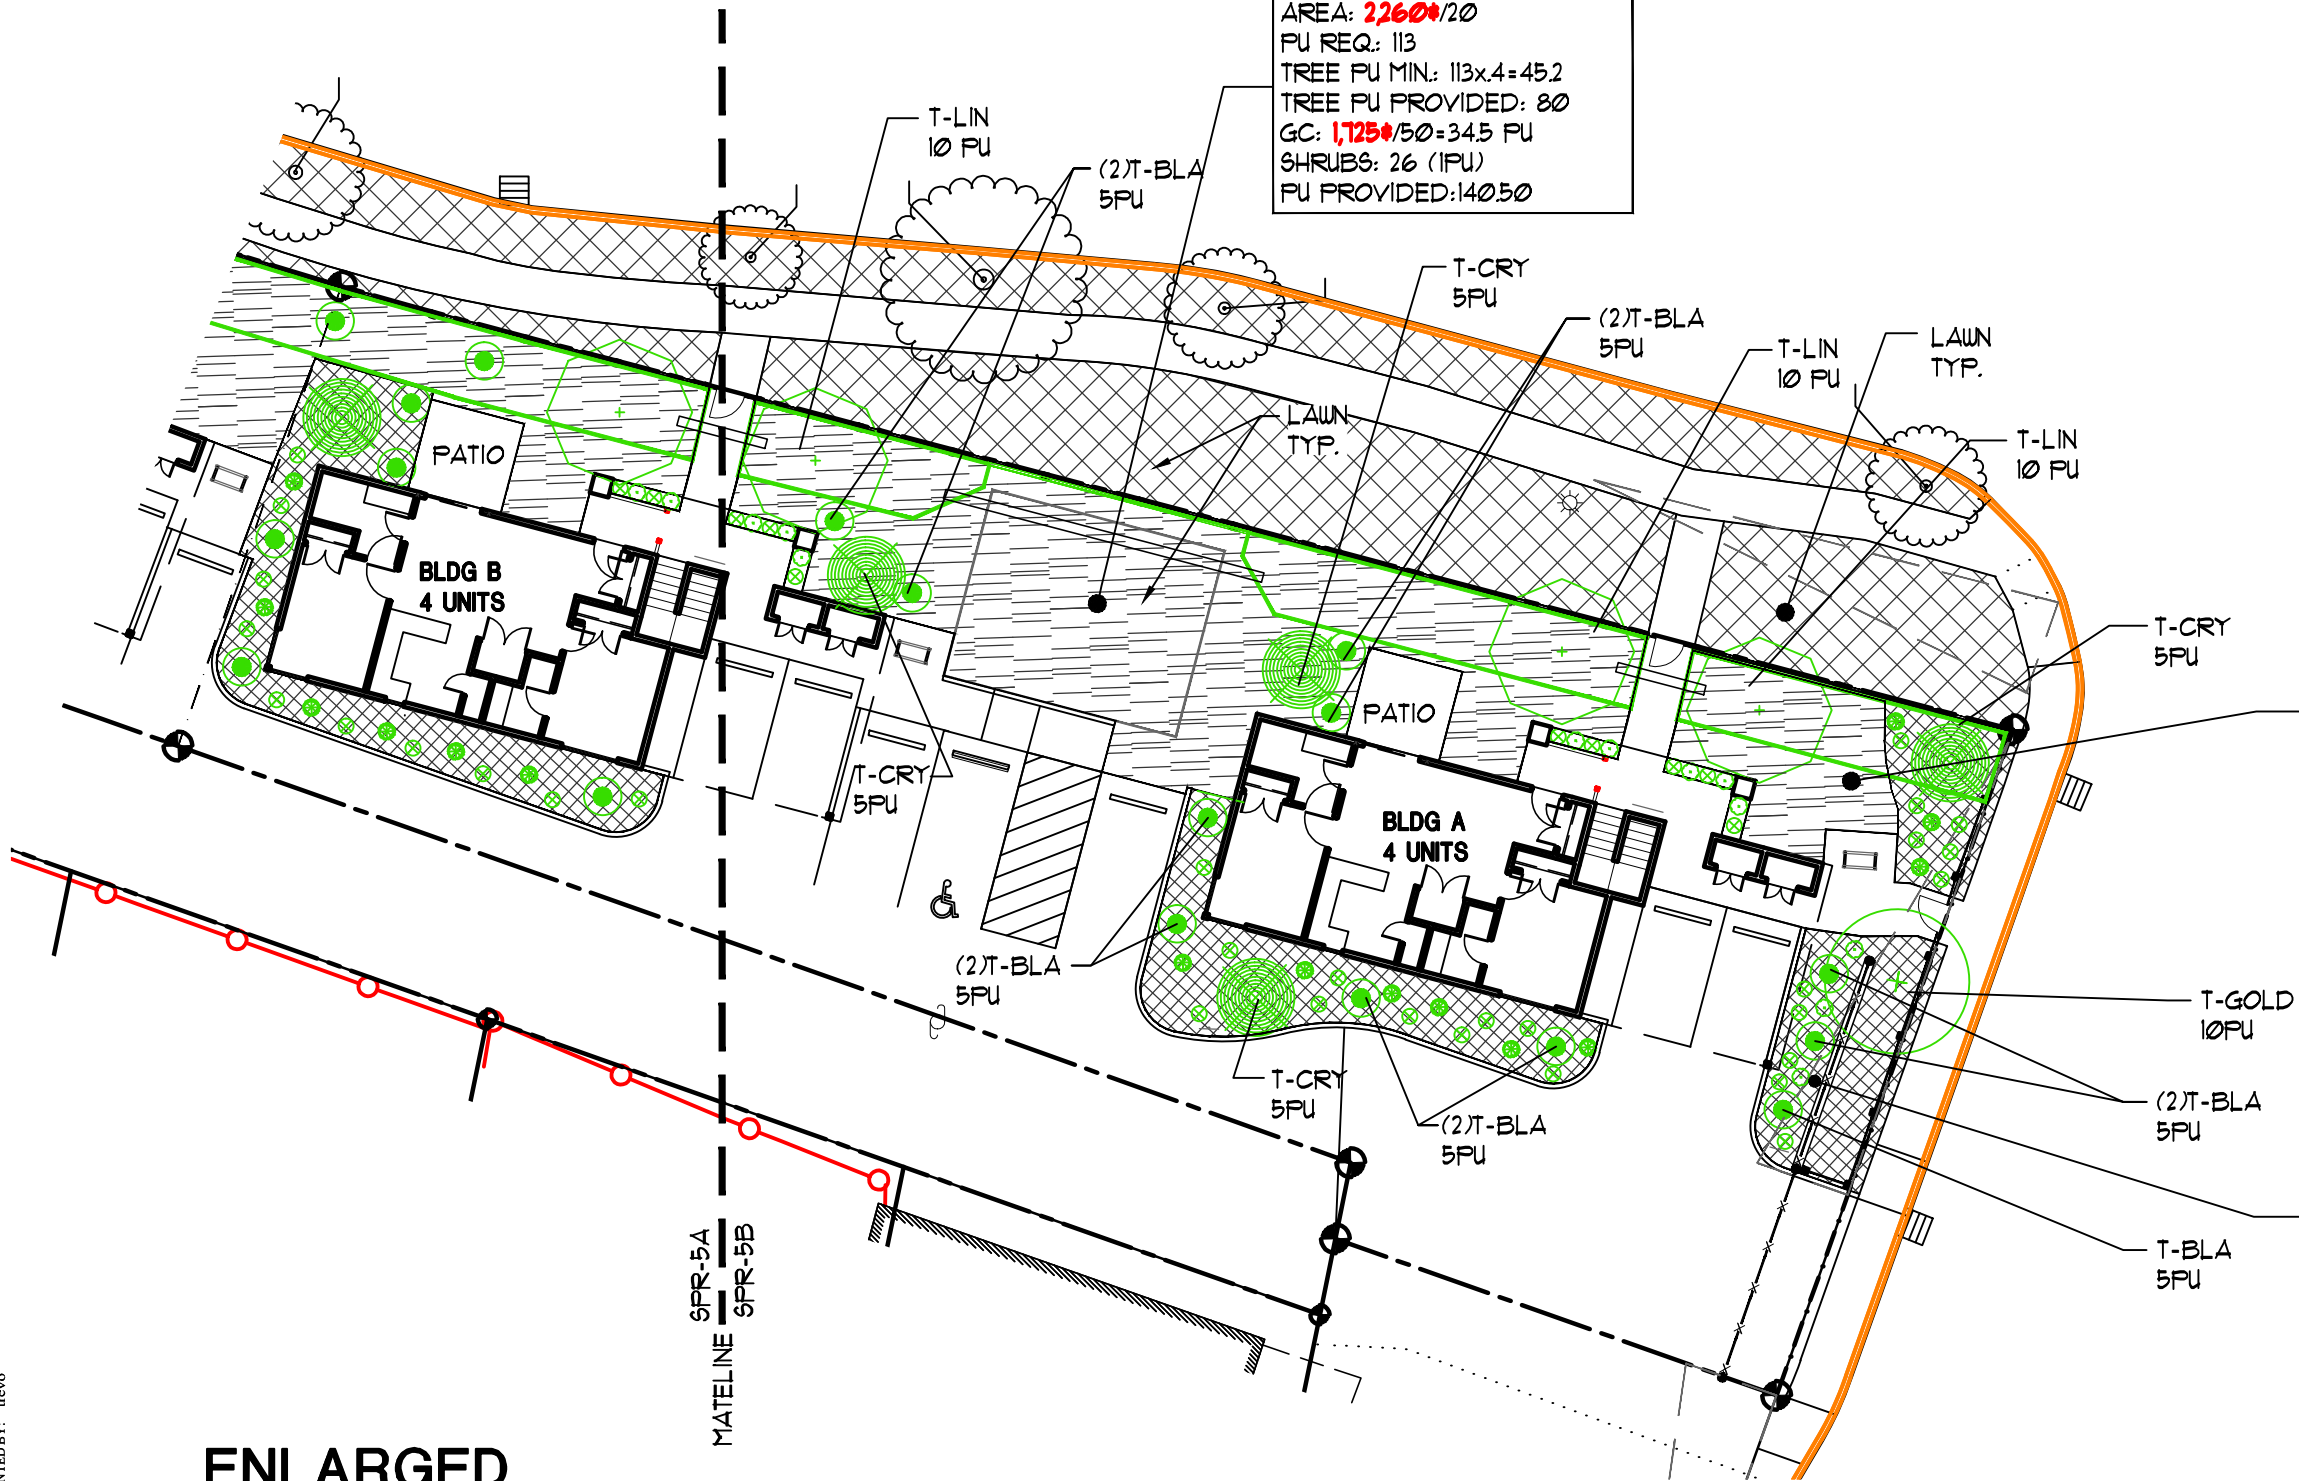

ENLARGED
LANDSCAPE PLAN

SCALE : 1" = 20'

0 10' 20' 40'



LAST SAVED: Thu, 23 May 2024 - 12:17 pm LOCATION: C:\Users\trevo\appdata\local\temp\AcPublish_8708\SPR-3_05.20.24.dwg SPR-5B-LANDSCAPE
PRINTED: Thu, 23 May 2024 - 12:18 pm PRINTED BY: trevo

NEW APARTMENTS FOR:
SERVANDO GARCIA
17th and OAK, SALEM OR 97301

DATE: 02-07-2024
DRAWN: TB
JOB NO.: 2159

SPR-5B