


# SITE PLAN


CONTRACTOR:

WIND RIVER HOMES  
(503) 983-9188

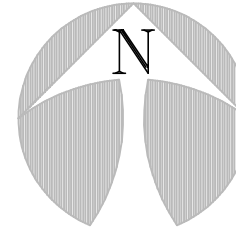

1"=20'

LOT# 45  
5,904 SF

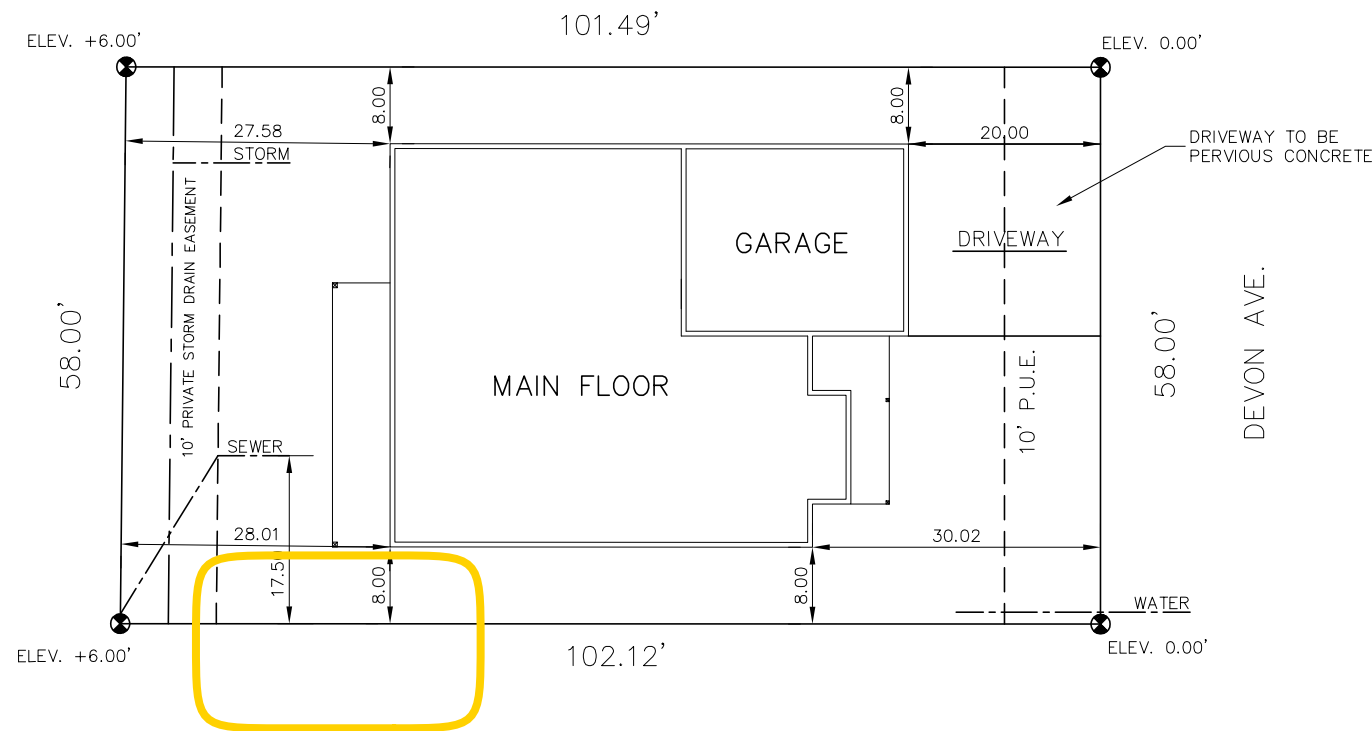

SUBDIVISION: AFFINITY ESTATES LOT: 45 BLK: \_\_\_\_\_  
NAME: \_\_\_\_\_ PH. # \_\_\_\_\_  
ADDRESS: \_\_\_\_\_ CDA: \_\_\_\_\_  
ASBUILT # \_\_\_\_\_ MAP # \_\_\_\_\_  
STORM DRAINAGE: \_\_\_\_\_  
WATER SERVICE LEVEL: \_\_\_\_\_ CODE: \_\_\_\_\_ PS: \_\_\_\_\_  
SIDEWALK: \_\_\_\_\_

## APPROVAL STAMPS

- \* CONTRACTOR TO VERIFY ALL DIMENSIONS IN FIELD\*
- \* ALL UTILITY LOCATIONS ARE TO BE DETERMINED BY CONTRACTOR.\*
- \* ALL PROPERTY ELEVATIONS ARE TO BE DETERMINED BY CONTRACTOR.\*

SITE PLAN  
LOT#45. 6743 DEVON AVE. S.E.  
SALEM, OREGON  
SCALE: 1" = 20.00'