


LAST SAVED: Tue, 09 Jul 2024 - 04:20 pm
PRINTED: Tue, 09 Jul 2024 - 04:36 pm
LOCATION: C:\Users\trevo\appdata\local\temp\AcPublish_17820\SPR-3_07.09.24.dwg SPR-5B-LANDSCAPE
PRINTED BY: trevo

A
SPR-5B

ENLARGED LANDSCAPE PLAN


SCALE : 1" = 20'

0 10' 20' 40'

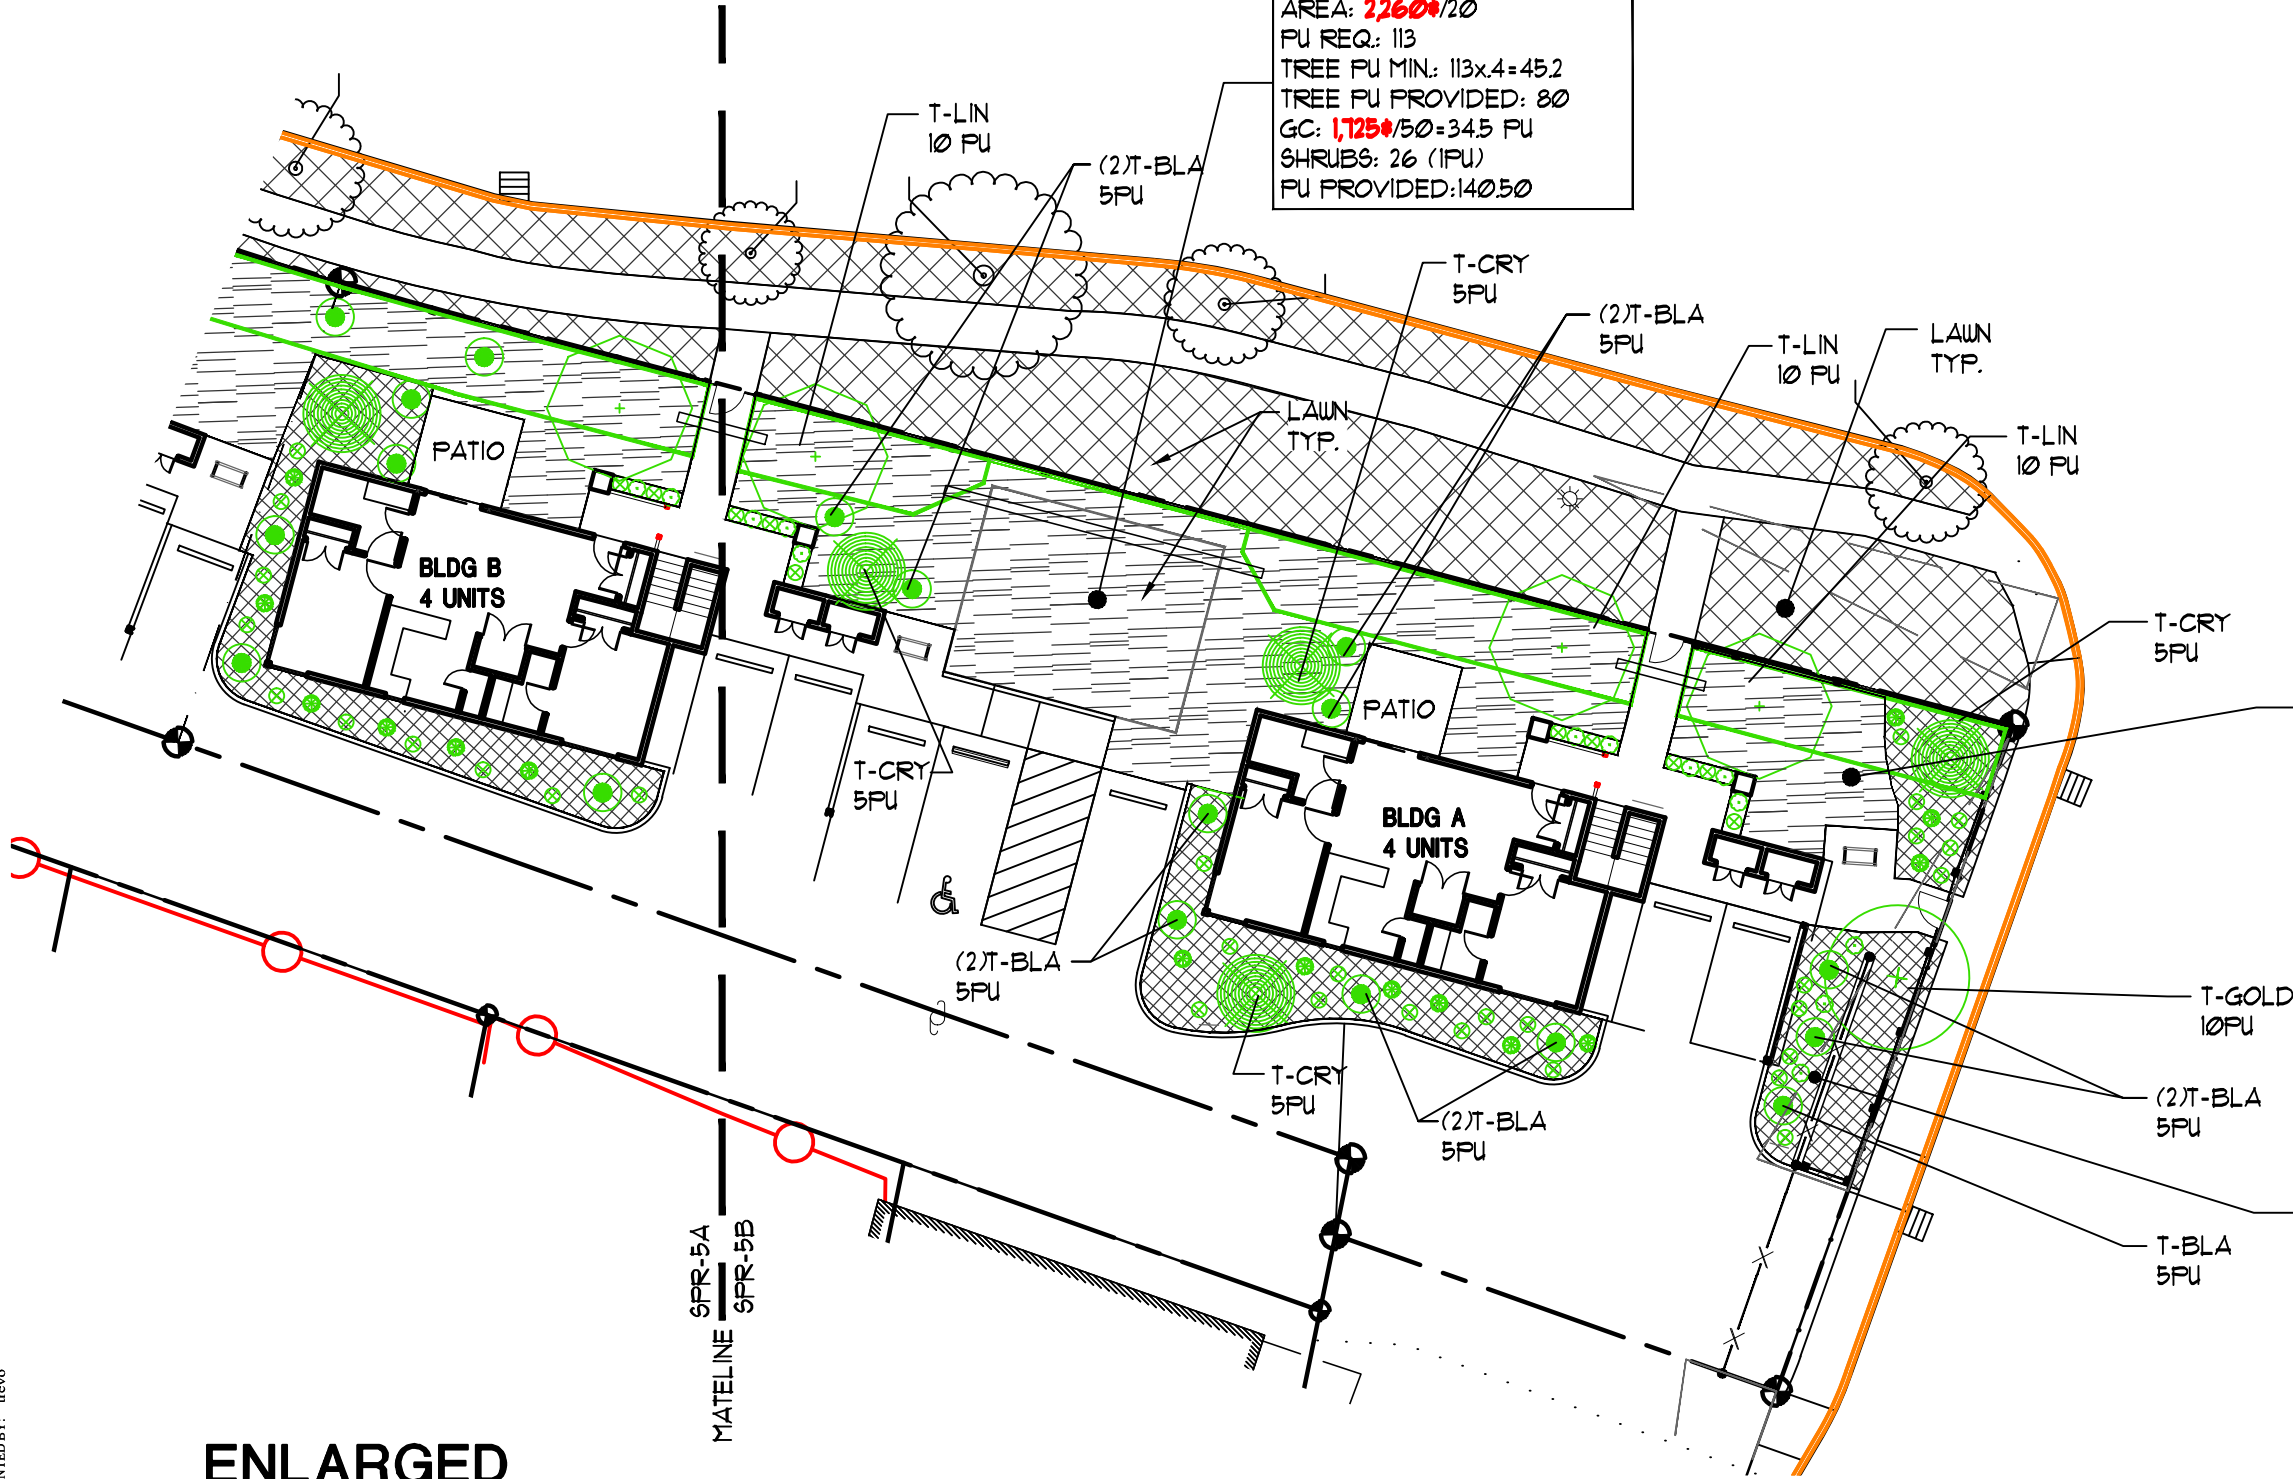

LANDSCAPE
AREA: ~~2260~~/20
PU REQ.: 113
TREE PU MIN.: 113x.4=45.2
TREE PU PROVIDED: 80
GC: ~~1,725~~/50=34.5 PU
SHRUBS: 26 (1PU)
PU PROVIDED: 140.50

LANDSCAPE KEY

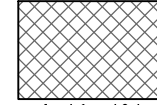

BARKDUST



LAWN



EXISTING
LANDSCAPE



ON SITE STORM
RETENTION

LANDSCAPE
AREA: ~~540~~/20
PU REQ.: 27
TREE PU MIN.: 27x.4=10.8
TREE PU PROVIDED: 15
GC: ~~328~~/50=6.56 PU
SHRUBS: 15 (1PU)
PU PROVIDED: 36.56

LANDSCAPE
AREA: ~~318~~/20
PU REQ.: 15.9
TREE PU MIN.: 15.9x.4=6.36
TREE PU PROVIDED: 25
SHRUBS: 8 (1PU)
PU PROVIDED: 33



NEW APARTMENTS FOR:
SERVANDO GARCIA
17th and OAK, SALEM OR 97301

DATE: 02-07-2024
DRAWN: TB
JOB NO.: 2159

SPR-5B

REV 1 - 04.09.24
REV 2 - 05.24.24
REV 3 - 07.09.24

