
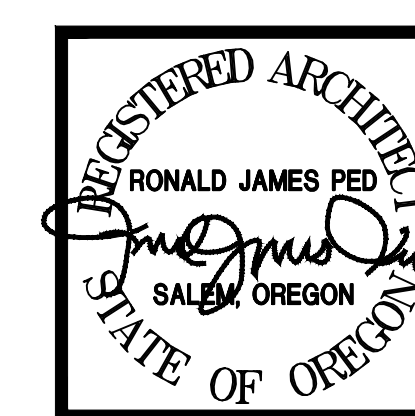
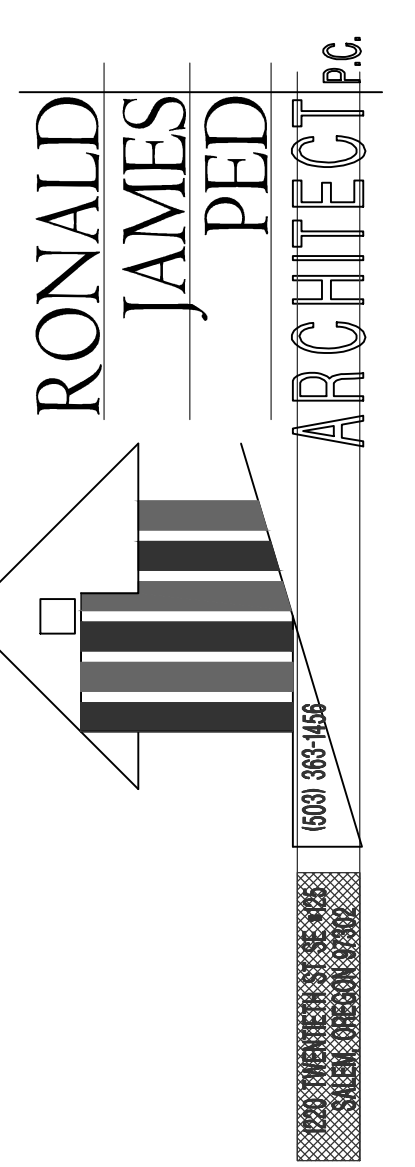
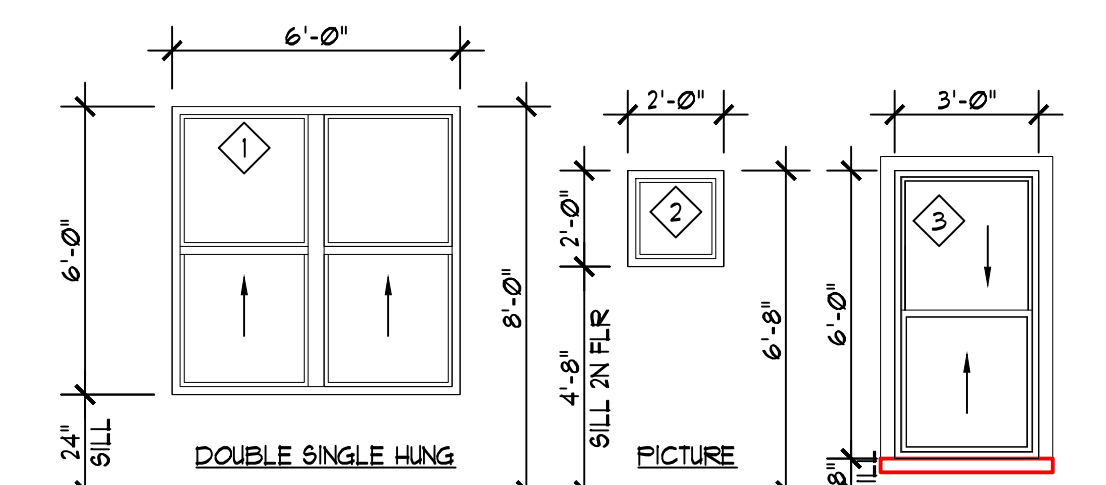
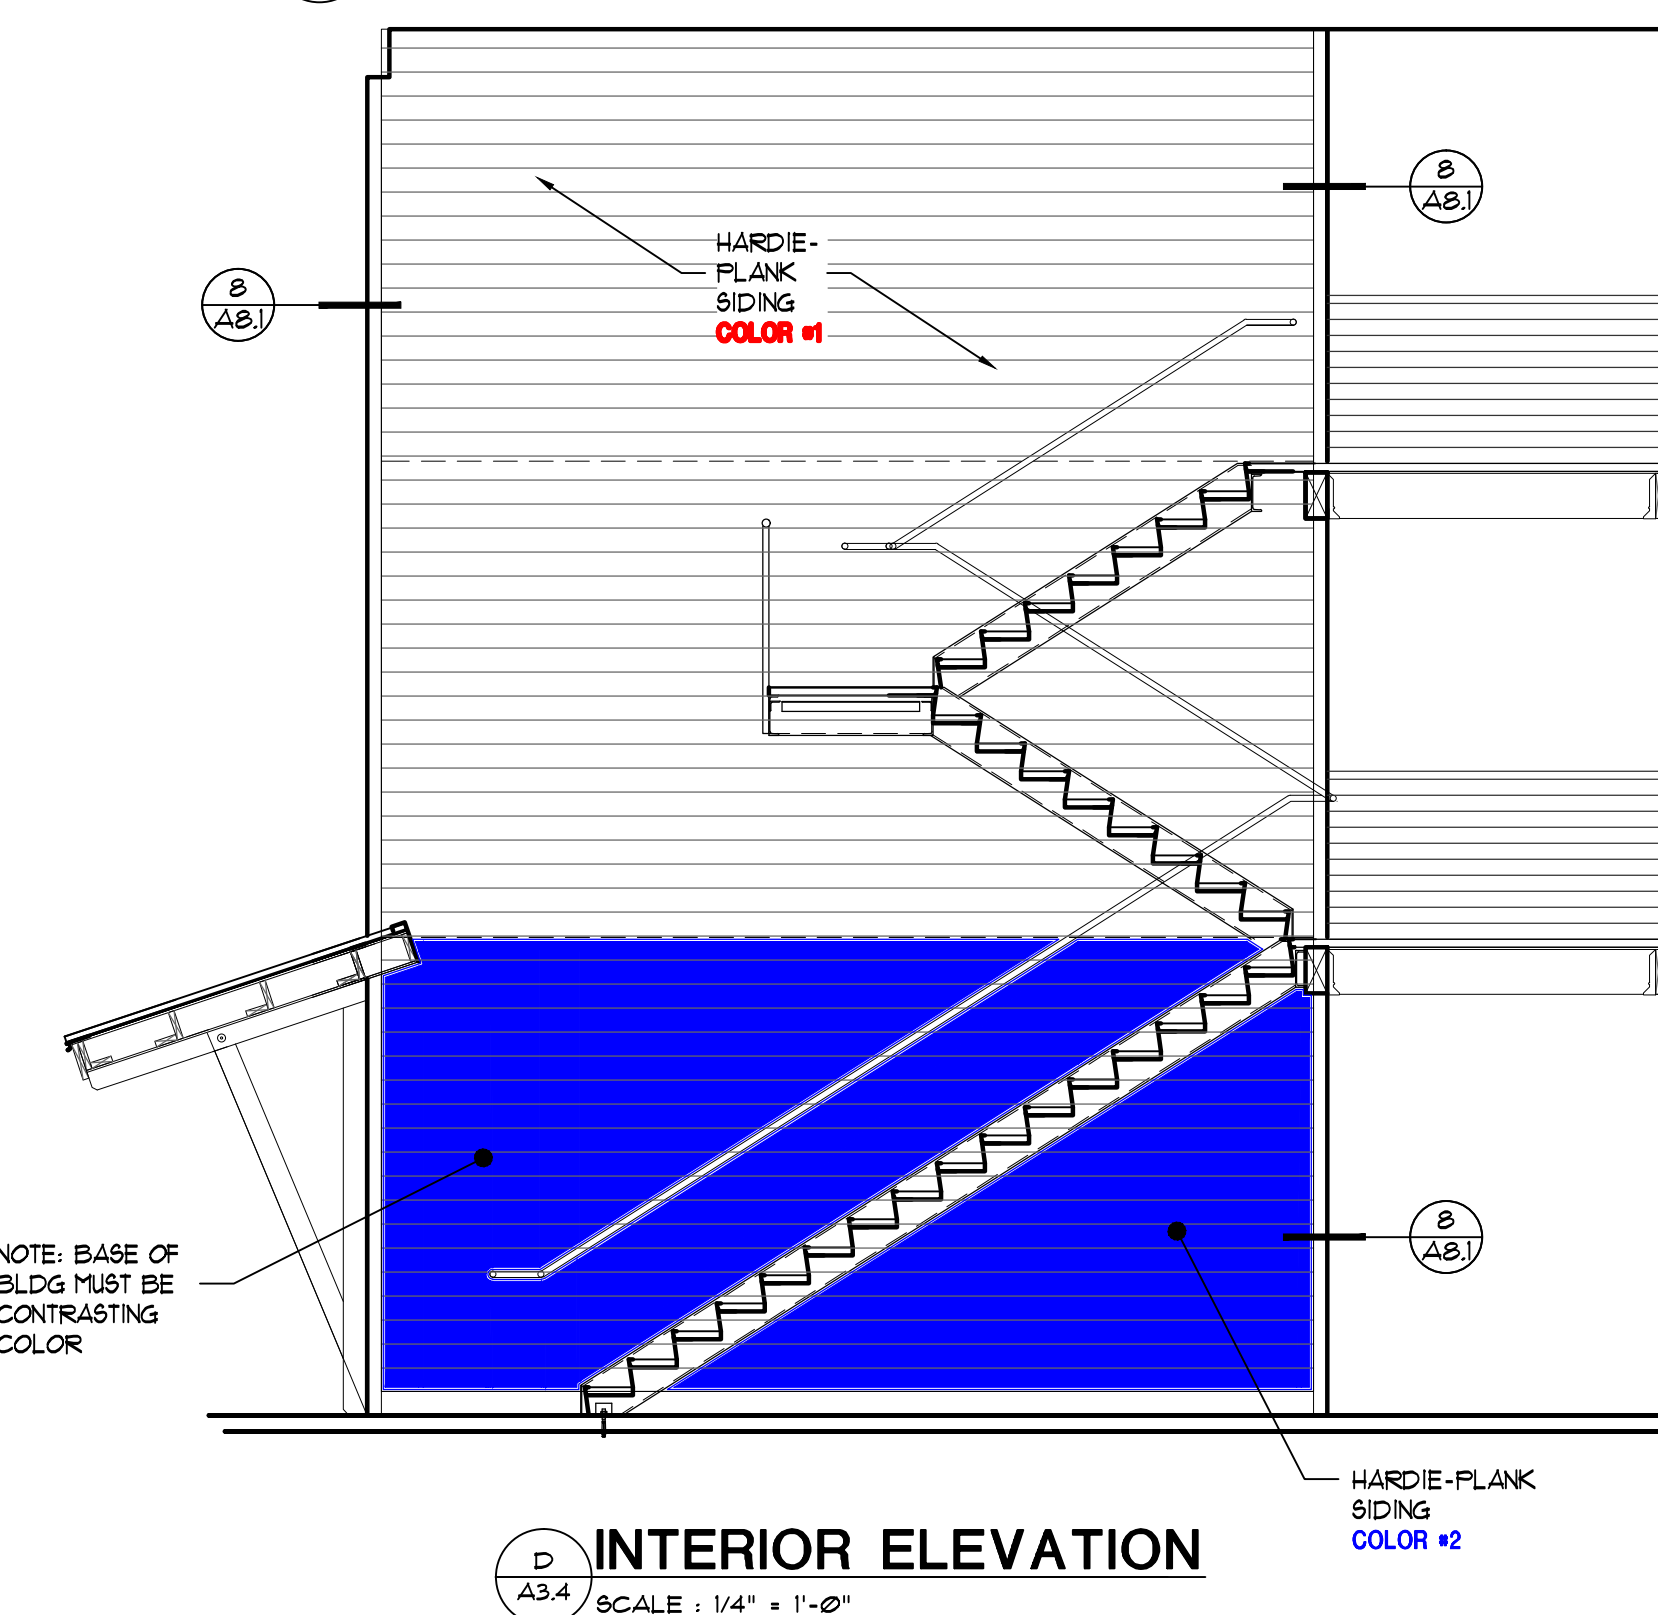
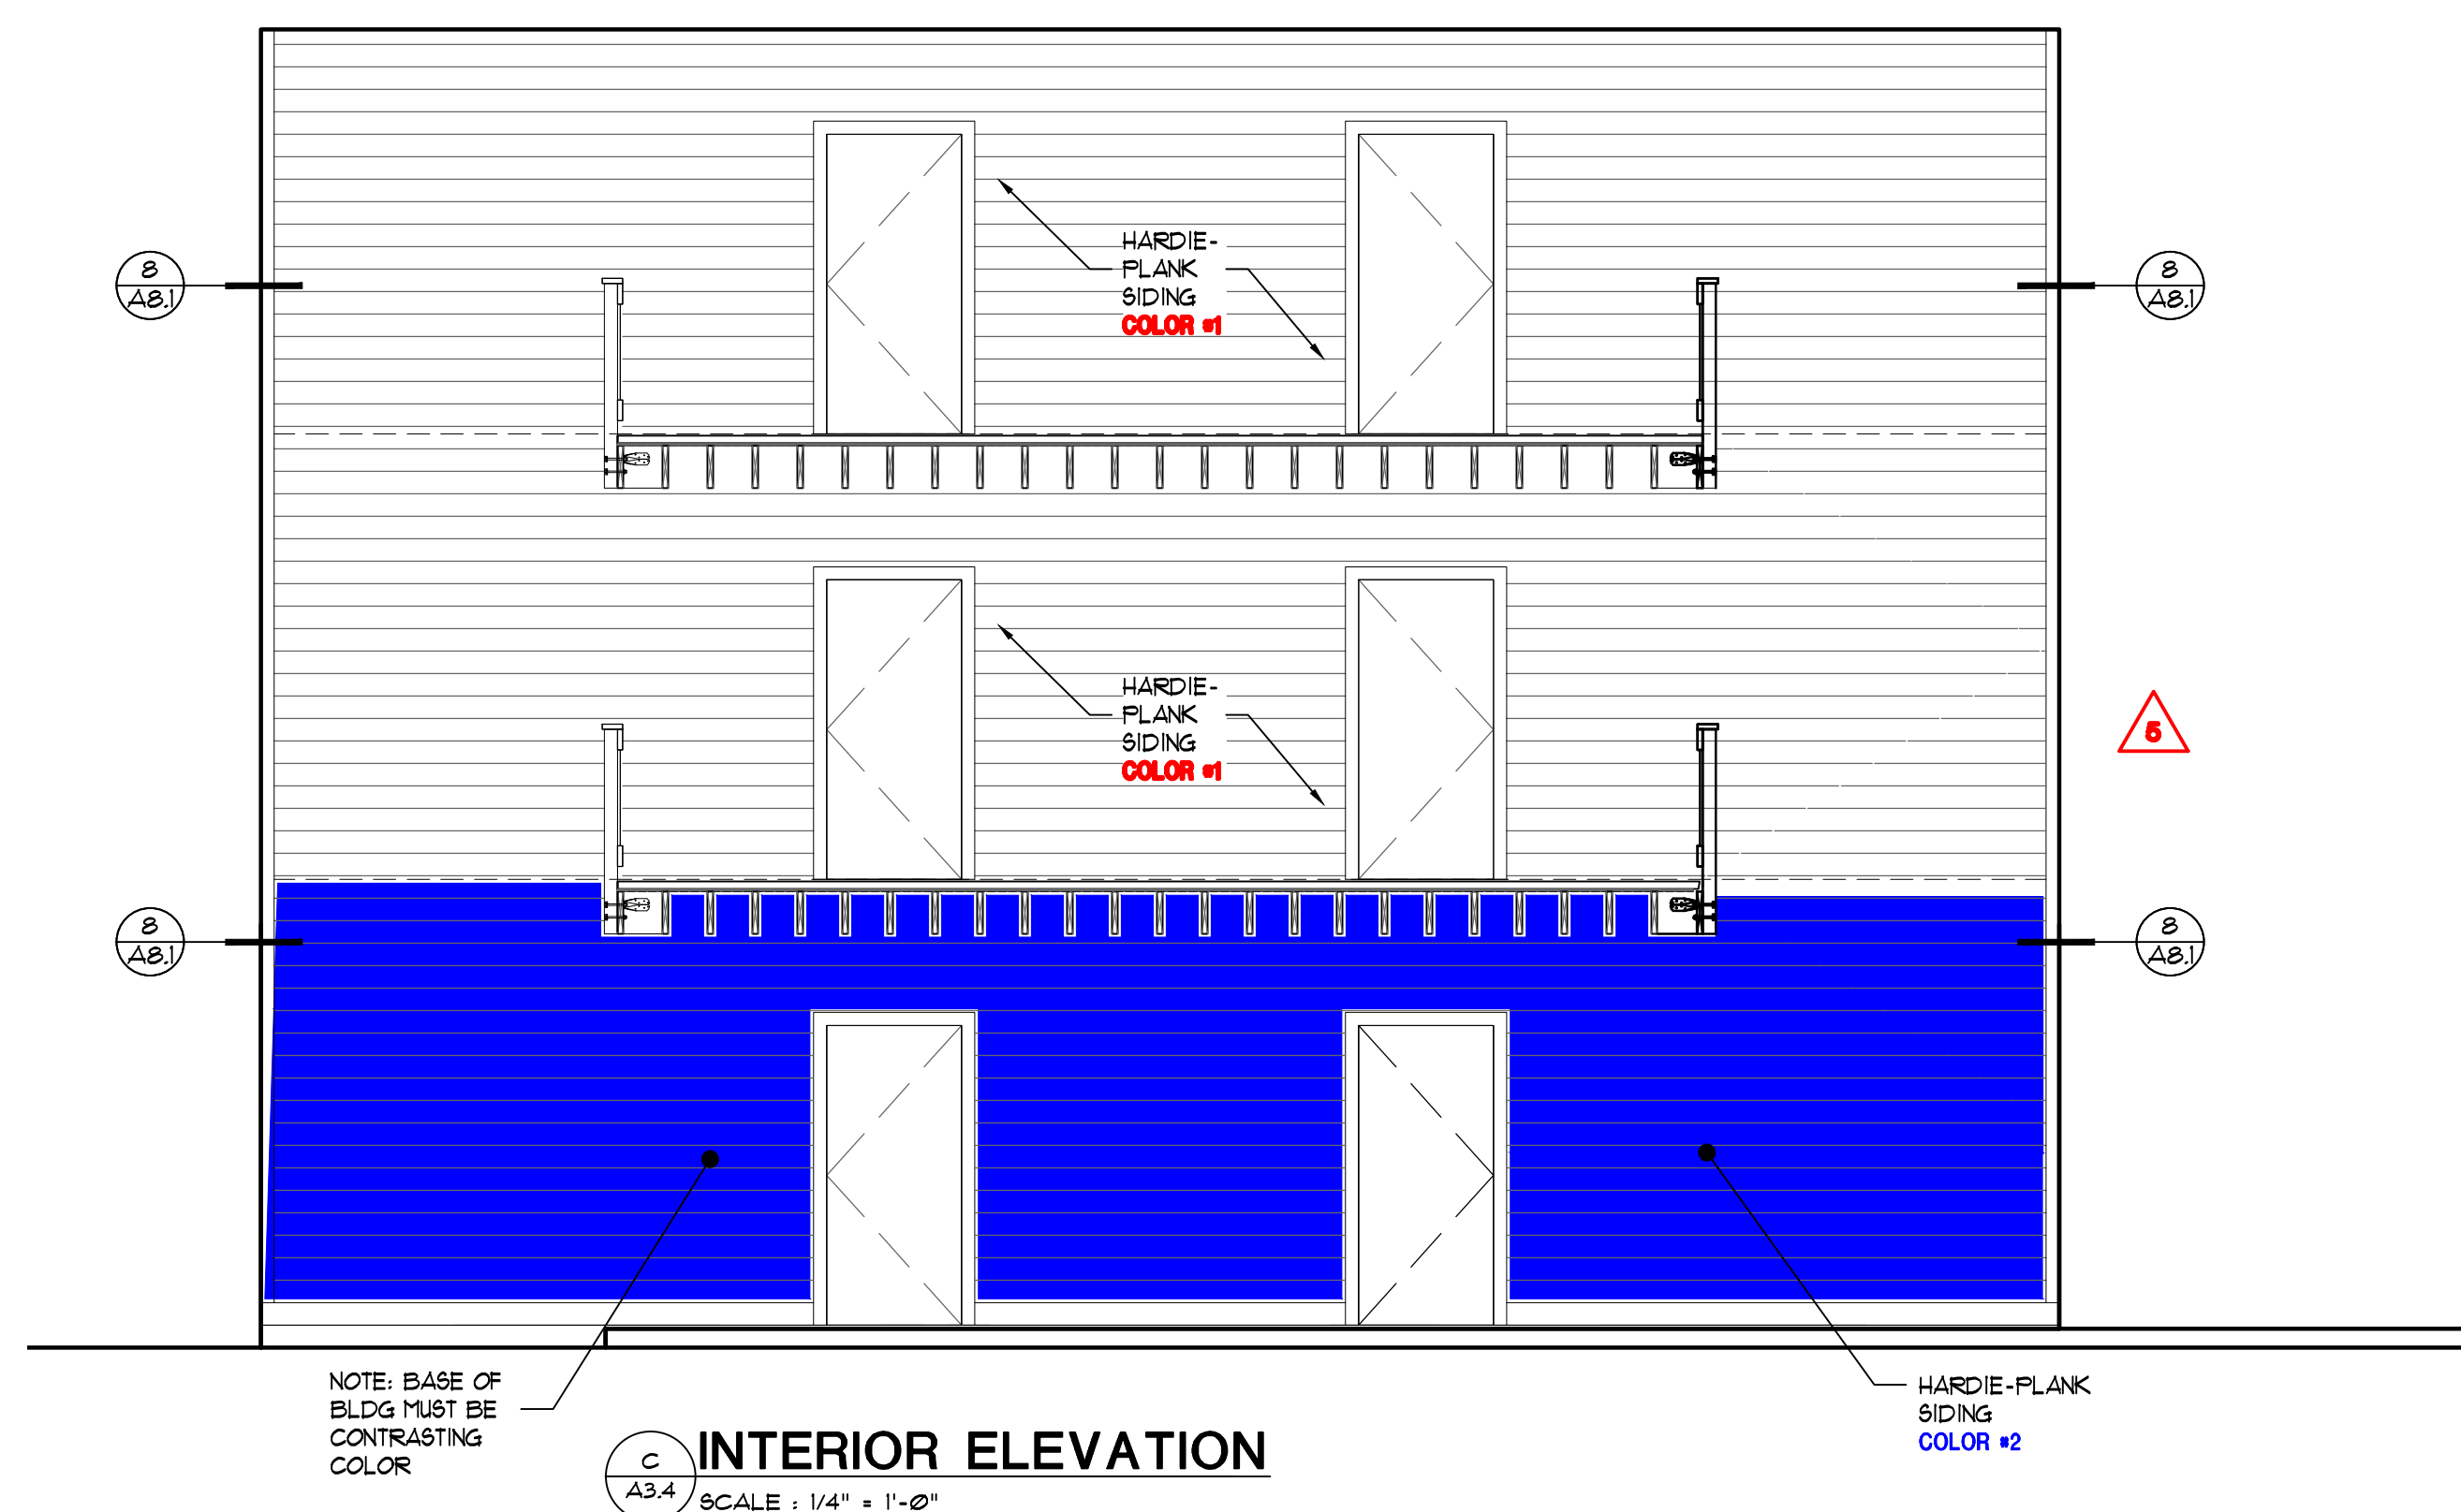
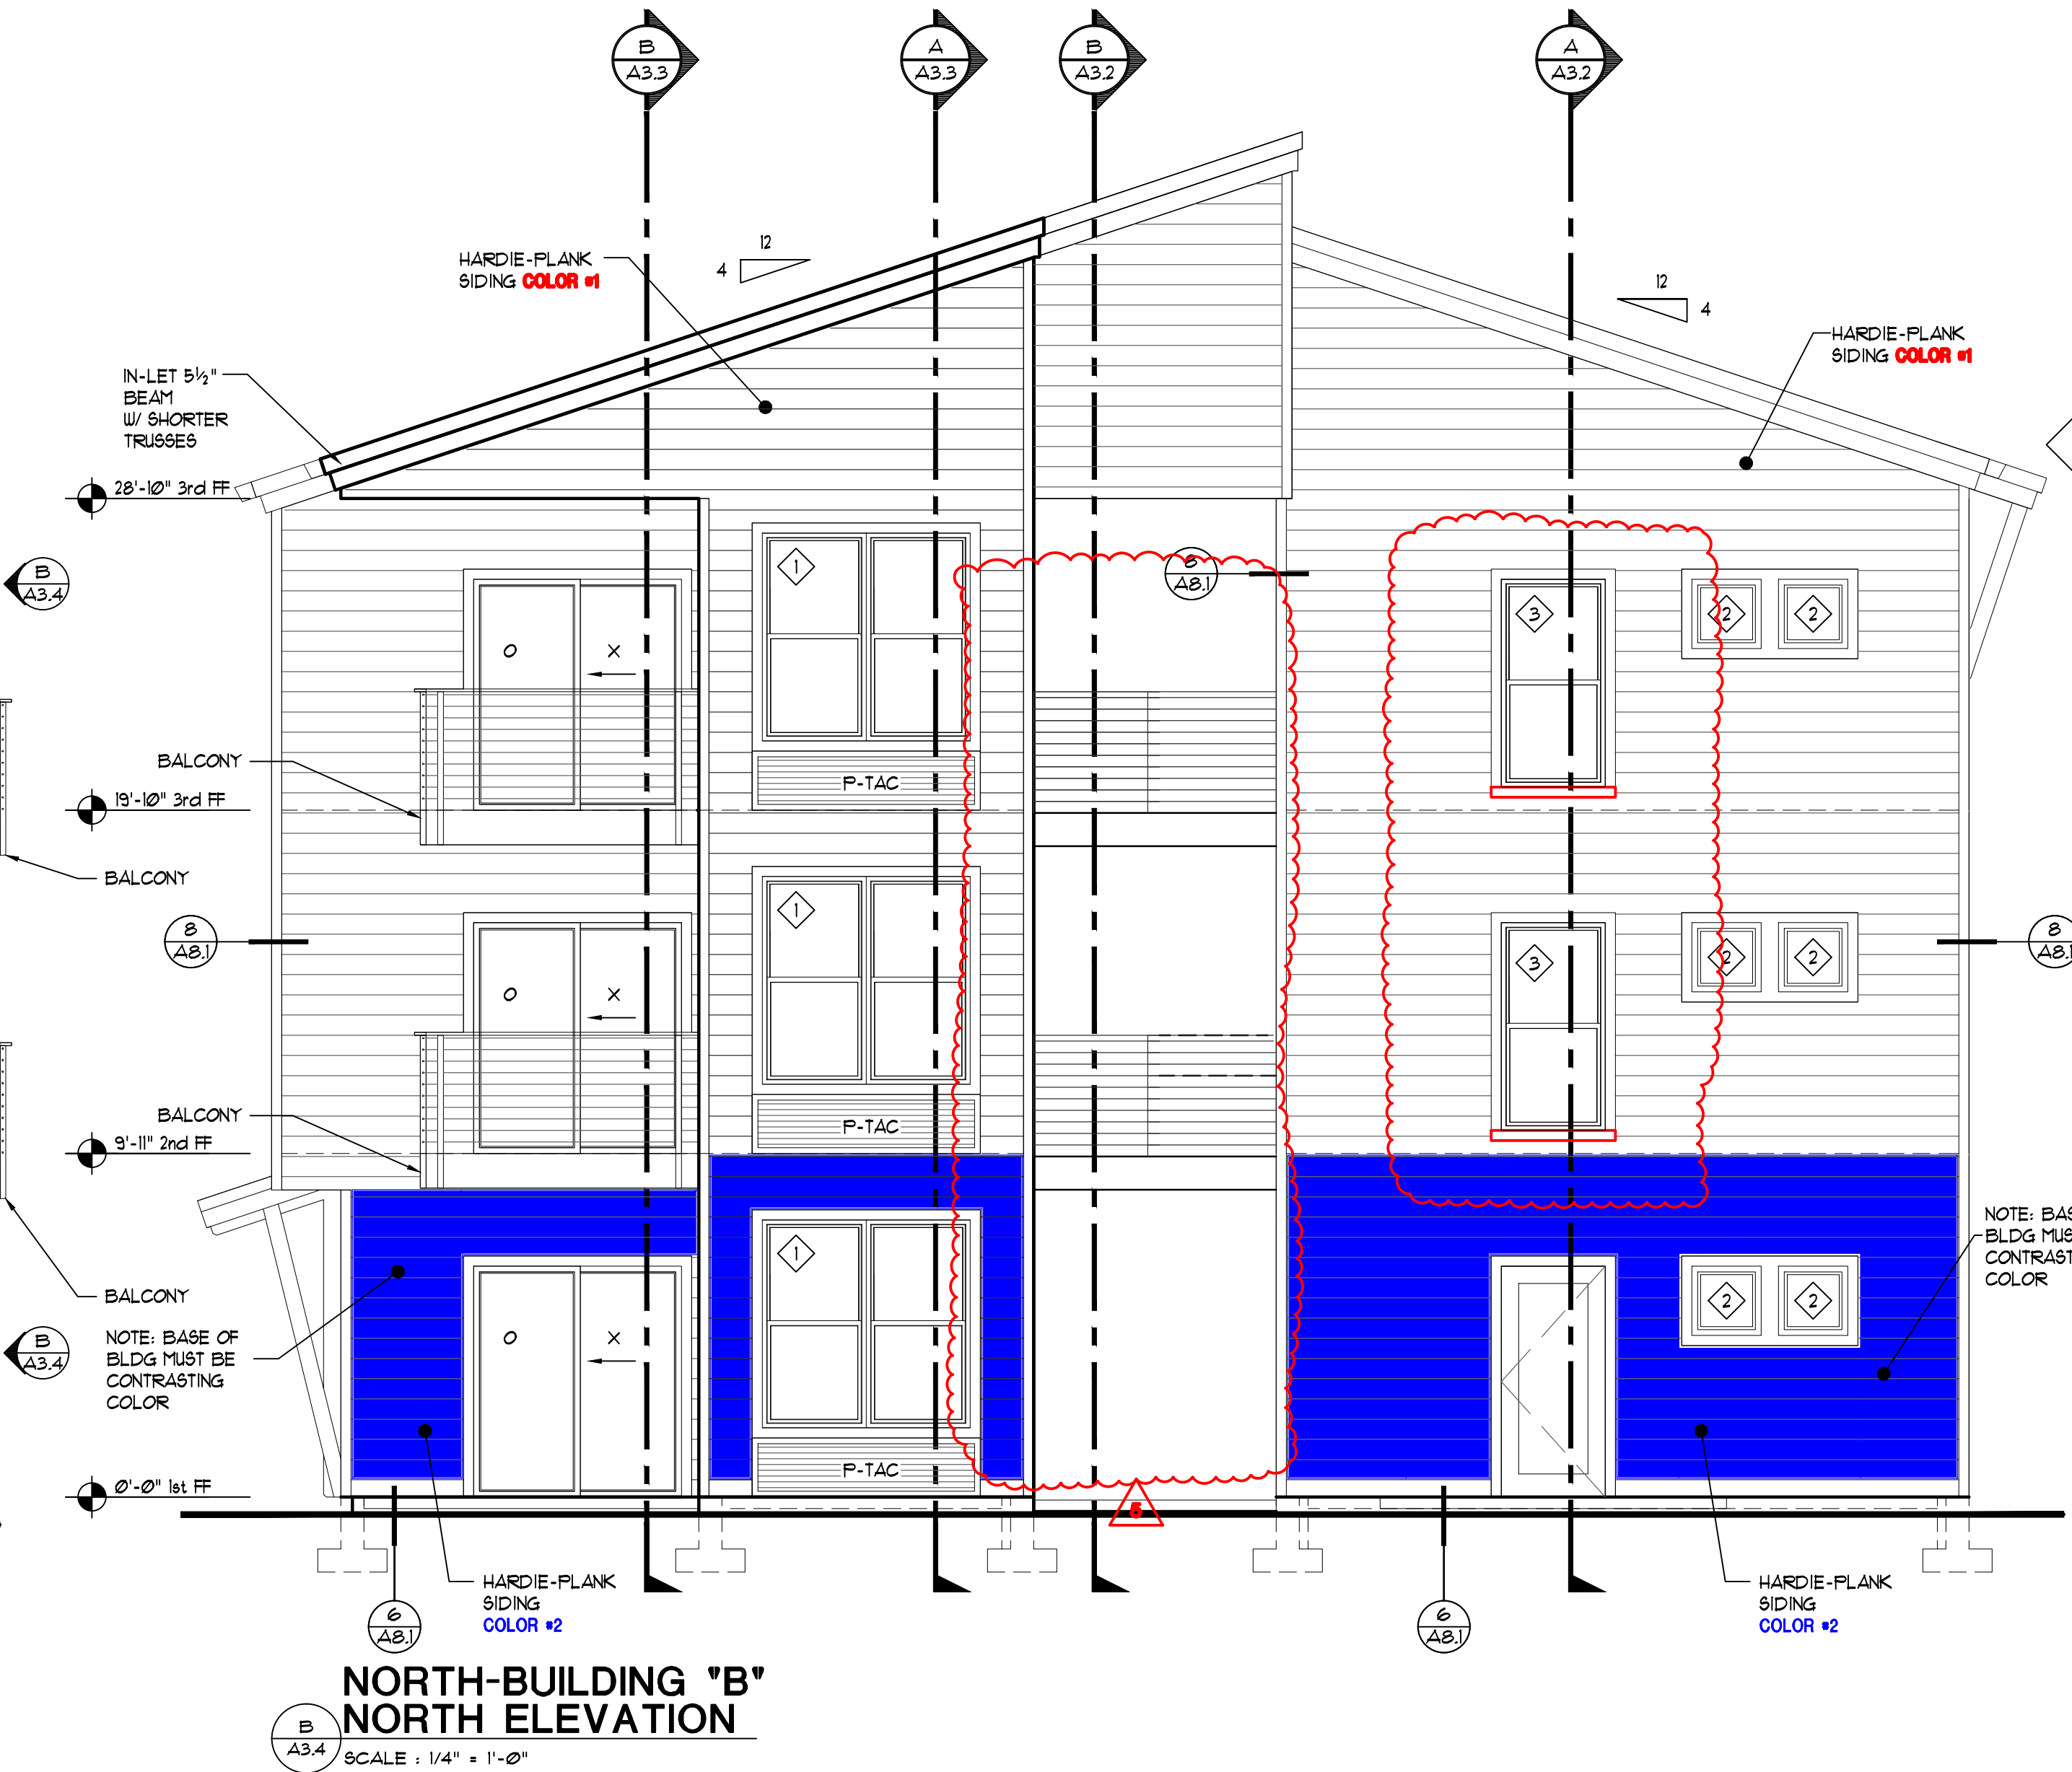


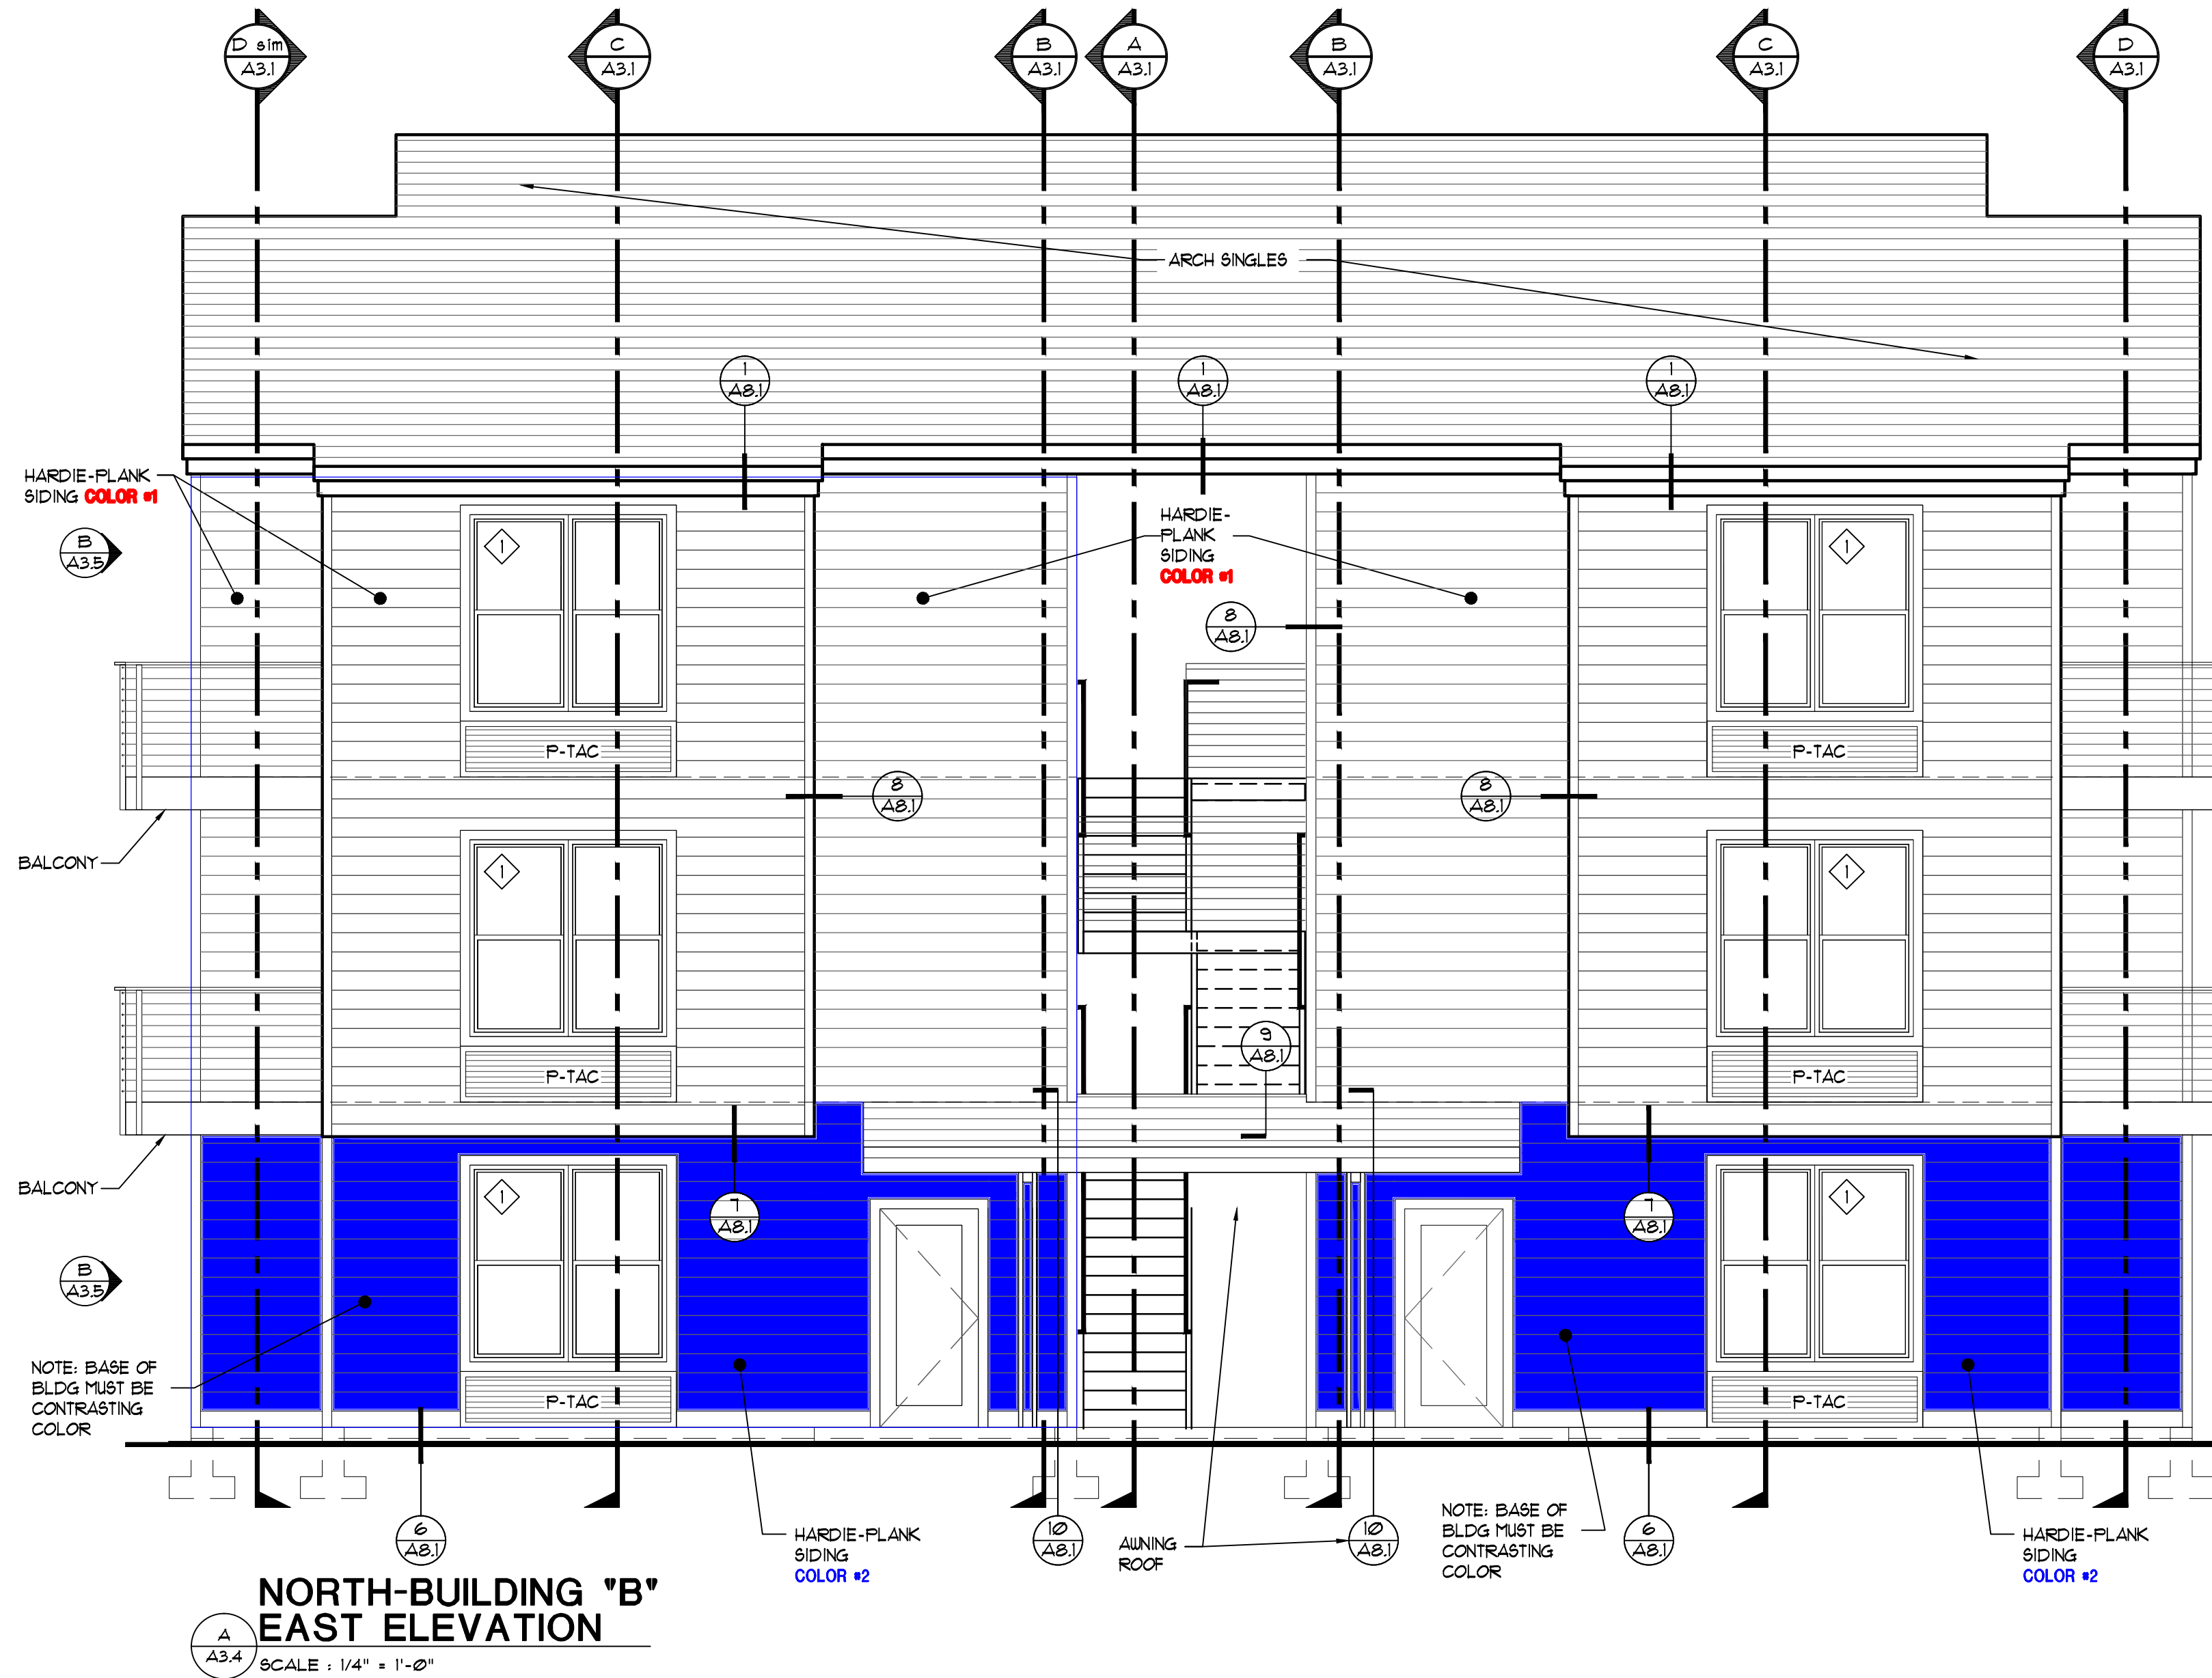

- 1 13 MAR 2023 6PM COMMENTS
- 2 5 FEB 2024 CITY OF SALEM COMMENTS
- 3 5 FEB 2024 REVIEW COMMENTS
- 4 28 MAR 2024 CITY OF SALEM COMMENTS
- 5 14 JUNE 2024 EGRESS STAIR CHANGE
- 6 5 JULY 2024 CHANGE OFFICE TO STUDIO APT & REMOVAL OF STUDIO BALCONIES

NEW APARTMENTS FOR:
Waller St SE
1349 Waller St Salem, Or

DATE: 20 APRIL 2022
DRAWN: 2207

A3.4

1 CONSTRUCTION SET 04.29.2024