

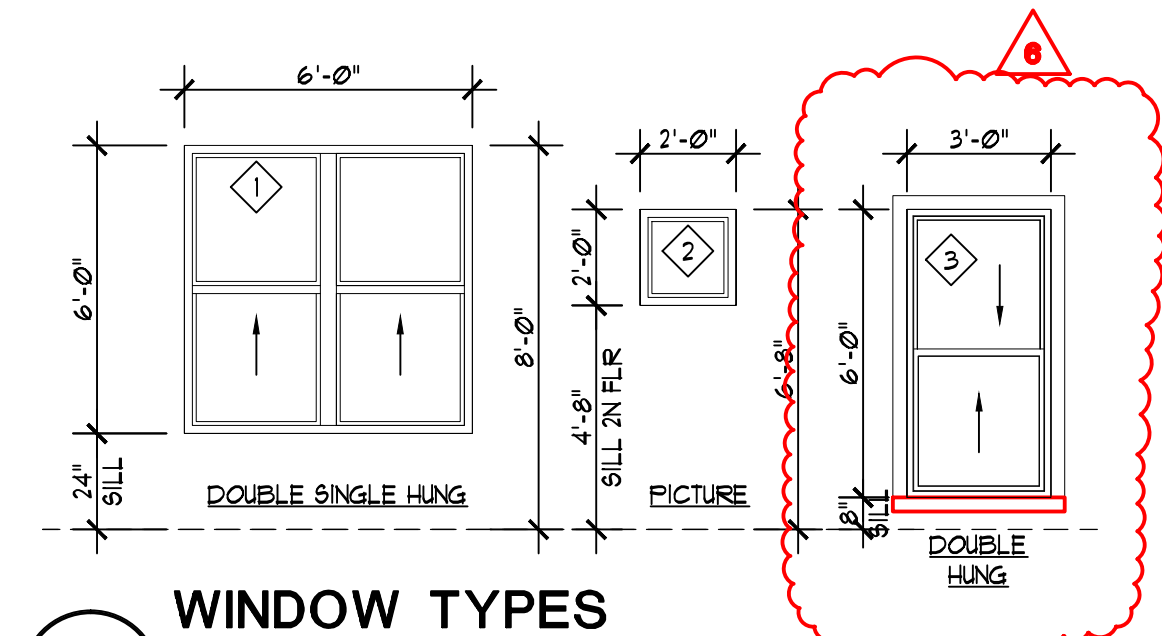
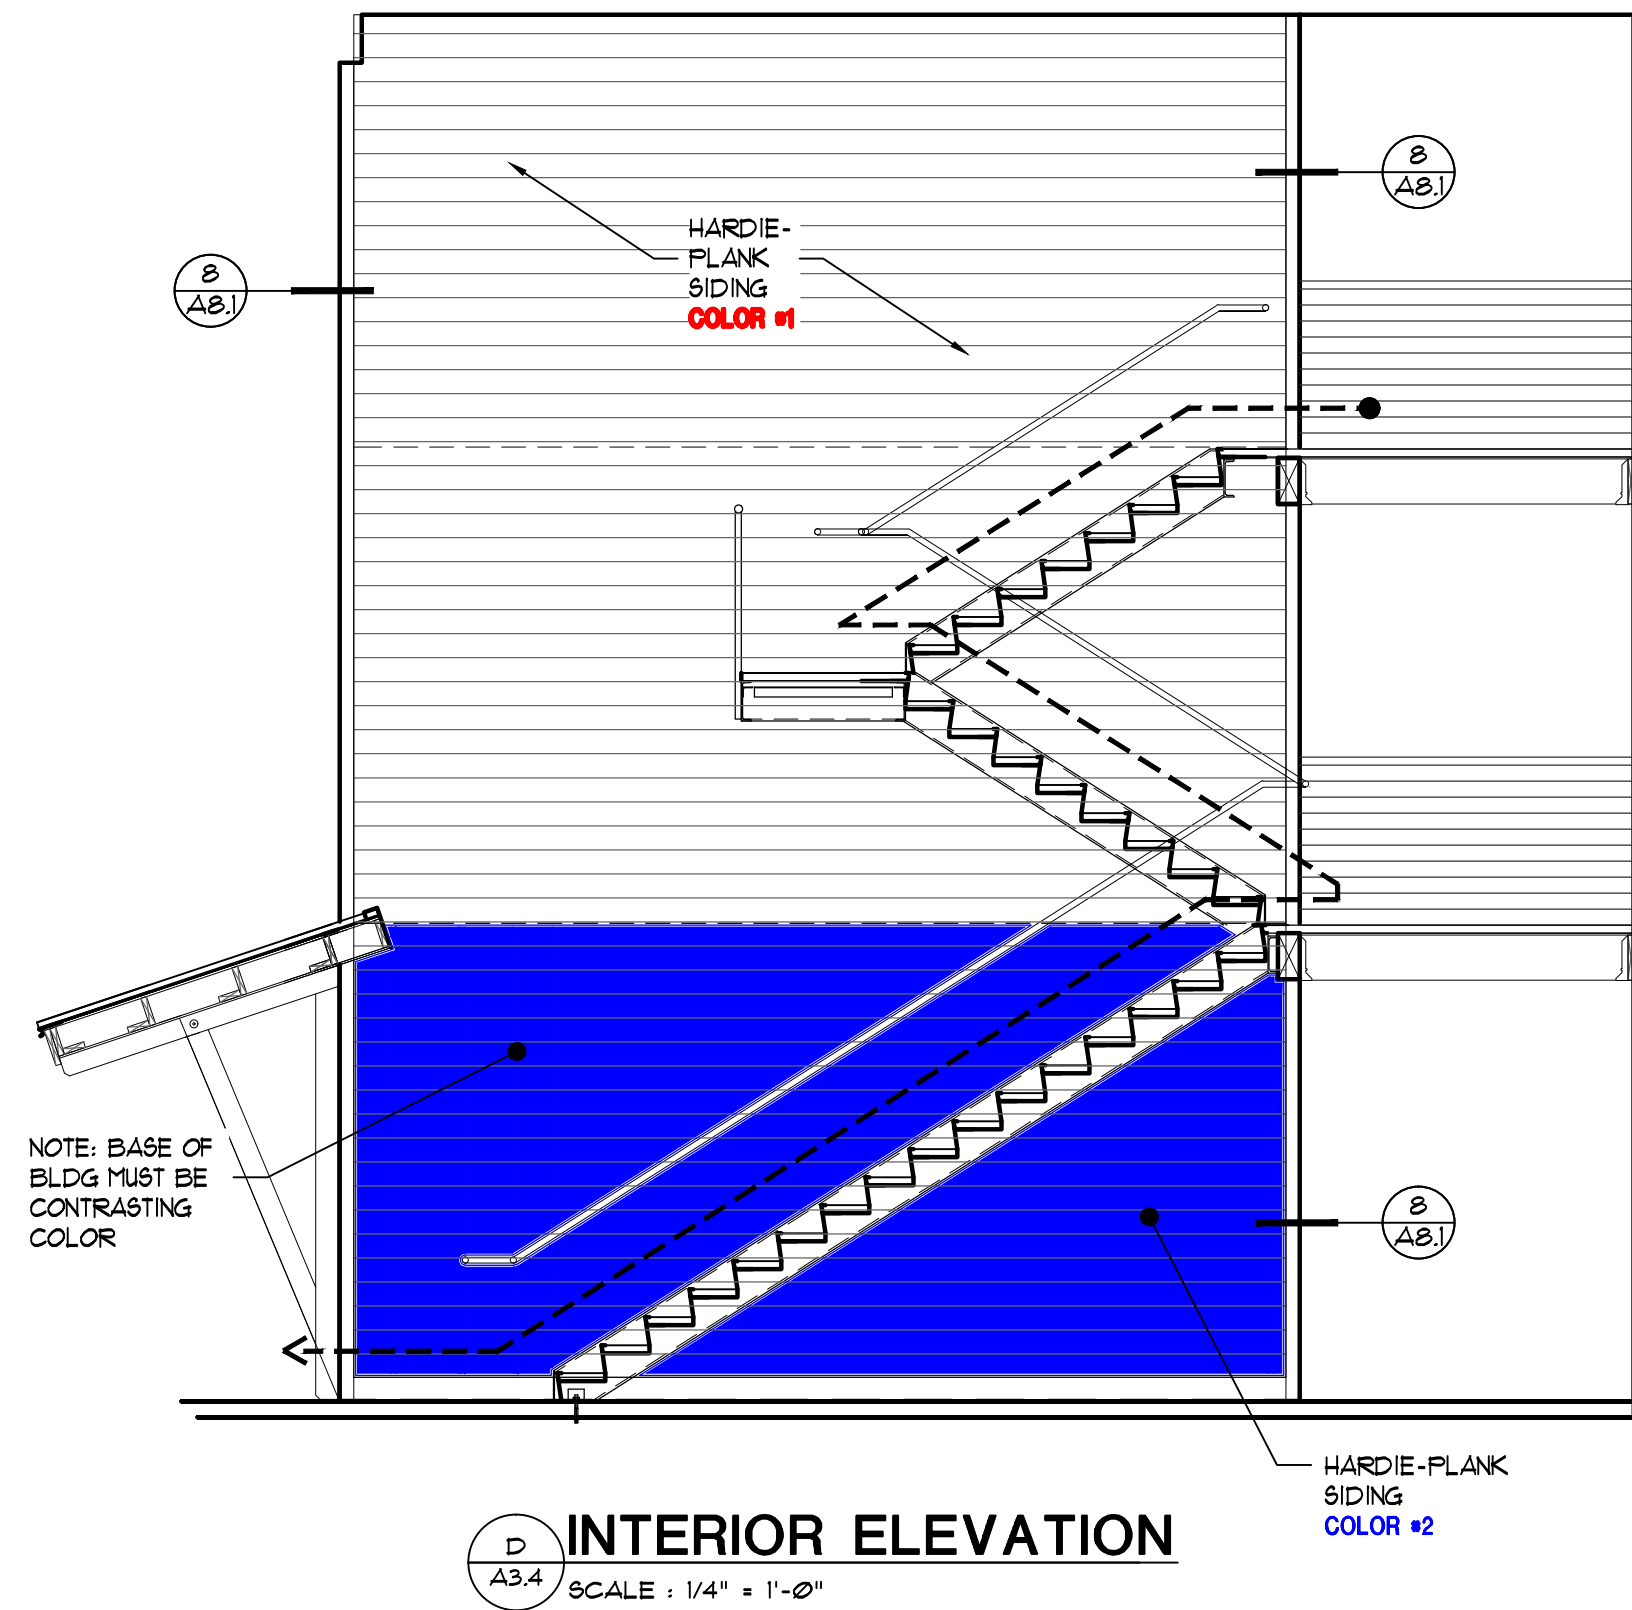
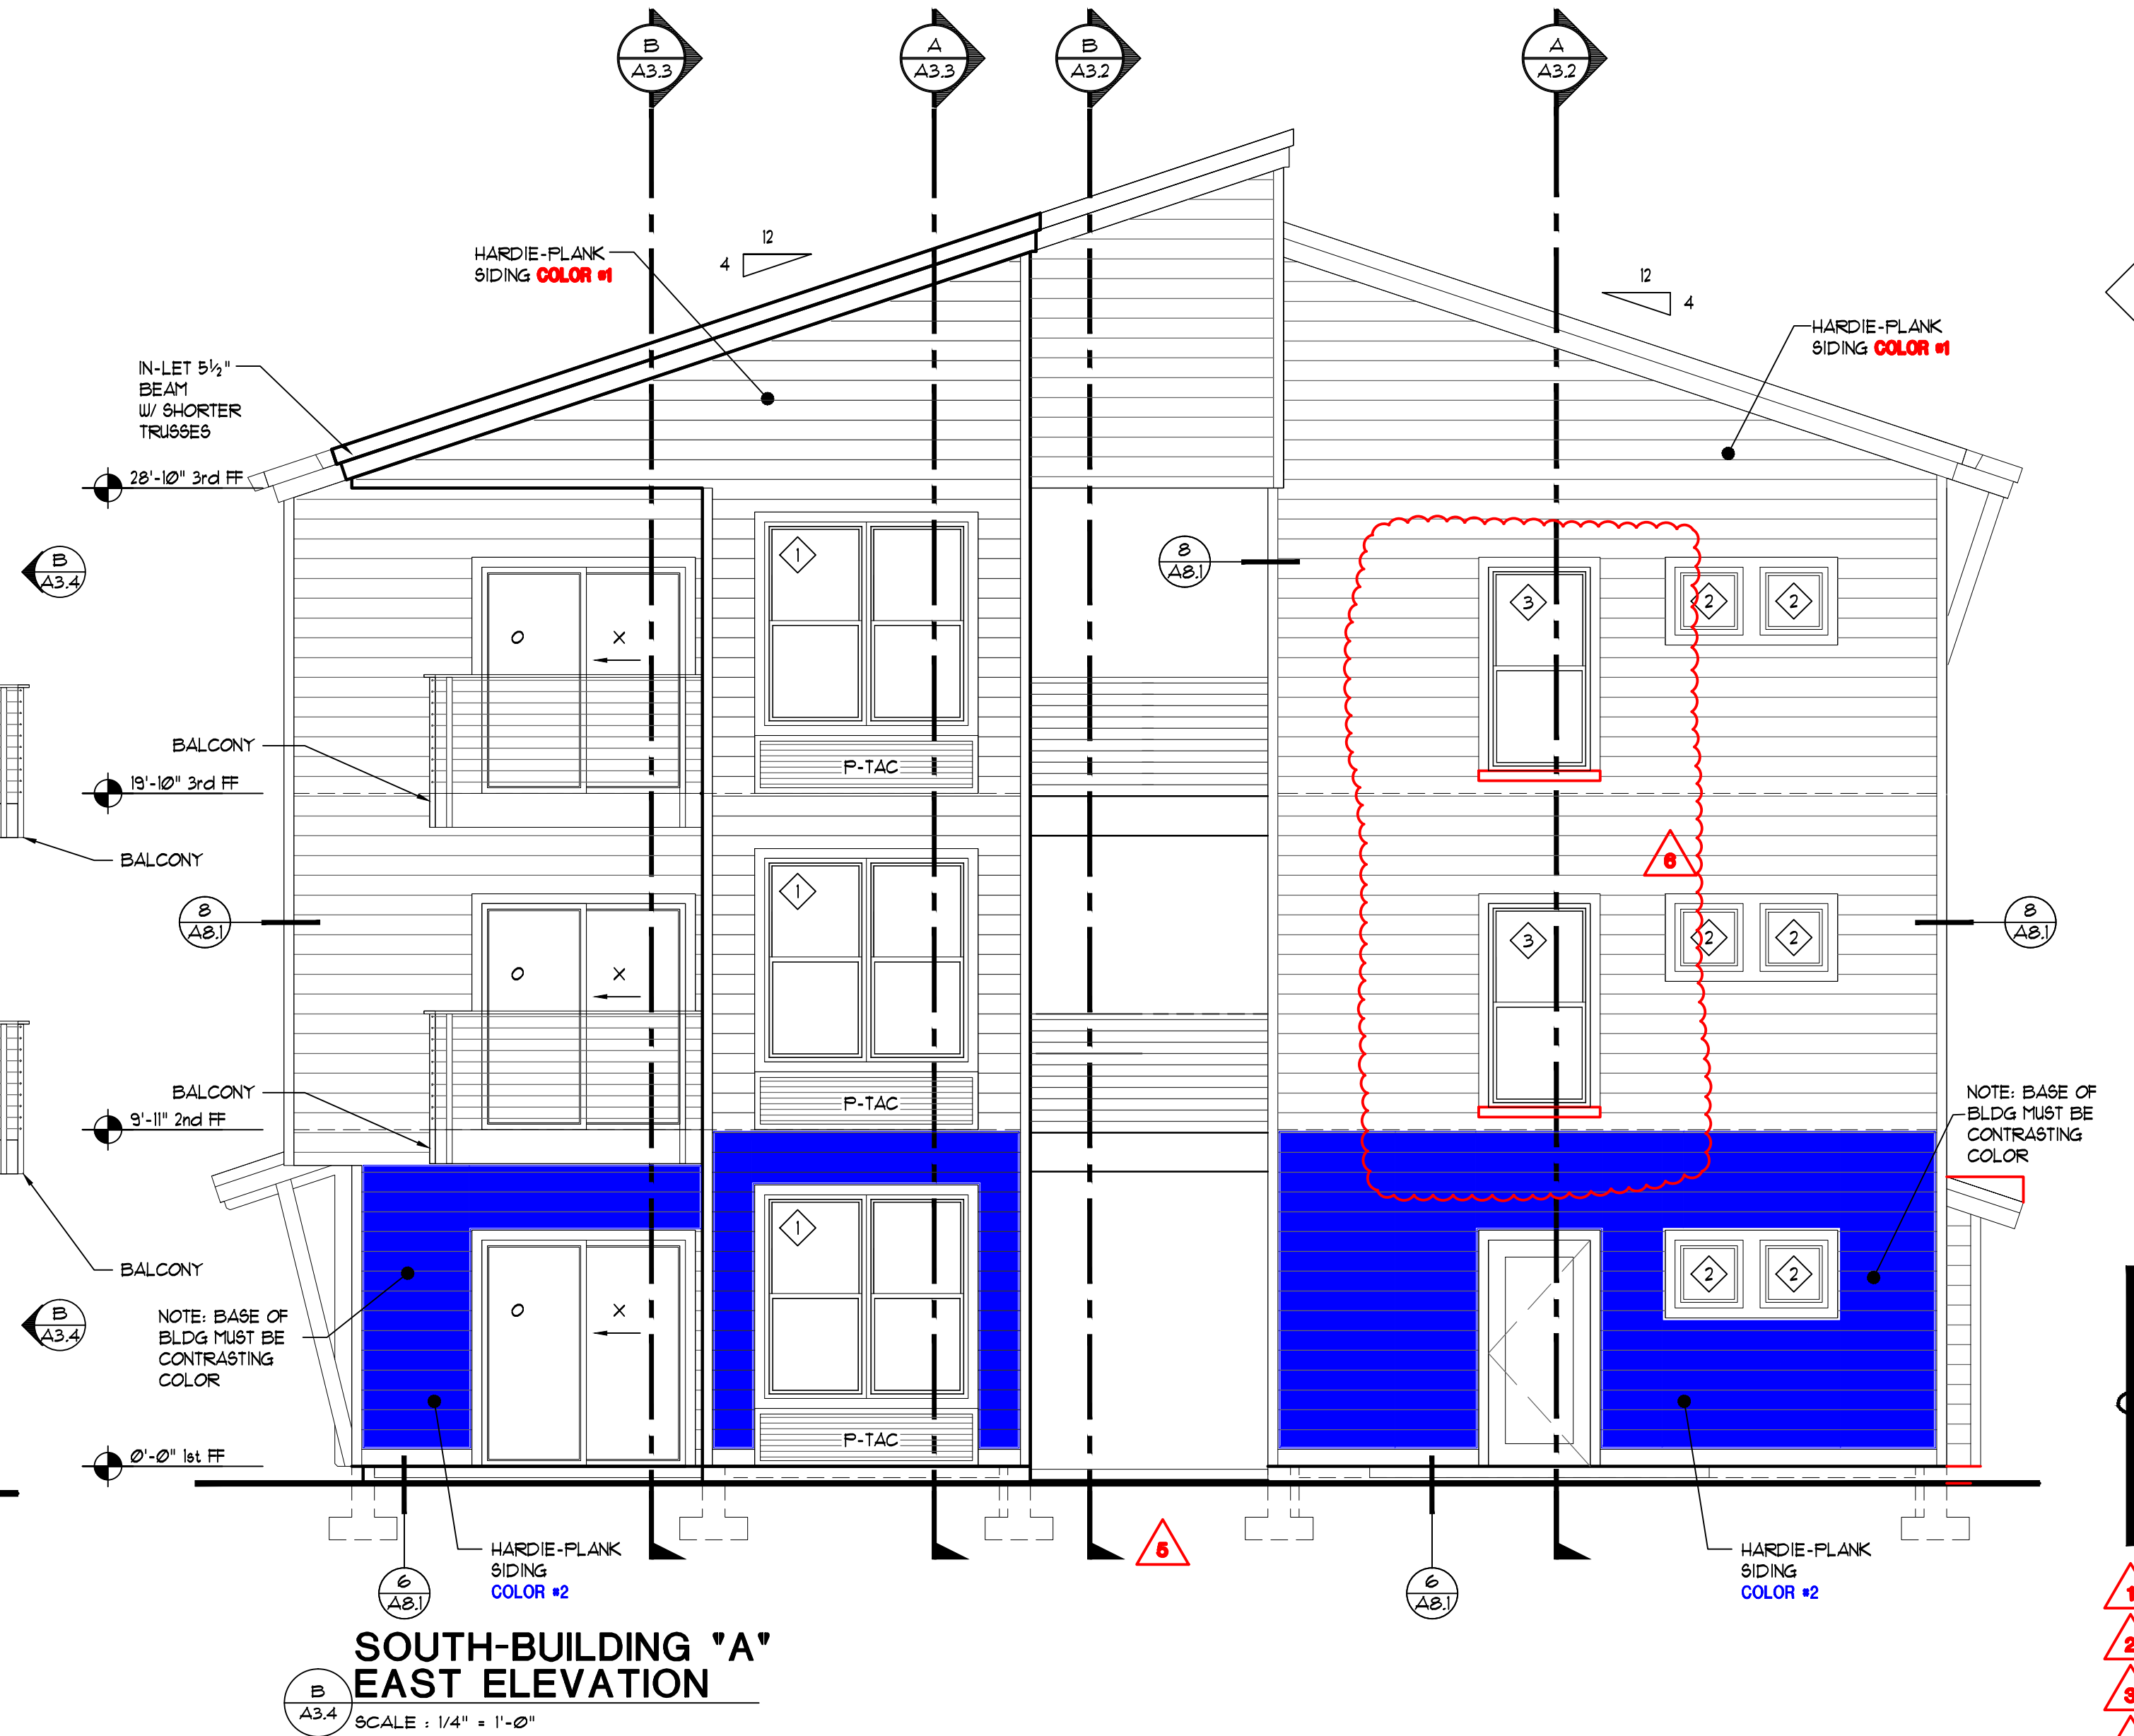


LAST SAVED: Mon, 15 Jul 2024 - 04:43 pm LOCATION: C:\Users\trevo\appdata\local\temp\AcPublish_4156\A2_1_BldgA-1341.dwg A3.4
PRINTED: Mon, 15 Jul 2024 - 04:51 pm PRINTED BY: trevo

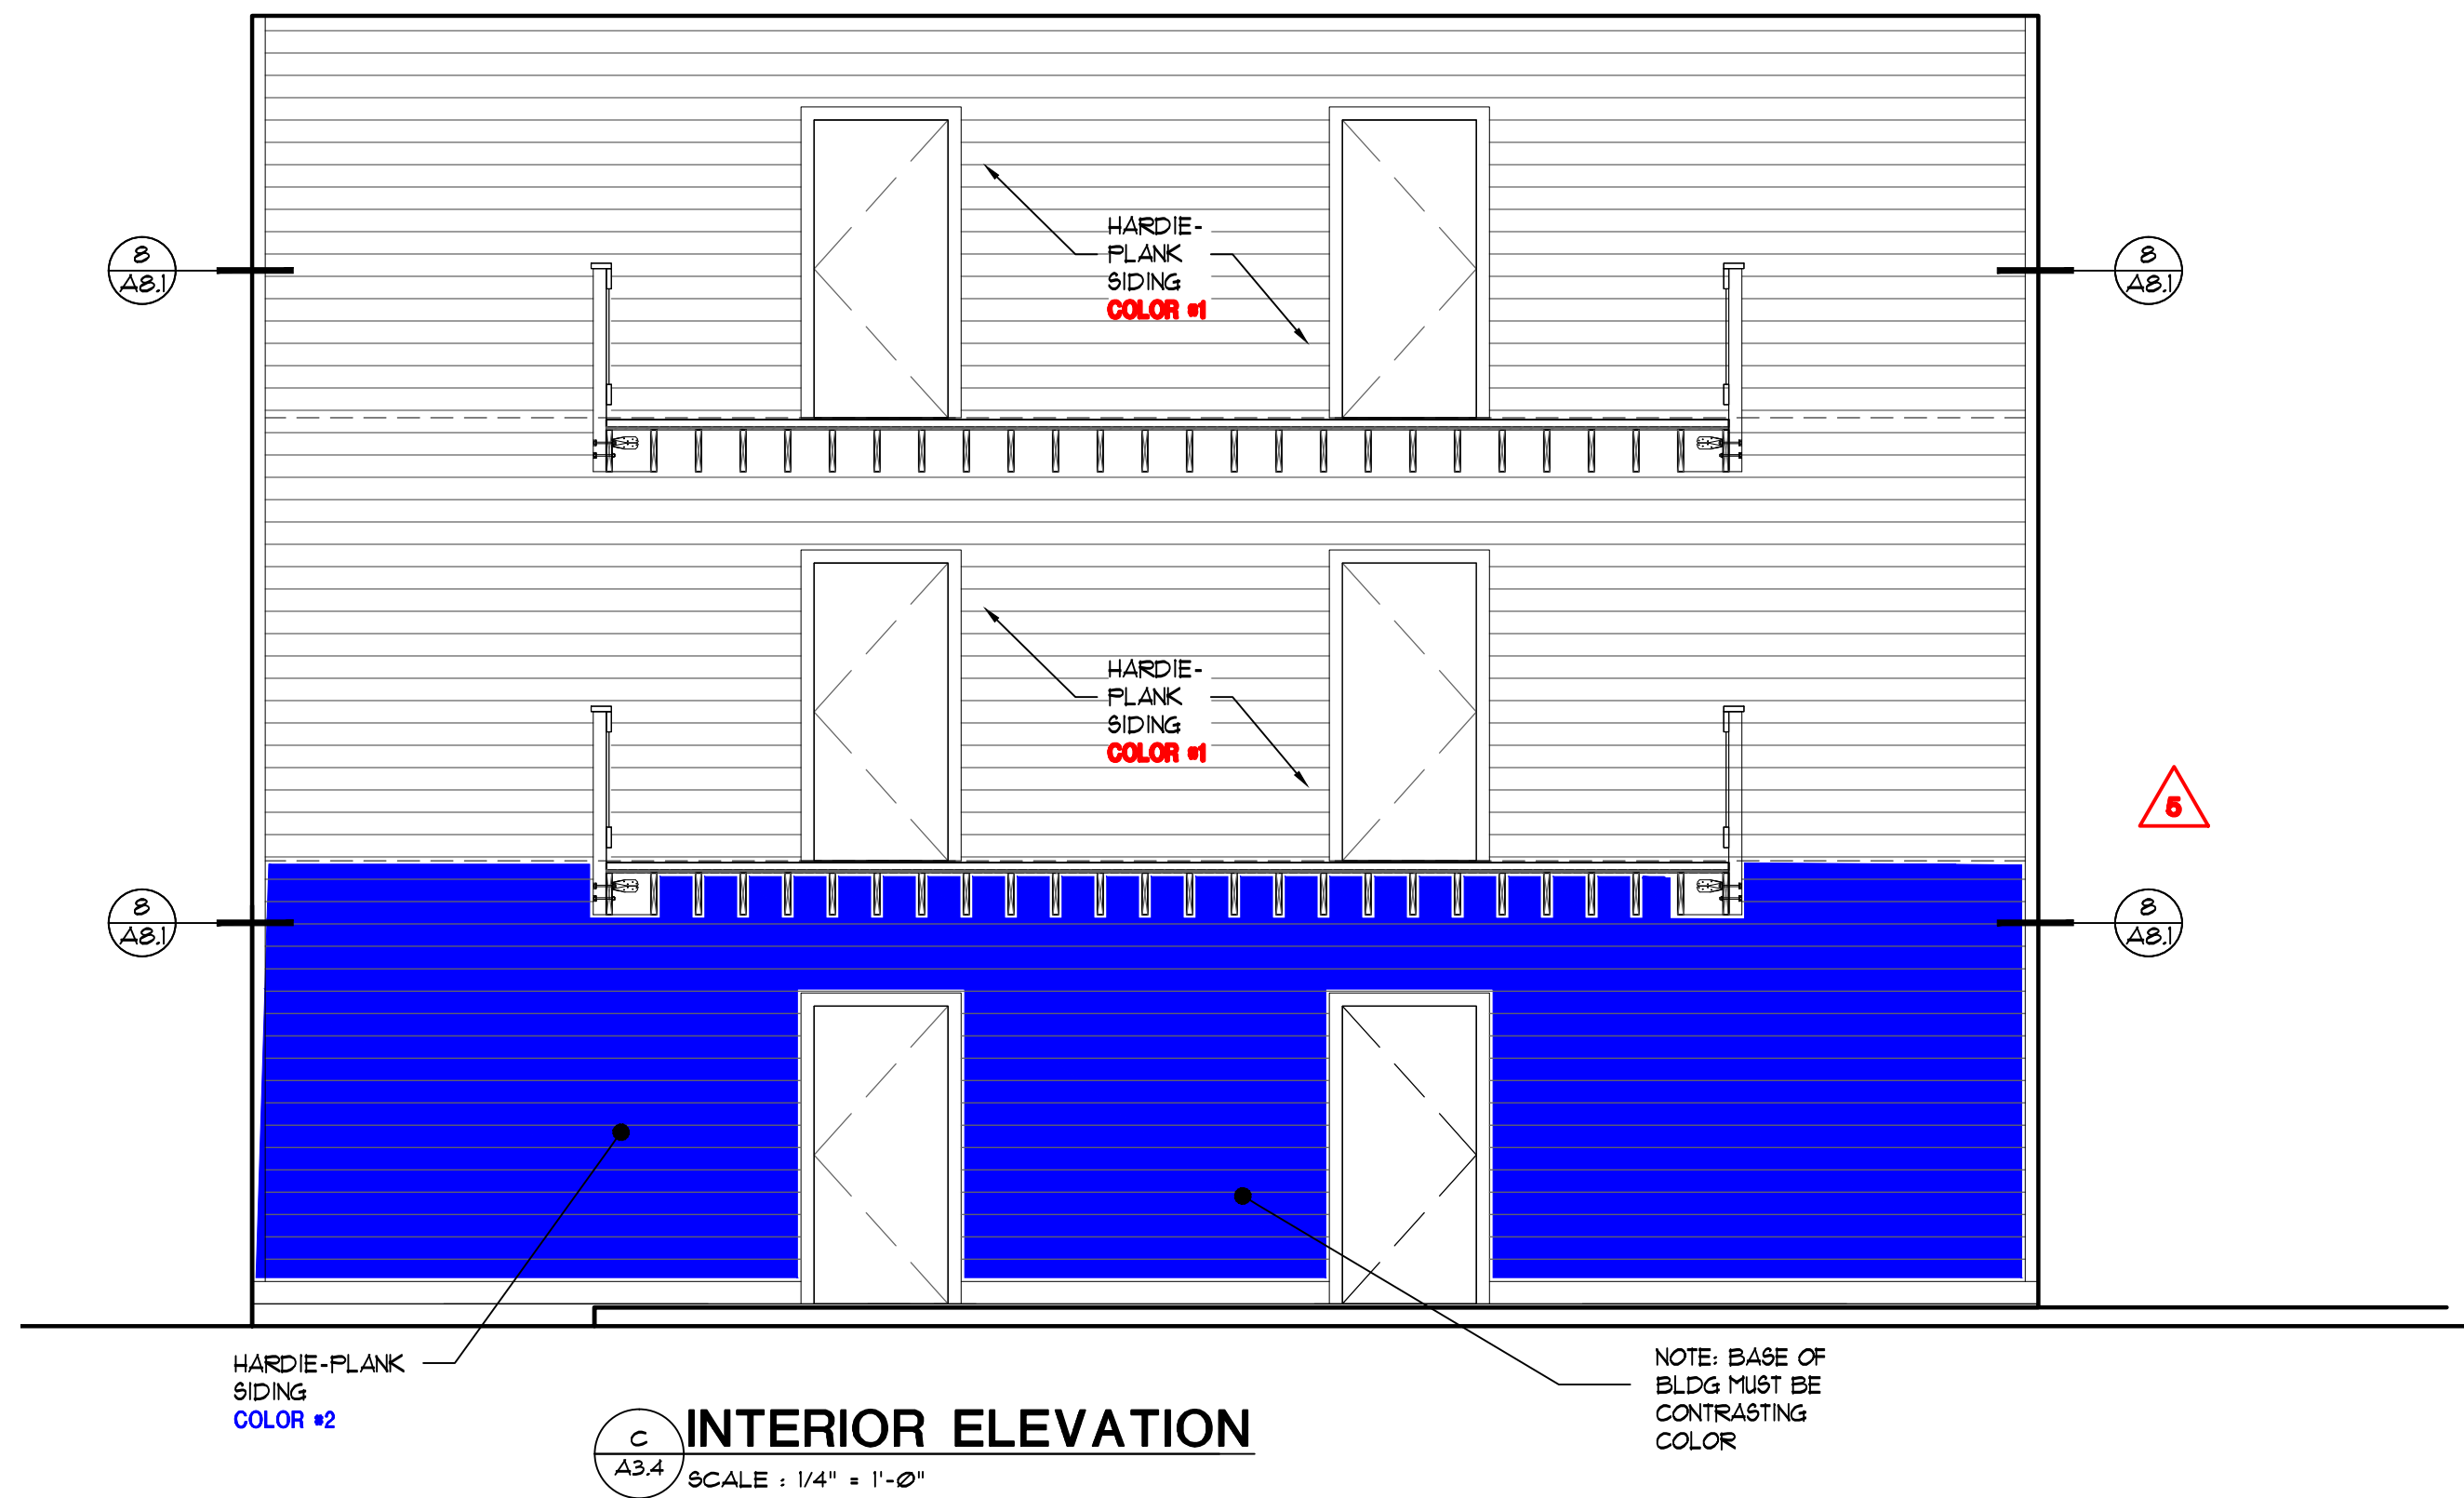

CONSTRUCTION SET 04.29.2024

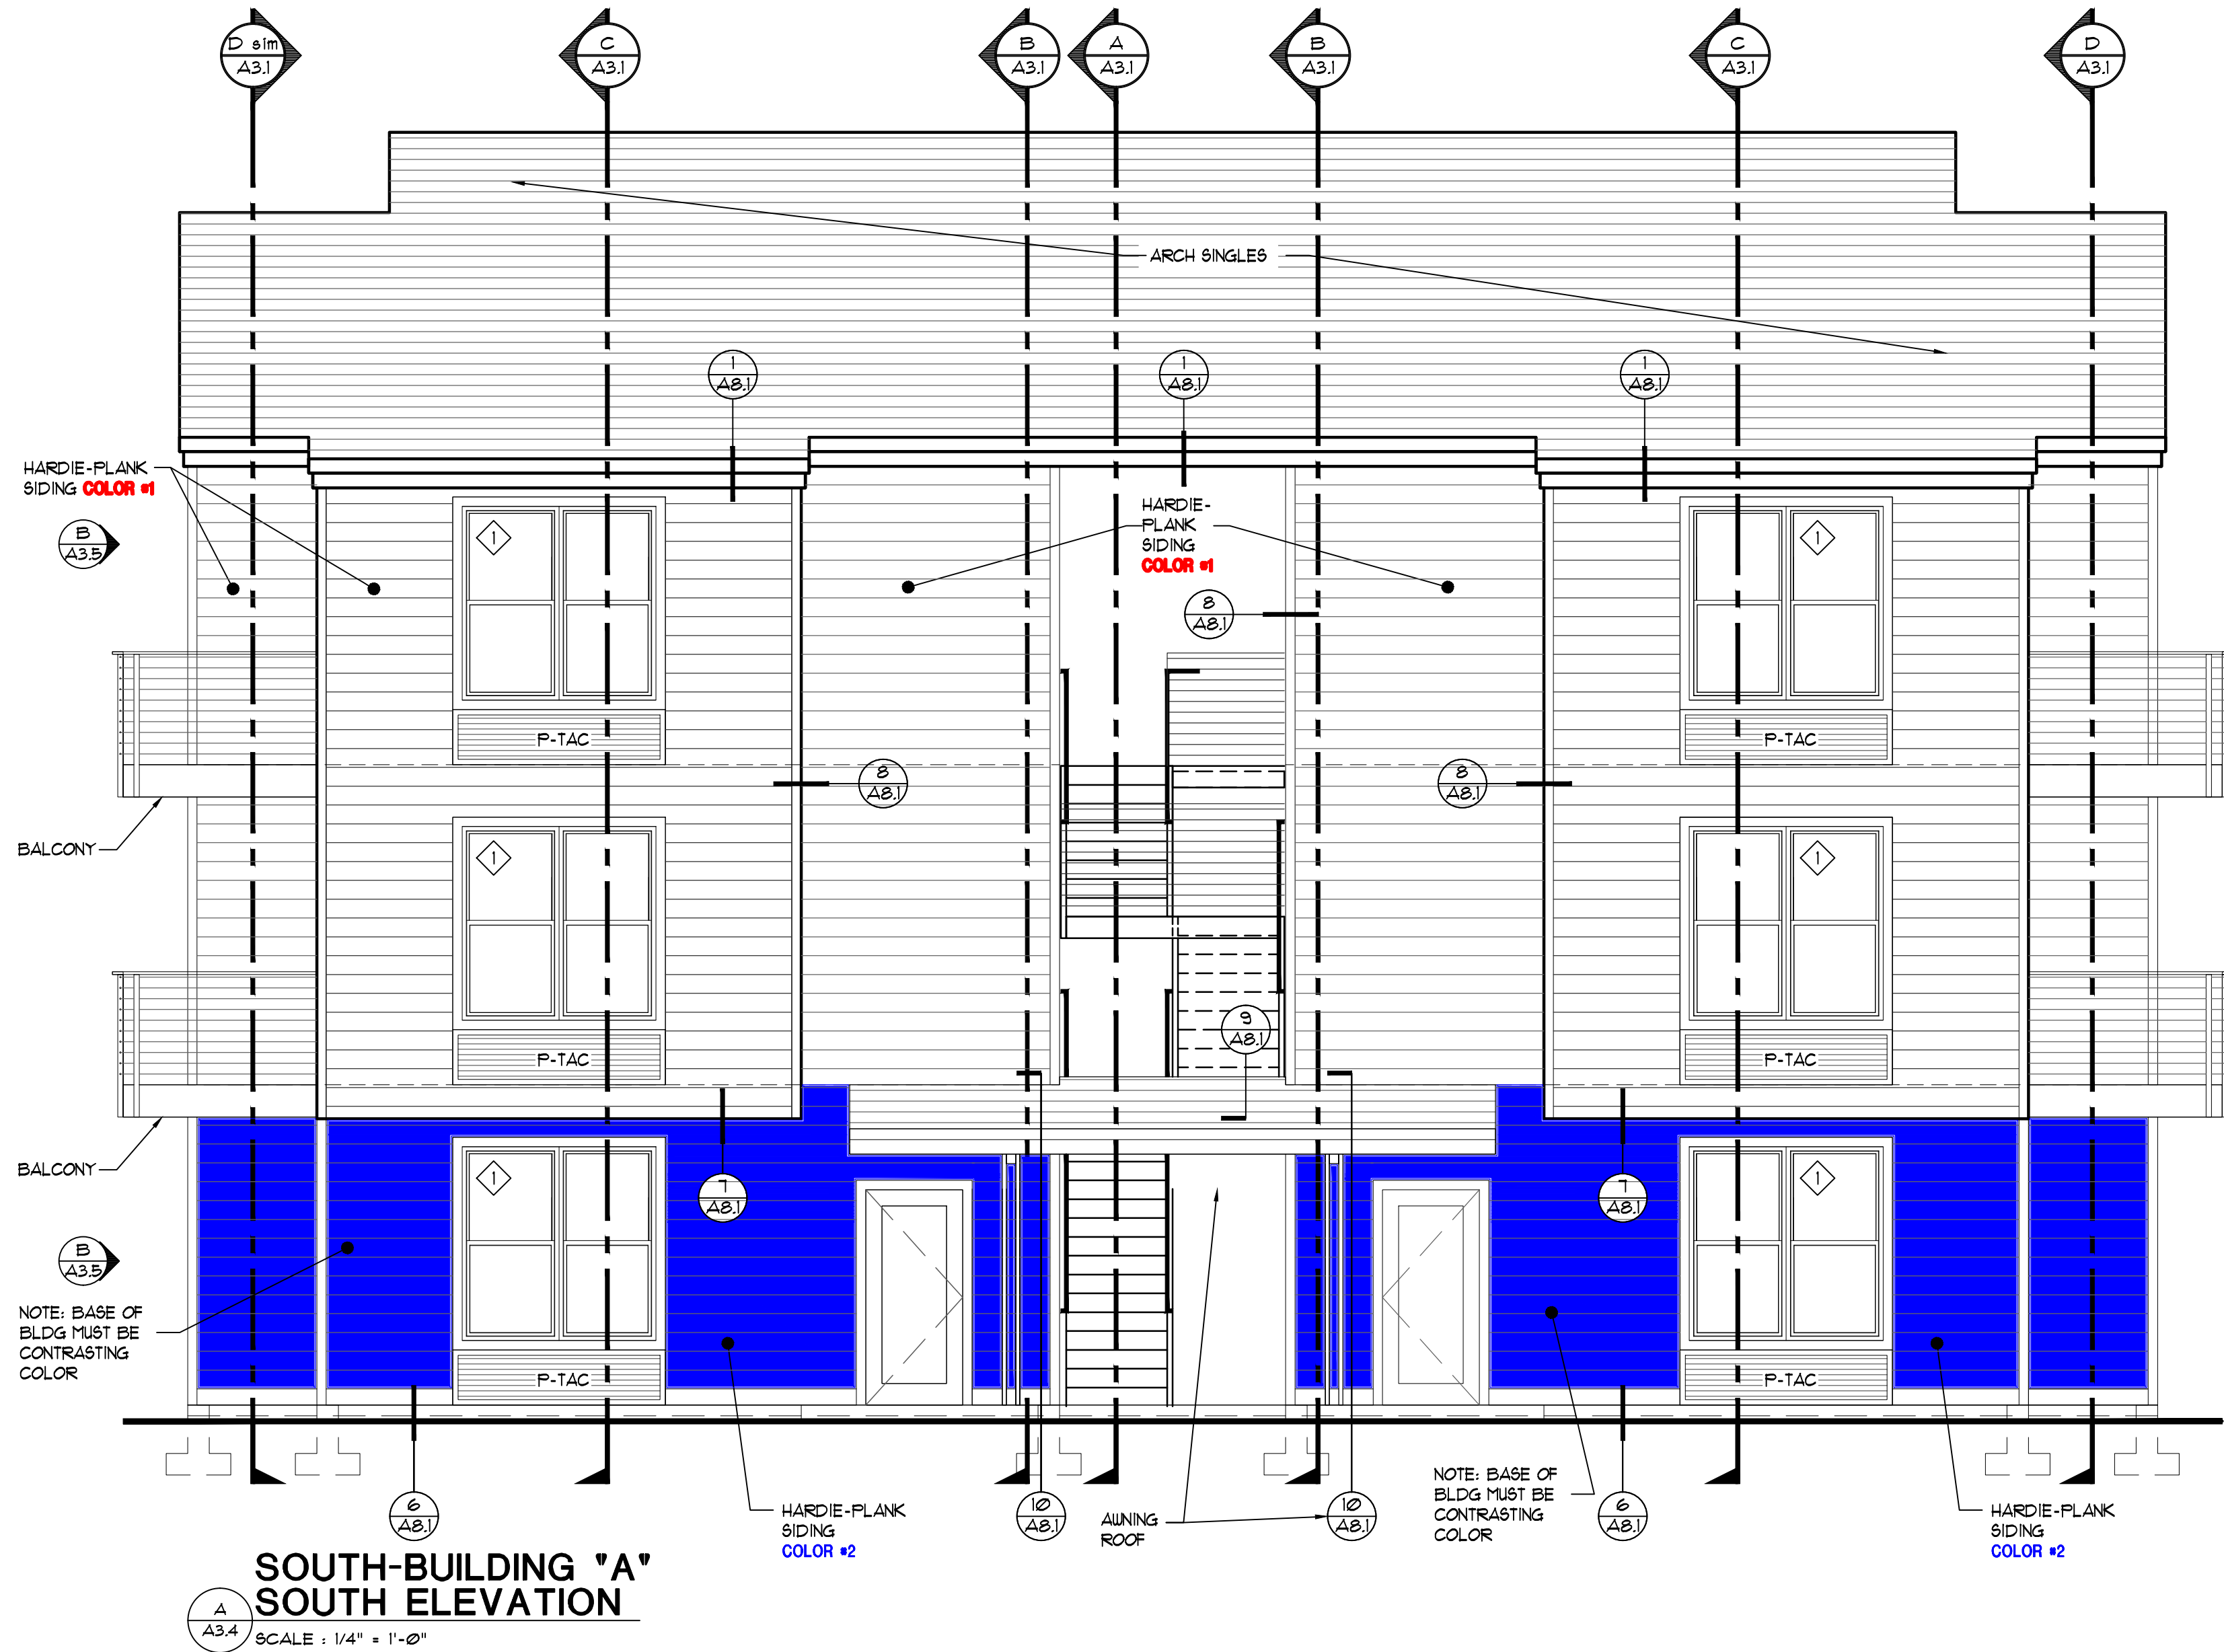

- 1 13 MARCH 2023 8/FR COMMENTS
- 2 9 FEB. 2024 CITY OF SALEM COMMENTS
- 3 9 FEB. 2024 REVIEW COMMENTS
- 4 28 MAR. 2024 CITY OF SALEM COMMENTS
- 5 14 JUNE 2024 EGRESS STAIR CHANGE
- 6 3 JULY 2024 CHANGE OFFICE TO STUDIO 4/4
- 7 REMOVAL OF STUDIO BALCONIES

NEW APARTMENTS FOR:
Waller St SE
1341 Waller St Salem, Or
DATE: 20 APRIL 2022
DRAWN: JOB NO. 2207
A3.4

