




LAST SAVED: Mon, 15 Jul 2024 - 04:43 pm LOCATION: C:\Users\trevo\appdata\local\temp\AcPublish_4156\A2.1_BldgA-1341.dwg A3.5
PRINTED: Mon, 15 Jul 2024 - 04:51 pm PRINTED BY: trevo

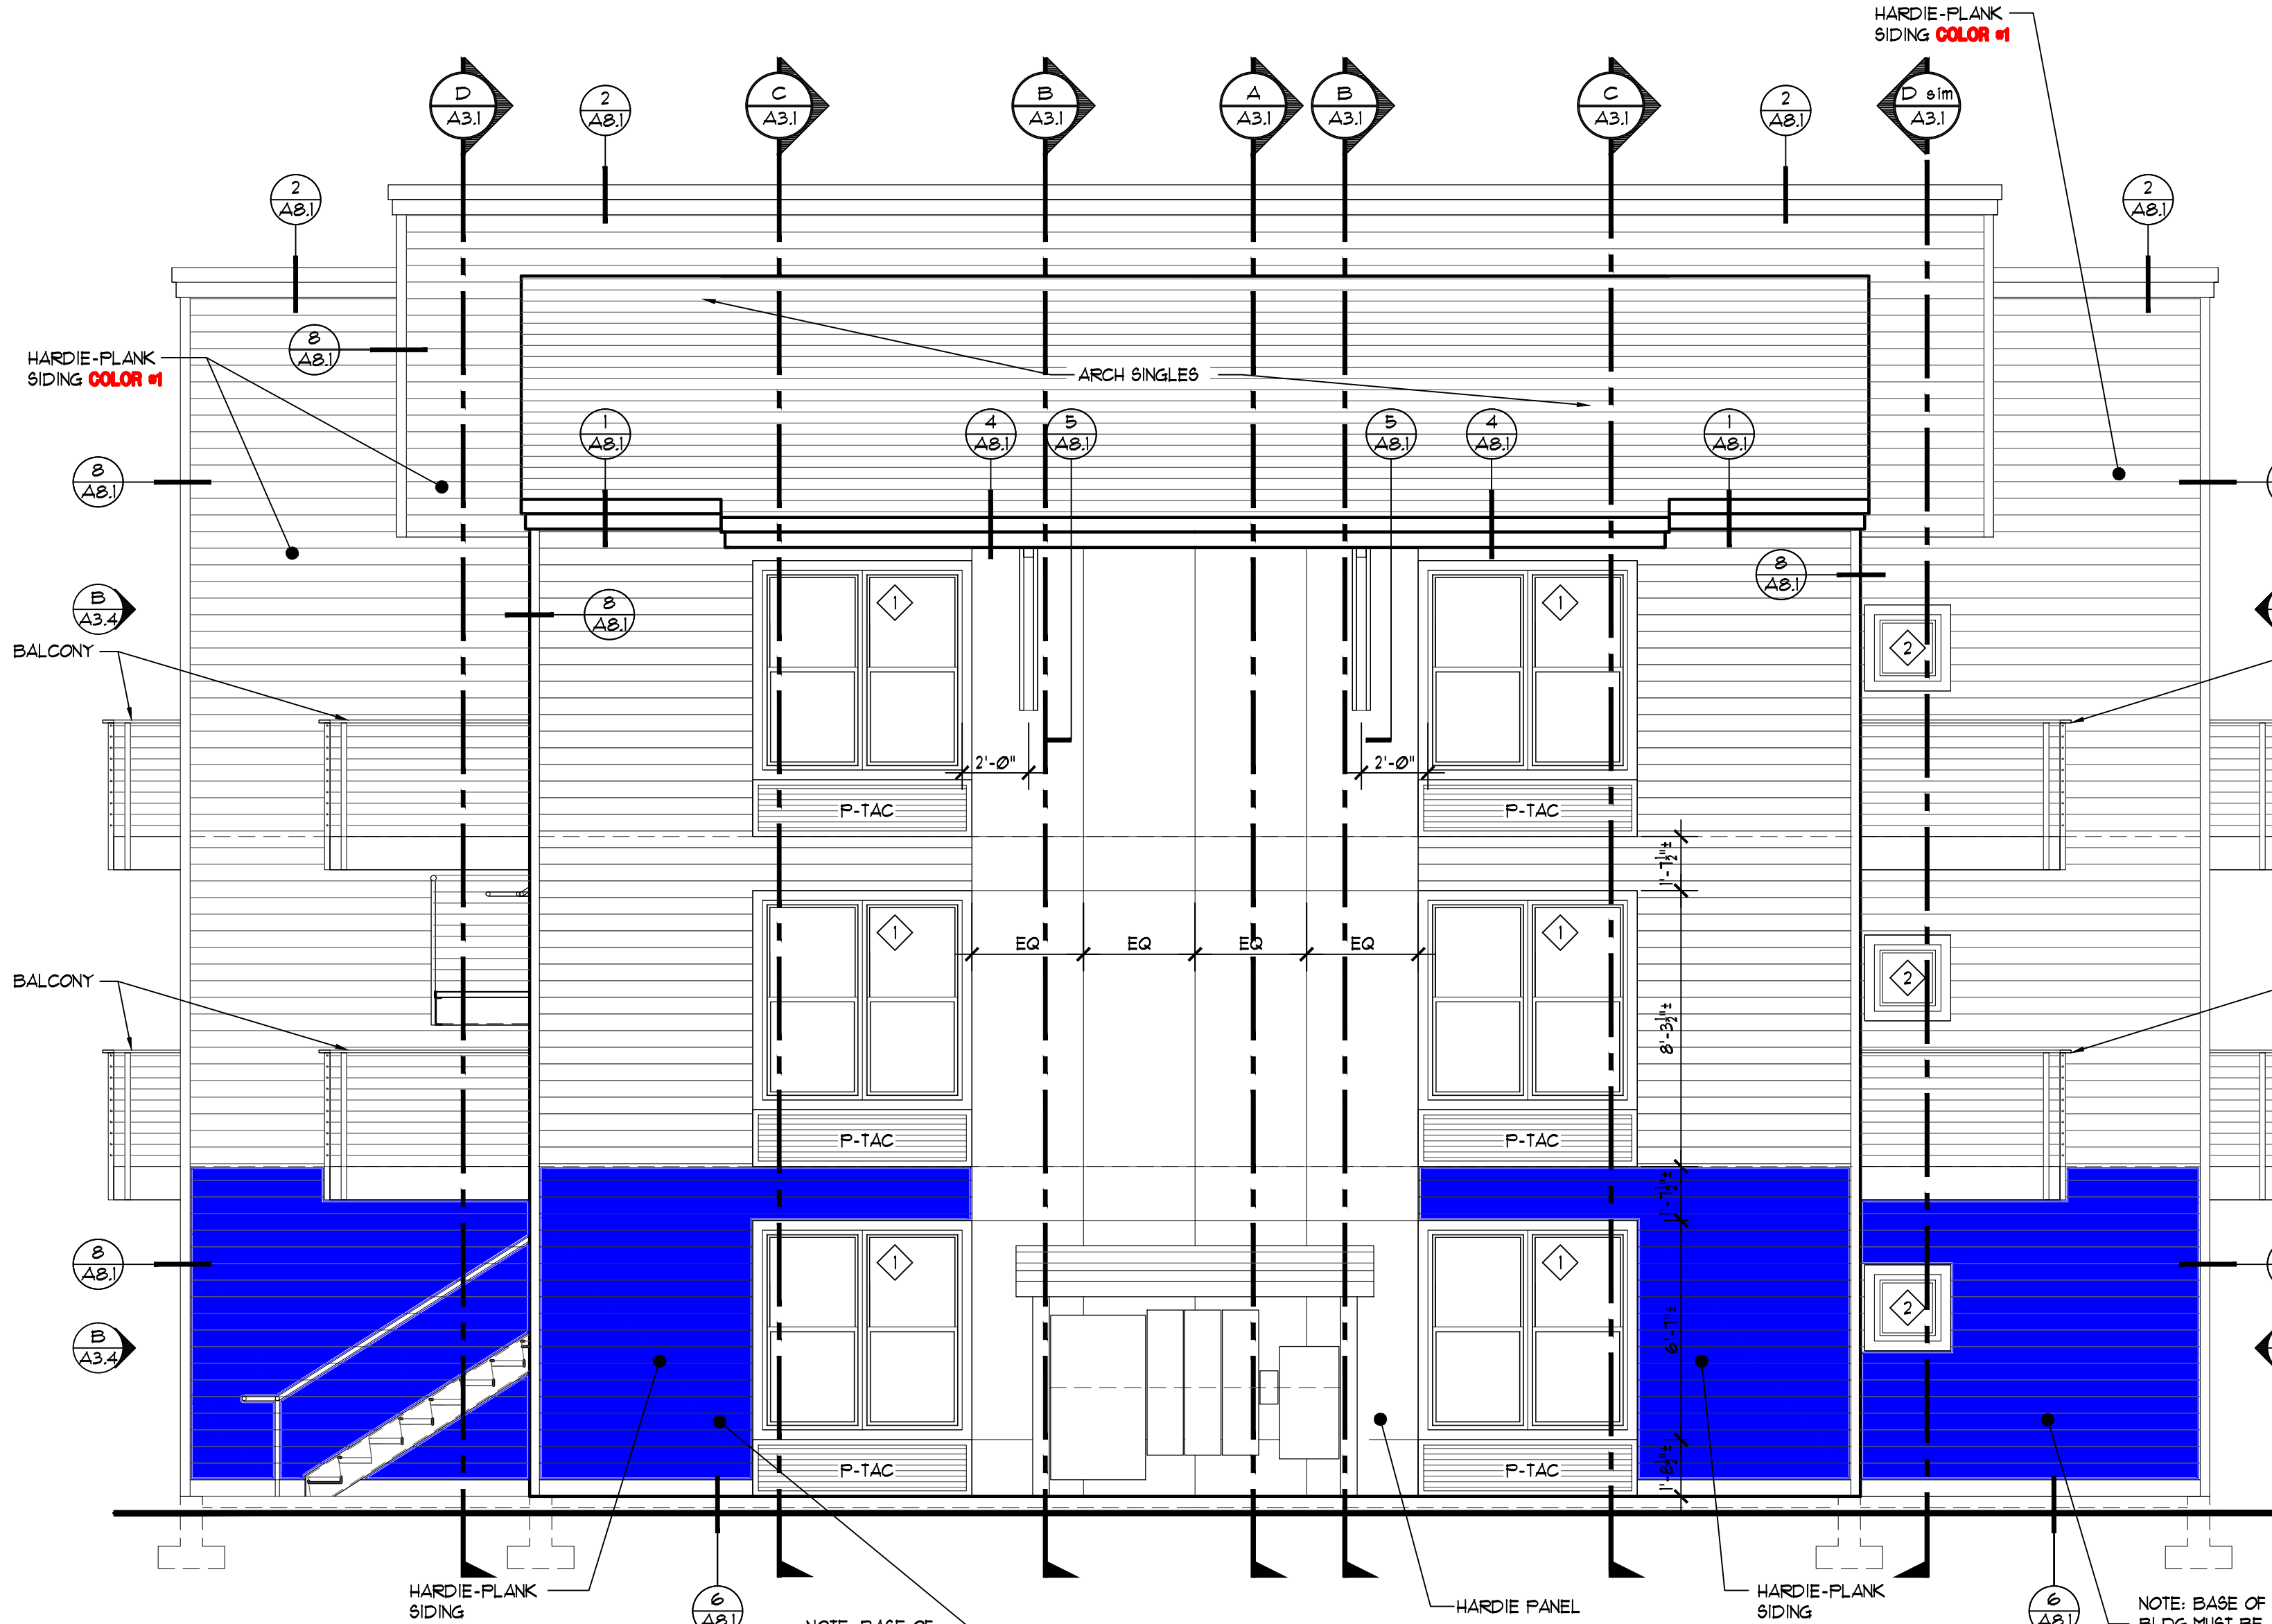


SOUTH-BUILDING 'A' NORTH ELEVATION
SCALE: 1/4" = 1'-0"

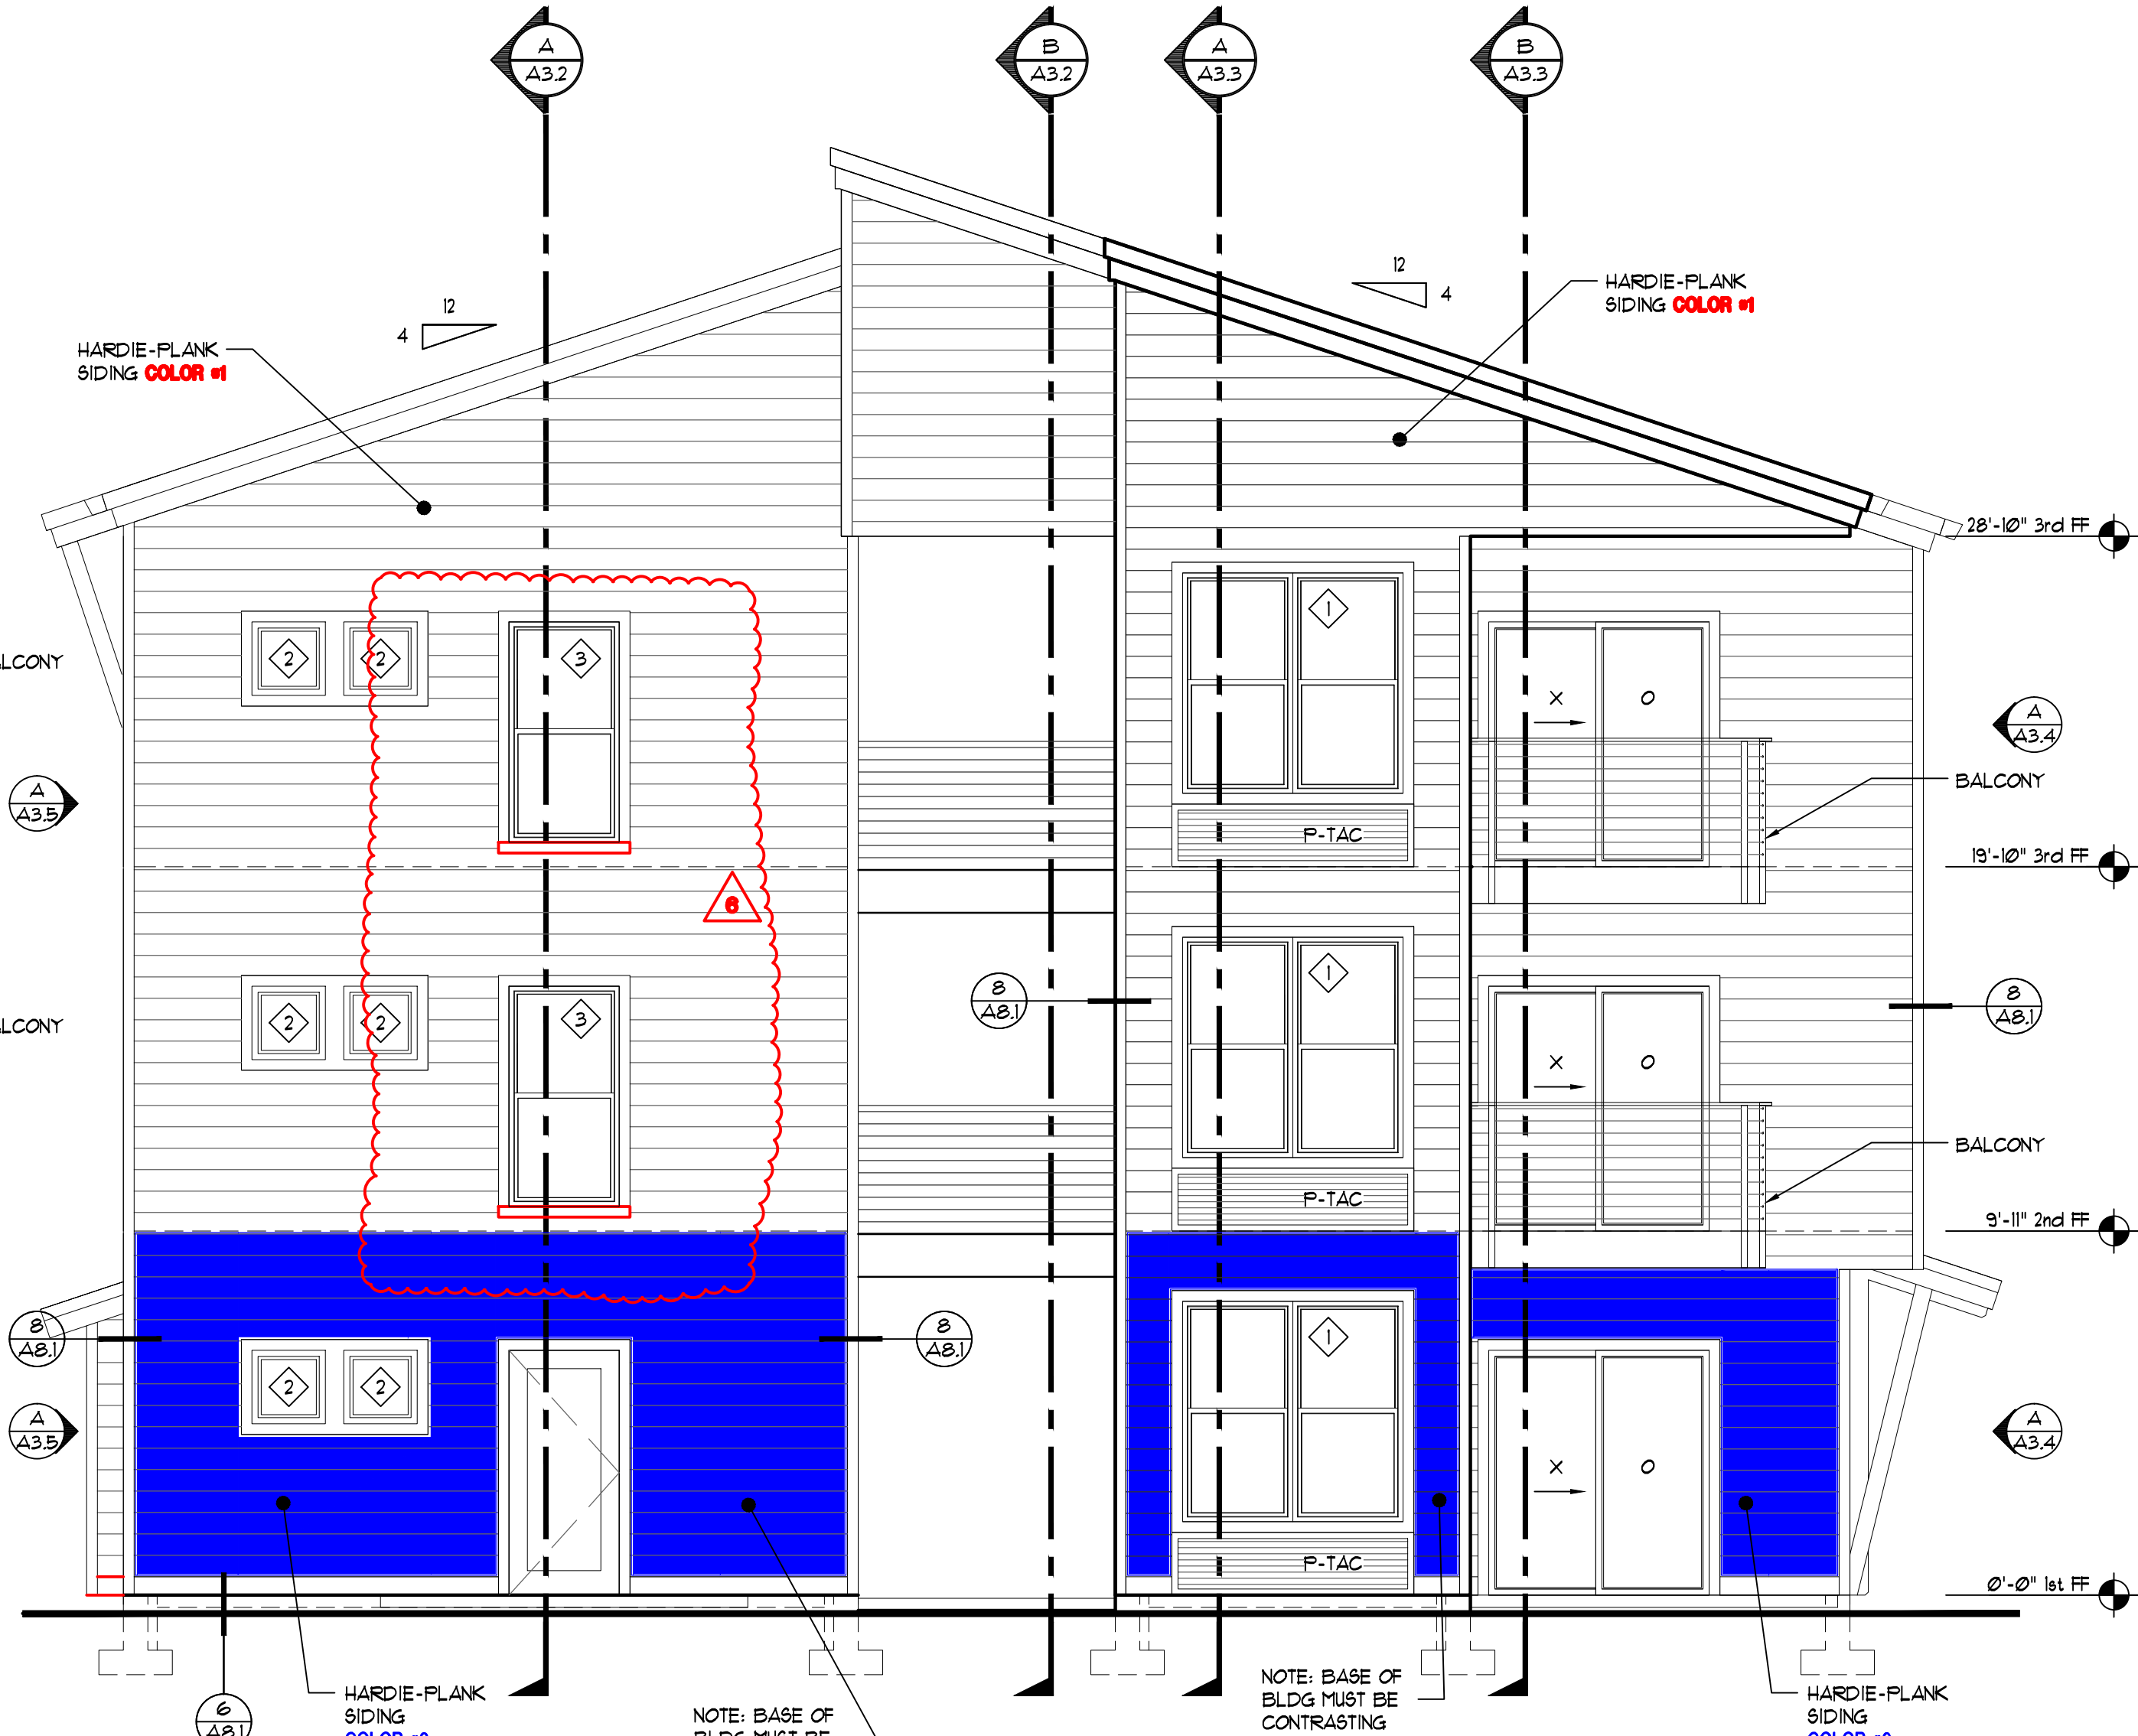


SOUTH-BUILDING 'A' WEST ELEVATION
SCALE: 1/4" = 1'-0"

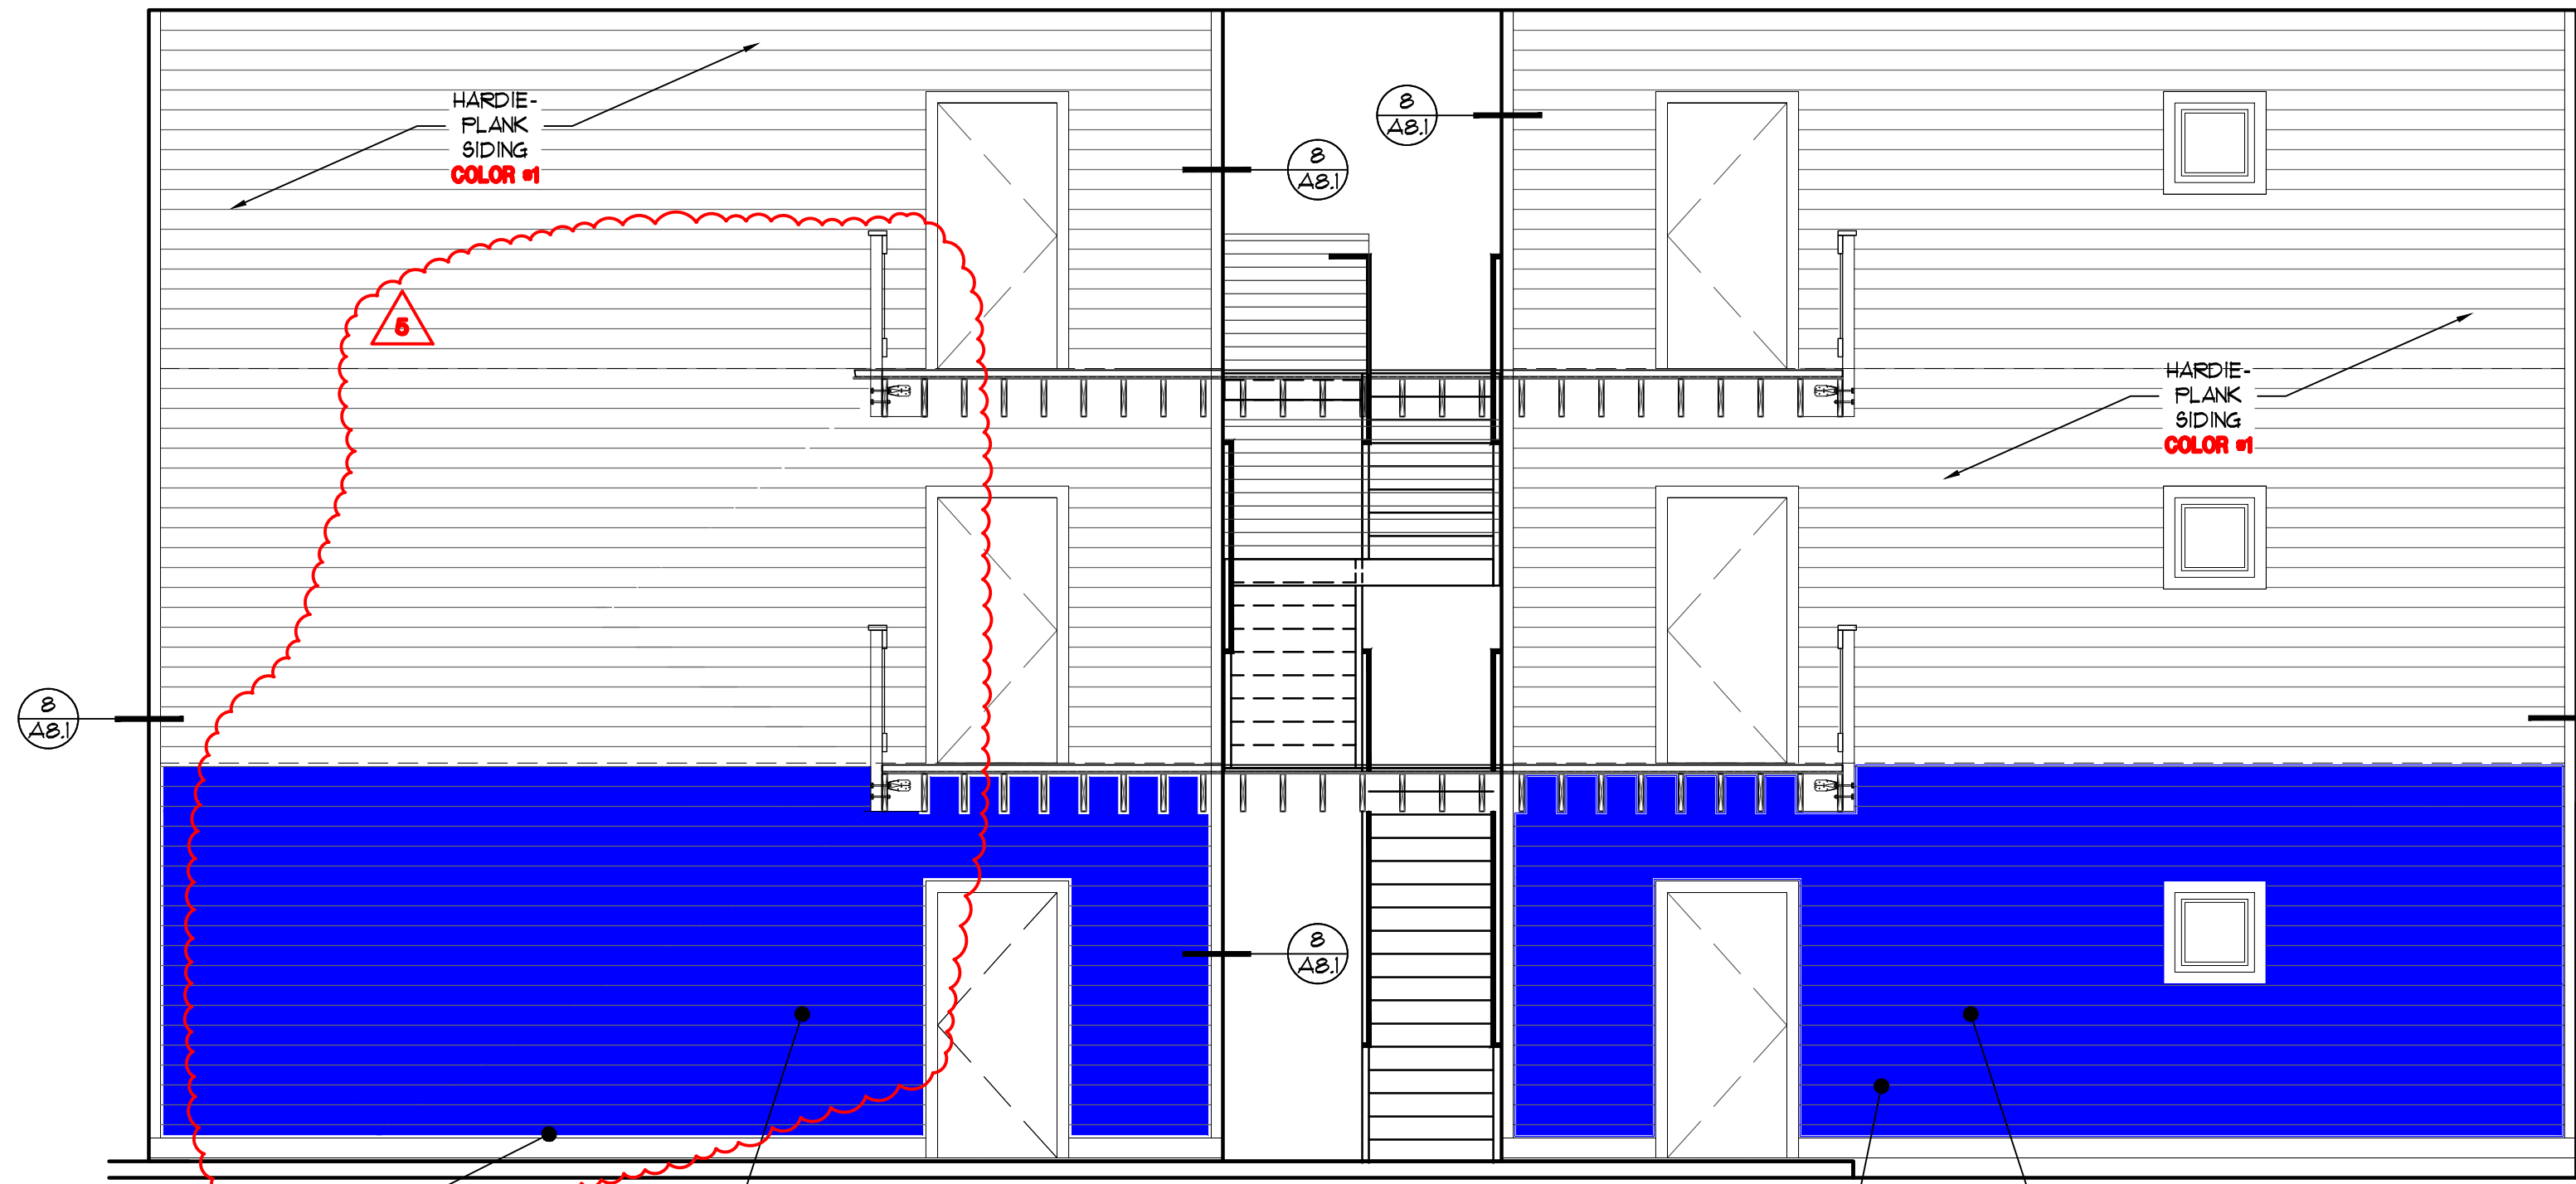


INTERIOR ELEVATION
SCALE: 1/4" = 1'-0"

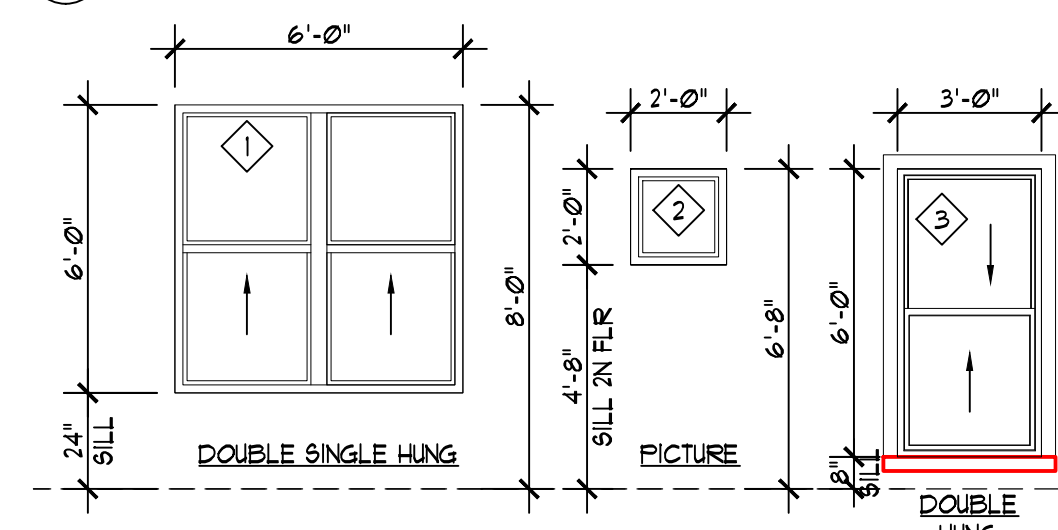

WINDOW TYPES
SCALE: 1/4" = 1'-0"

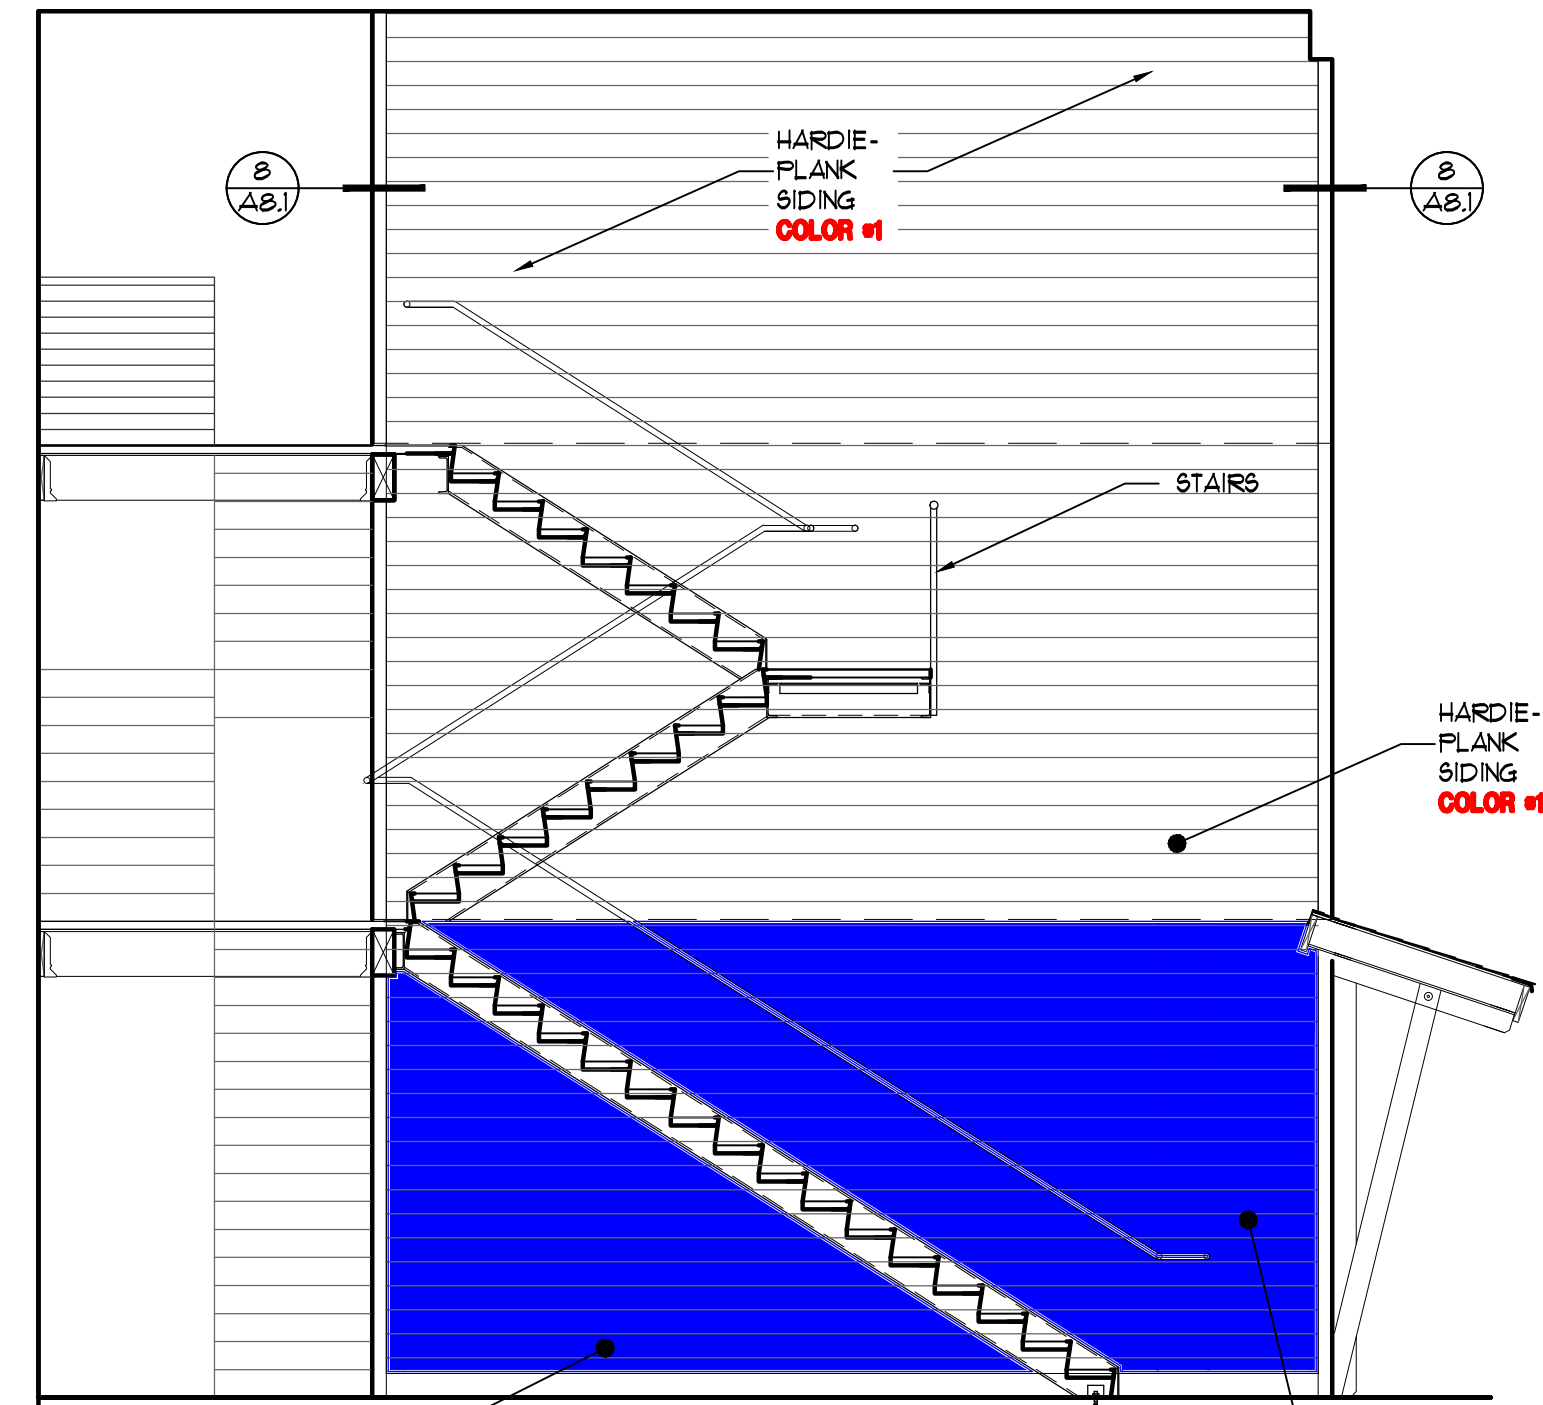

INTERIOR ELEVATION
SCALE: 1/4" = 1'-0"

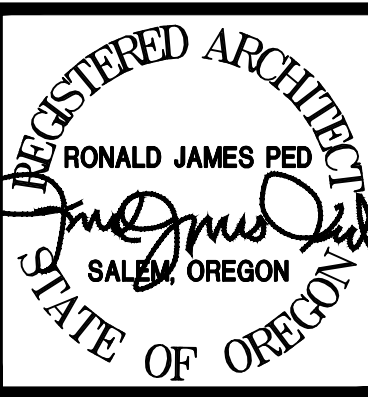

- 1 13 MARCH 2023 8/FR COMMENTS
- 2 9 FEB. 2024 CITY OF SALEM COMMENTS
- 3 9 FEB. 2024 REVIEW COMMENTS
- 4 28 MAR. 2024 CITY OF SALEM COMMENTS
- 5 14 JUNE 2024 EXPRESS STAIR CHANGE
- 6 3 JULY 2024 CHANGE OFFICE TO STUDIO 4/4 REMOVAL OF STUDIO BALCONIES

NEW APARTMENTS FOR
Waller St SE
1341 Waller St Salem, Or

DATE: 20 APRIL 2022
DRAWN: 2207

A3.5

CONSTRUCTION SET 04.29.2024