



LAST SAVED: Fri, 30 Aug 2024 - 11:44 am LOCATION: C:\Users\trevo\appdata\local\temp\AcPublish_19308\A1.1.dwg A1.2 lighting
PRINTED: Fri, 30 Aug 2024 - 11:45 am PRINTED BY: trevo

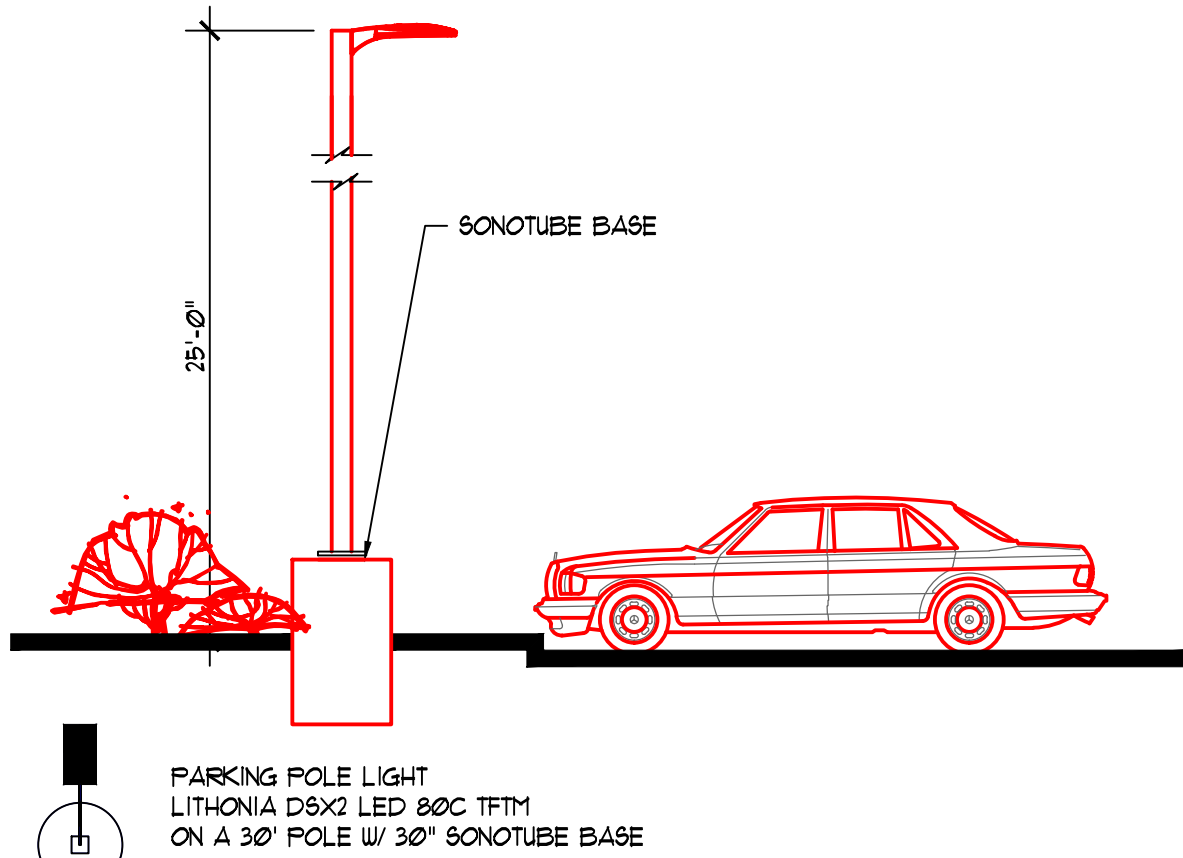


PARKING LOT LIGHTING SHOEBOX FIXTURE ON 25' POLE

SCALE: NTS M:\2018\TEUK\650\YDLIT\02850 LED LOT LIGHT


MOUNT HT 25'
STREET LIGHT (STANDALONE OR POLE MOUNT PER PGE)
LEOTEK GCL1-80J-MV-30K-3R

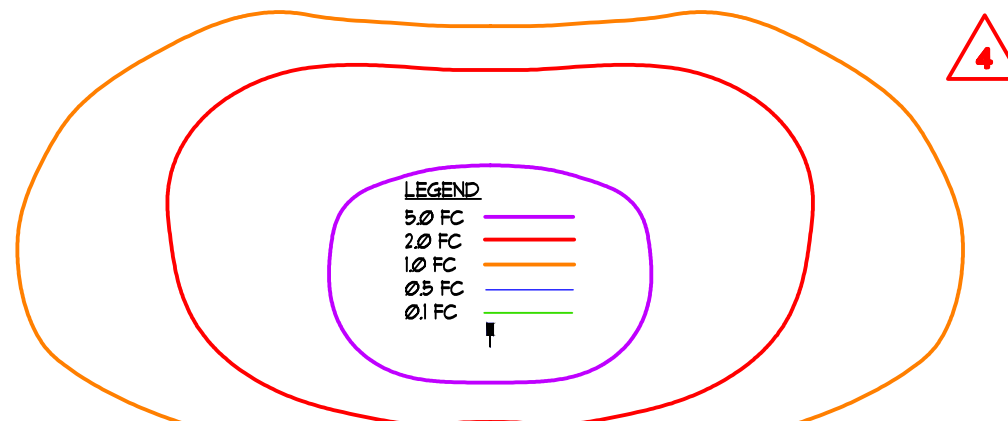



MOUNT HT 9'
BUILDING WALL LIGHT
LITHONIA TWP 10C

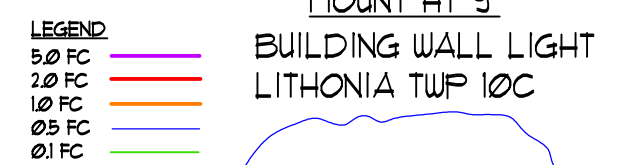

MOUNT HT 25'
PARKING POLE LIGHT
LITHONIA DSX2 LED 80C TFTM

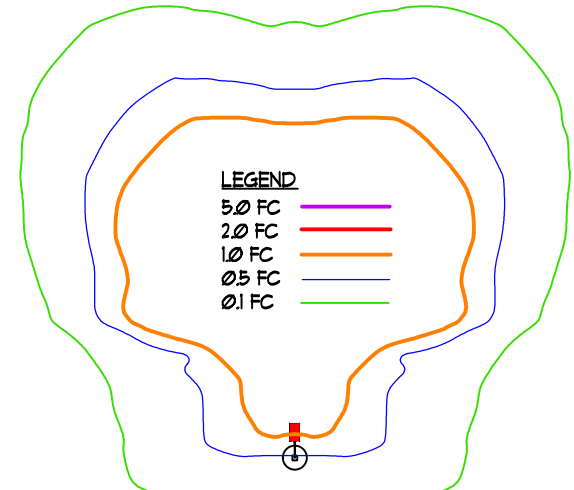

LIGHTING SCHEDULE

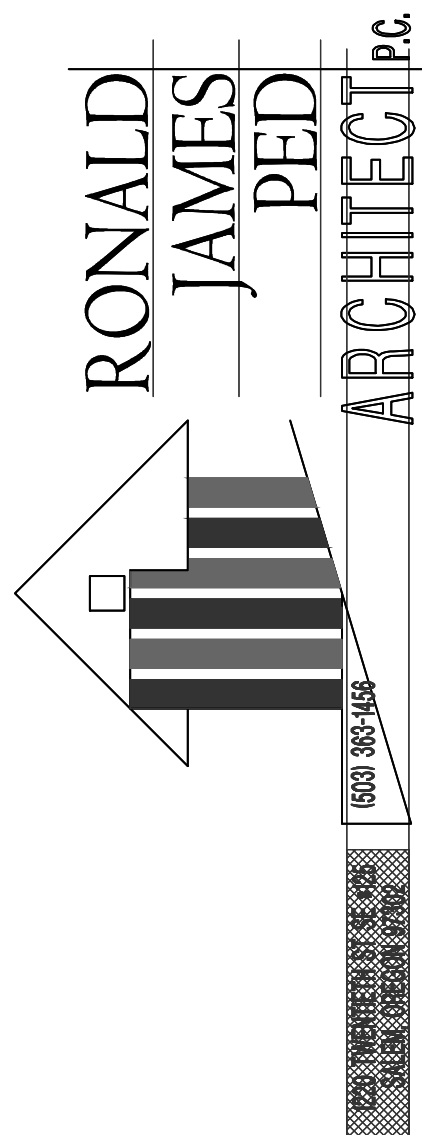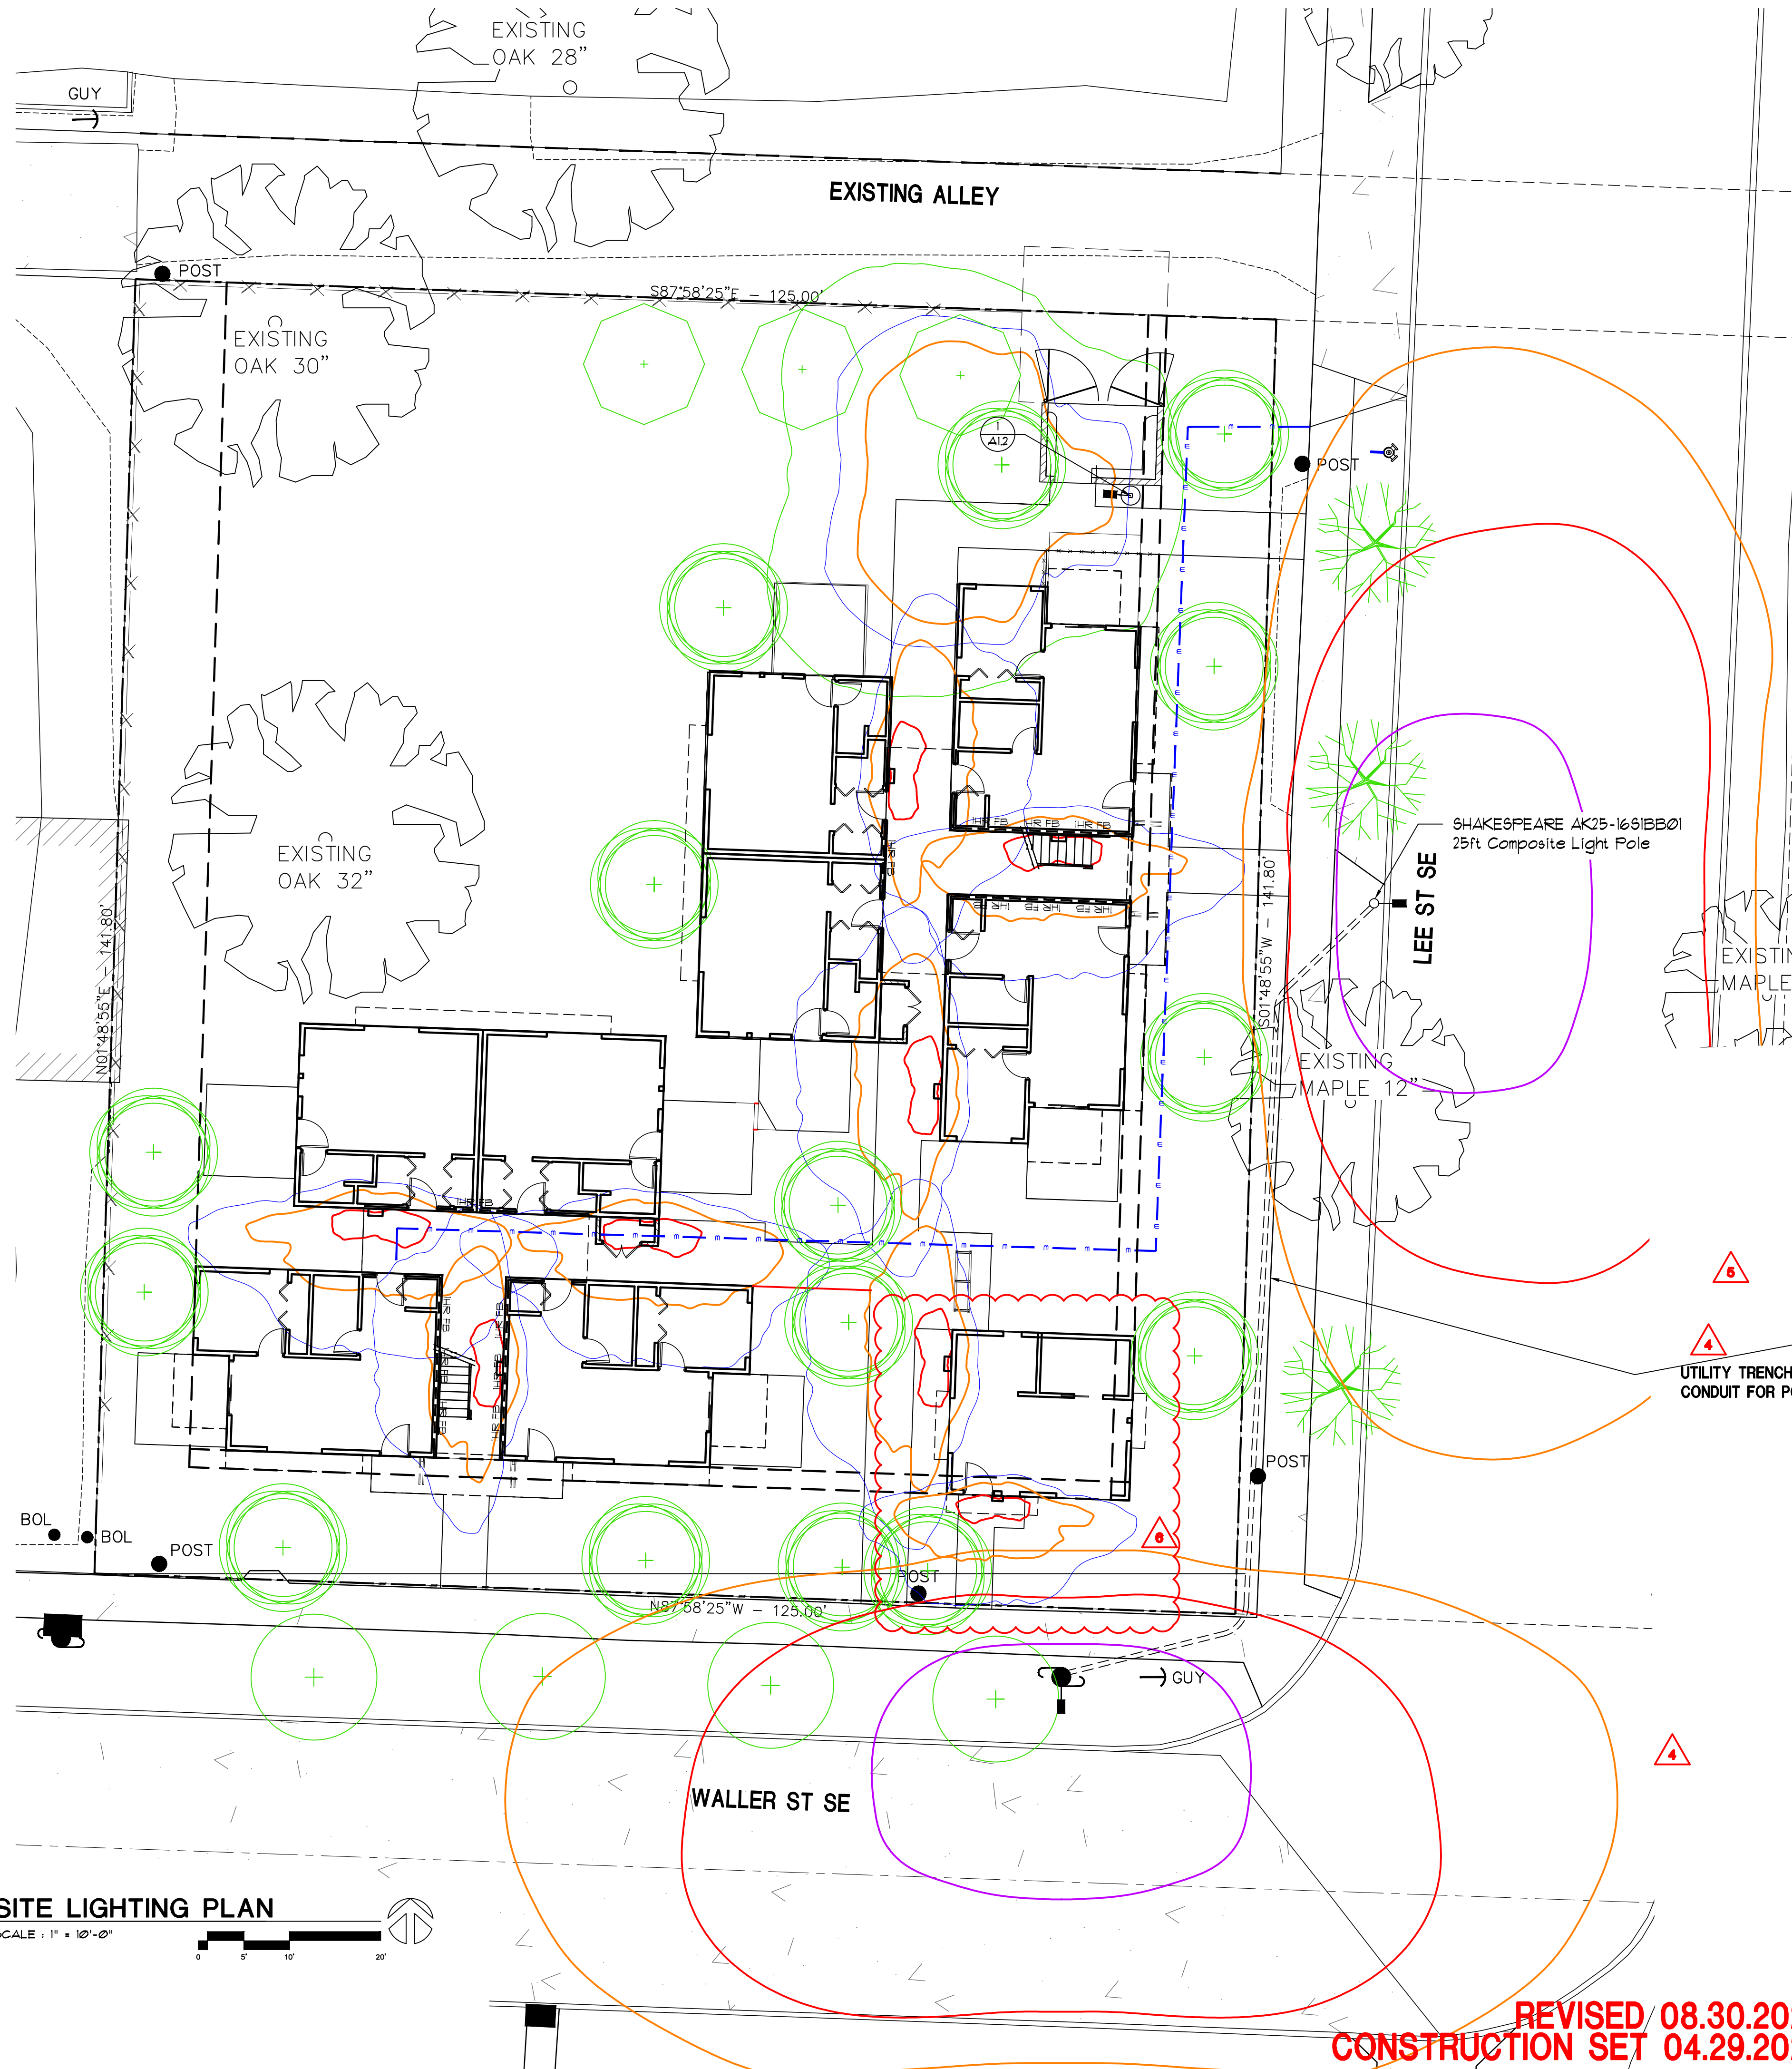

- 1 13 MARCH 2023 6PR COMMENTS
- 2 9 FEB 2024 CITY OF SALEM COMMENTS
- 3 9 FEB 2024 REVIEW COMMENTS
- 4 28 MAR 2024 CITY OF SALEM COMMENTS
- 5 14 JUNE 2024 ESPRESSO STAIR CHANGE
- 6 3 JULY 2024 CHANGE OFFICE TO STUDIO 2474

UTILITY TRENCH AND CONDUIT FOR PGE

NEW APARTMENTS FOR:
Waller St SE
1345 Waller St Salem, Or

DATE: 20 APRIL 2022
DRAWN: JOB NO. 2207

A1.2

REVISED 08.30.2024
CONSTRUCTION SET 04.29.2024