


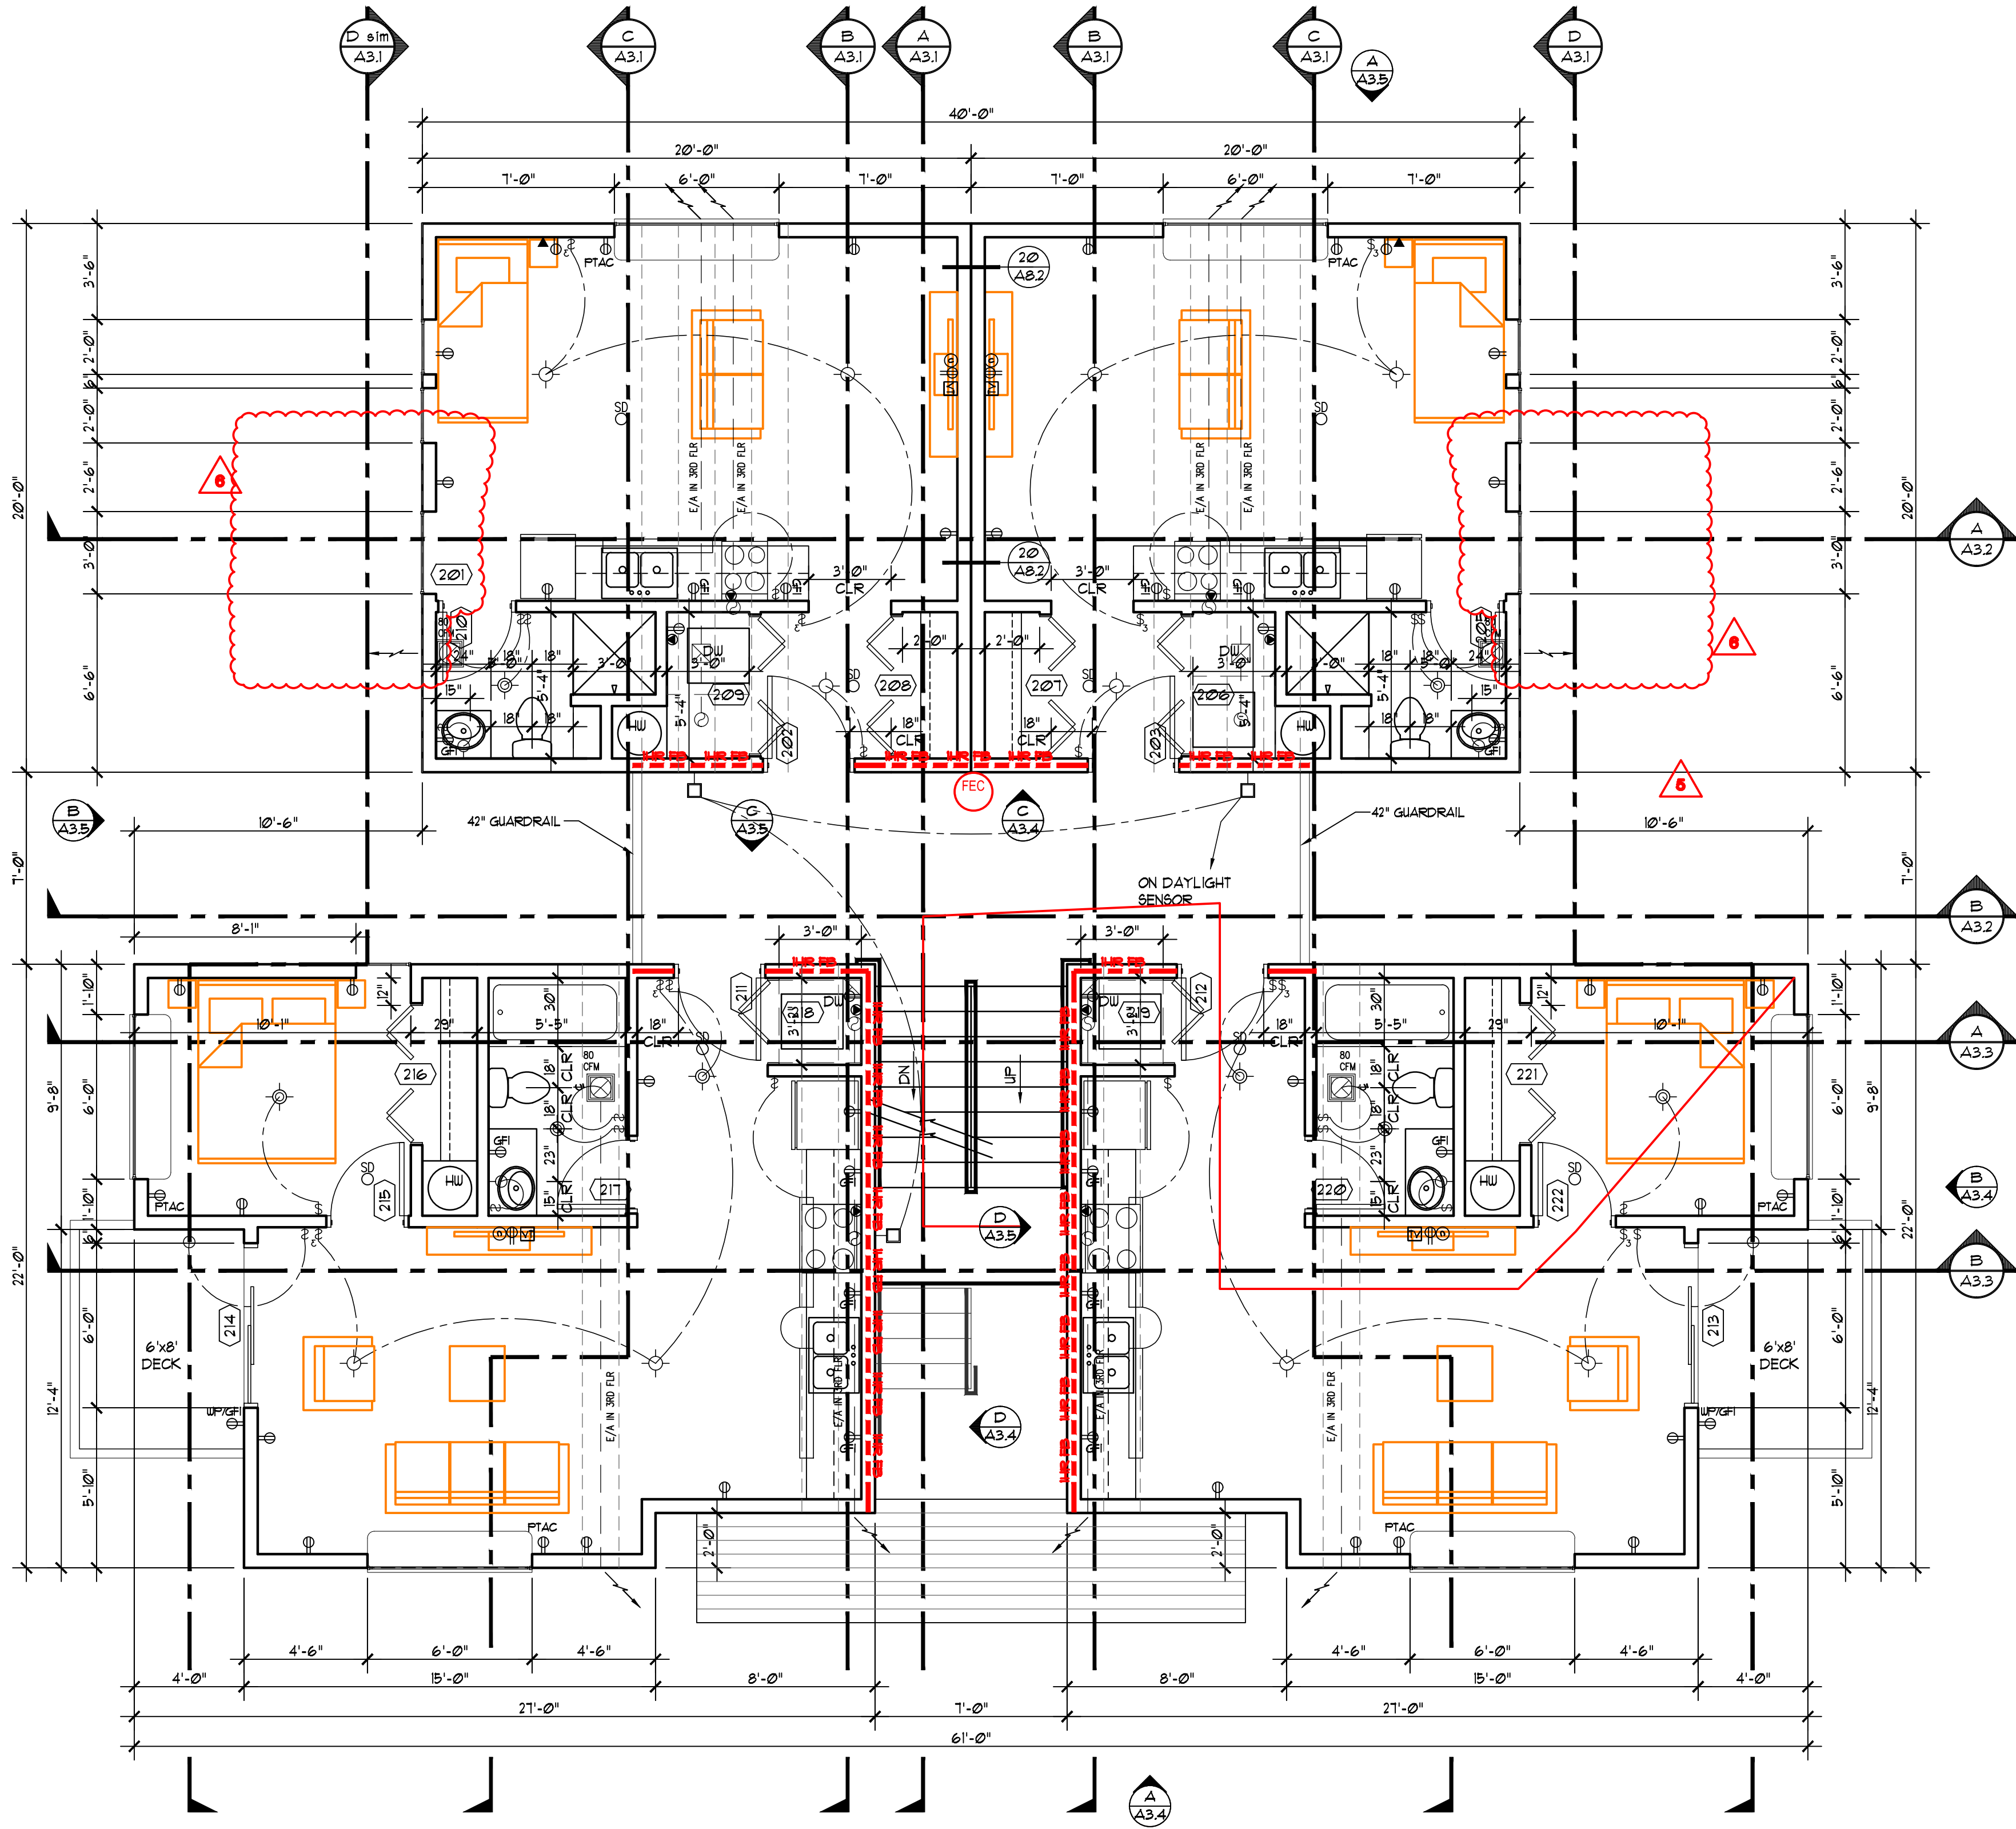

**PROPOSED
SECOND FLOOR PLAN**
SCALE: 1/4" = 1'-0"
**BUILDING '1341' SET
SOUTH BUILDING**

DOOR SCHEDULE						
"ALL DOORS TO RECEIVE LEVER TYPE HARDWARE"		TYPE	CONST	FINISH	GLASS	FRAME
NO.	SIZE					
201	NOT USED					
202	3'-0"x6'-8"x13/4"	B	HM	ME	-	20
203	3'-0"x6'-8"x13/4"	B	HM	ME	-	20
204	NOT USED					
205	3'-0"x6'-8"x13/4"	B	TY	TY	-	3
206	5'-0"x6'-8"x13/4"	E	TY	TY	-	1
207	5'-0"x6'-8"x13/4"	E	TY	TY	-	1
208	5'-0"x6'-8"x13/4"	E	TY	TY	-	1
209	5'-0"x6'-8"x13/4"	E	TY	TY	-	1
210	3'-0"x6'-8"x13/4"	B	TY	TY	-	3
211	3'-0"x6'-8"x13/4"	B	HM	ME	-	20
212	3'-0"x6'-8"x13/4"	B	HM	ME	-	20
213	6'-0"x6'-8"x13/4"	C	VIN	FF	-	1
214	3'-0"x6'-8"x13/4"	B	HM	ME	-	1
215	2'-8"x6'-8"x13/4"	B	TY	TY	-	4
216	5'-0"x6'-8"x13/4"	E	TY	TY	-	1
217	2'-6"x6'-8"x13/4"	B	TY	TY	-	3
218	3'-0"x6'-8"x13/4"	D	TY	TY	-	1
219	3'-0"x6'-8"x13/4"	D	TY	TY	-	1
220	2'-6"x6'-8"x13/4"	B	TY	TY	-	3
221	5'-0"x6'-8"x13/4"	E	TY	TY	-	1
222	2'-8"x6'-8"x13/4"	B	TY	TY	-	4


- GROUP 1
ALL HARDWARE BY MFR
- GROUP 2
1 LOCK
1 1/2 PR HINGES
THRESHOLD
WEATHER STRIP
- GROUP 3
1 PRIVACY LOCK
1 1/2 PR HINGES
1 WALL STOP
- GROUP 4
1 PRIVACY LOCK
1 1/2 PR HINGES
1 WALL STOP
- GROUP 5
1 LOCK
1 1/2 PR HINGES
1 CLOSER
SMOKE GASKET
THRESHOLD
WEATHER STRIP

SYMBOL KEY

- SD SMOKE DETECTOR HARDWIRED, WITH BATTERY BACKUP
- DUPLX OUTLET
- DUPLX OUTLET GFCI
- DUPLX OUTLET GFCI / WATER PROOF
- 220 OUTLET
- TELEVISION CABLE CONNECTION
- TELEPHONE OUTLET
- SINGLE POLE SWITCH
- THREE WAY SWITCH
- SURFACE MOUNT LIGHT FIXTURE
- EXTERIOR WALL MOUNT LIGHT FIXTURE ON DAYLIGHT SENSOR
- KITCHEN STRIP LIGHTING
- LAUNDRY EXHAUST FAN
- 80 CFM FAN/LIGHT / ON TIMER SWITCH
- 150 CFM KITCHEN EXHAUST FAN

DOOR TYPES

1. " " SHOWN ON SCHEDULE INDICATES TYPICAL
2. DOOR TYPES
3. CONSTRUCTION
TYPICAL - SOLID CORE
HC - HOLLOW CORE
HM - HOLLOW METAL
MC - MINERAL CORE
RU - ROLL UP/COIL
AL - ALUMINIUM & GLASS
VIN-VINYL
4. MATERIAL/FINISH
TYPICAL - WOOD TRANSPARENT
WF - WOOD FACTORY
PL - PLASTIC LAMINATE
ME - METAL ENAMEL
WE - WOOD ENAMEL
FF - FACTORY FINISH
5. GLASS
TYPICAL - CLEAR WIRE
TP - TEMPERED PLATE
SF - SAFETY GLASS
6. 20, 45, 60, 90, INDICATES RATING IN MINUTES FOR OPENING
7. TYPICAL FRAMES SHOWN " " NUMBER INDICATES DETAIL SHOWN ON SHEET.
8. NUMBER REFERS TO HARDWARE GROUP OF HARDWARE SCHEDULE

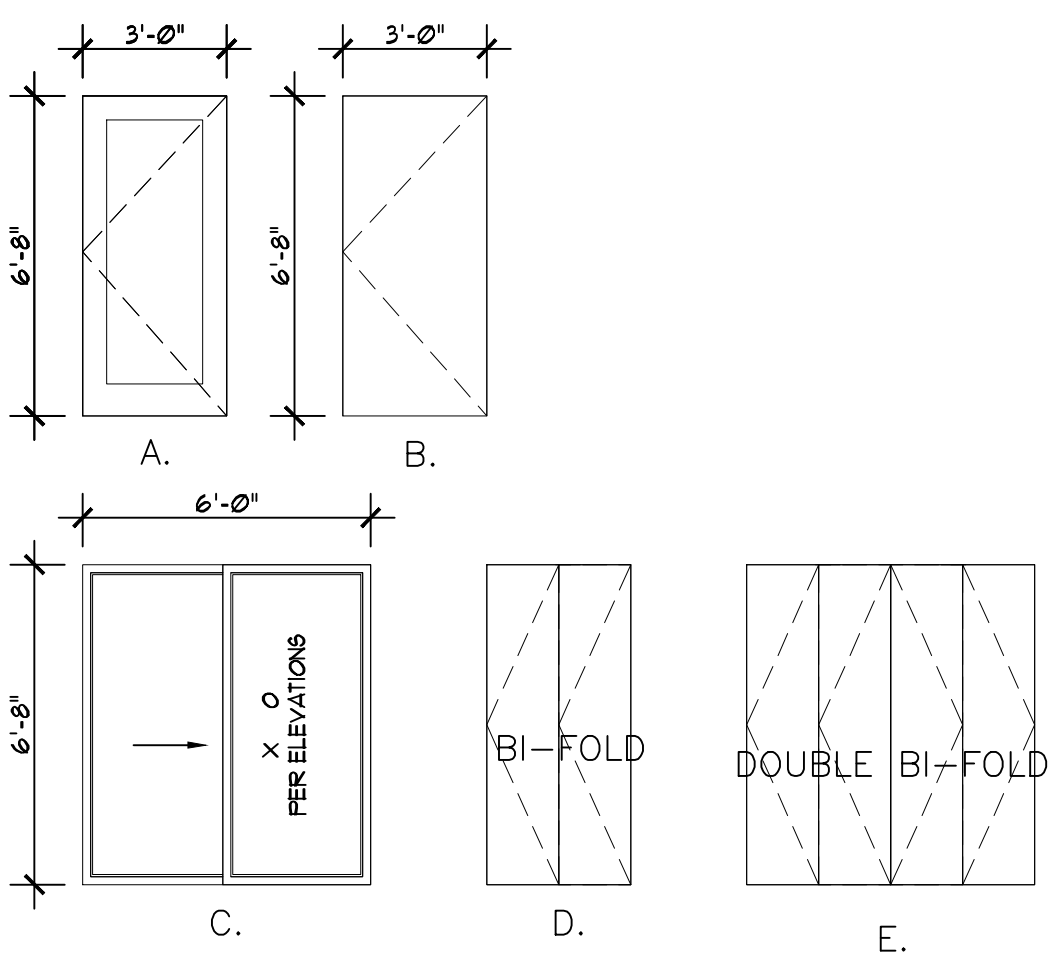

- 1. 13 MARCH 2023 84R COMMENTS
- 2. 9 FEB. 2024 CITY OF SALEM COMMENTS
- 3. 9 FEB. 2024 REVIEW COMMENTS
- 4. 28 MAR. 2024 CITY OF SALEM COMMENTS
- 5. 14 JUNE 2024 EGRESS STAIR CHANGE
- 6. 3 JULY 2024 CHANGE OFFICE TO STUDIO 207 & REMOVAL OF STUDIO BALCONIES

NEW APARTMENTS FOR-
SE
Waller St SE
1341 Waller St Salem, Or

DATE: 20 APRIL 2022
DRAWN:
JOB NO.: 2207
A2.2

CONSTRUCTION SET 04.29.2024