


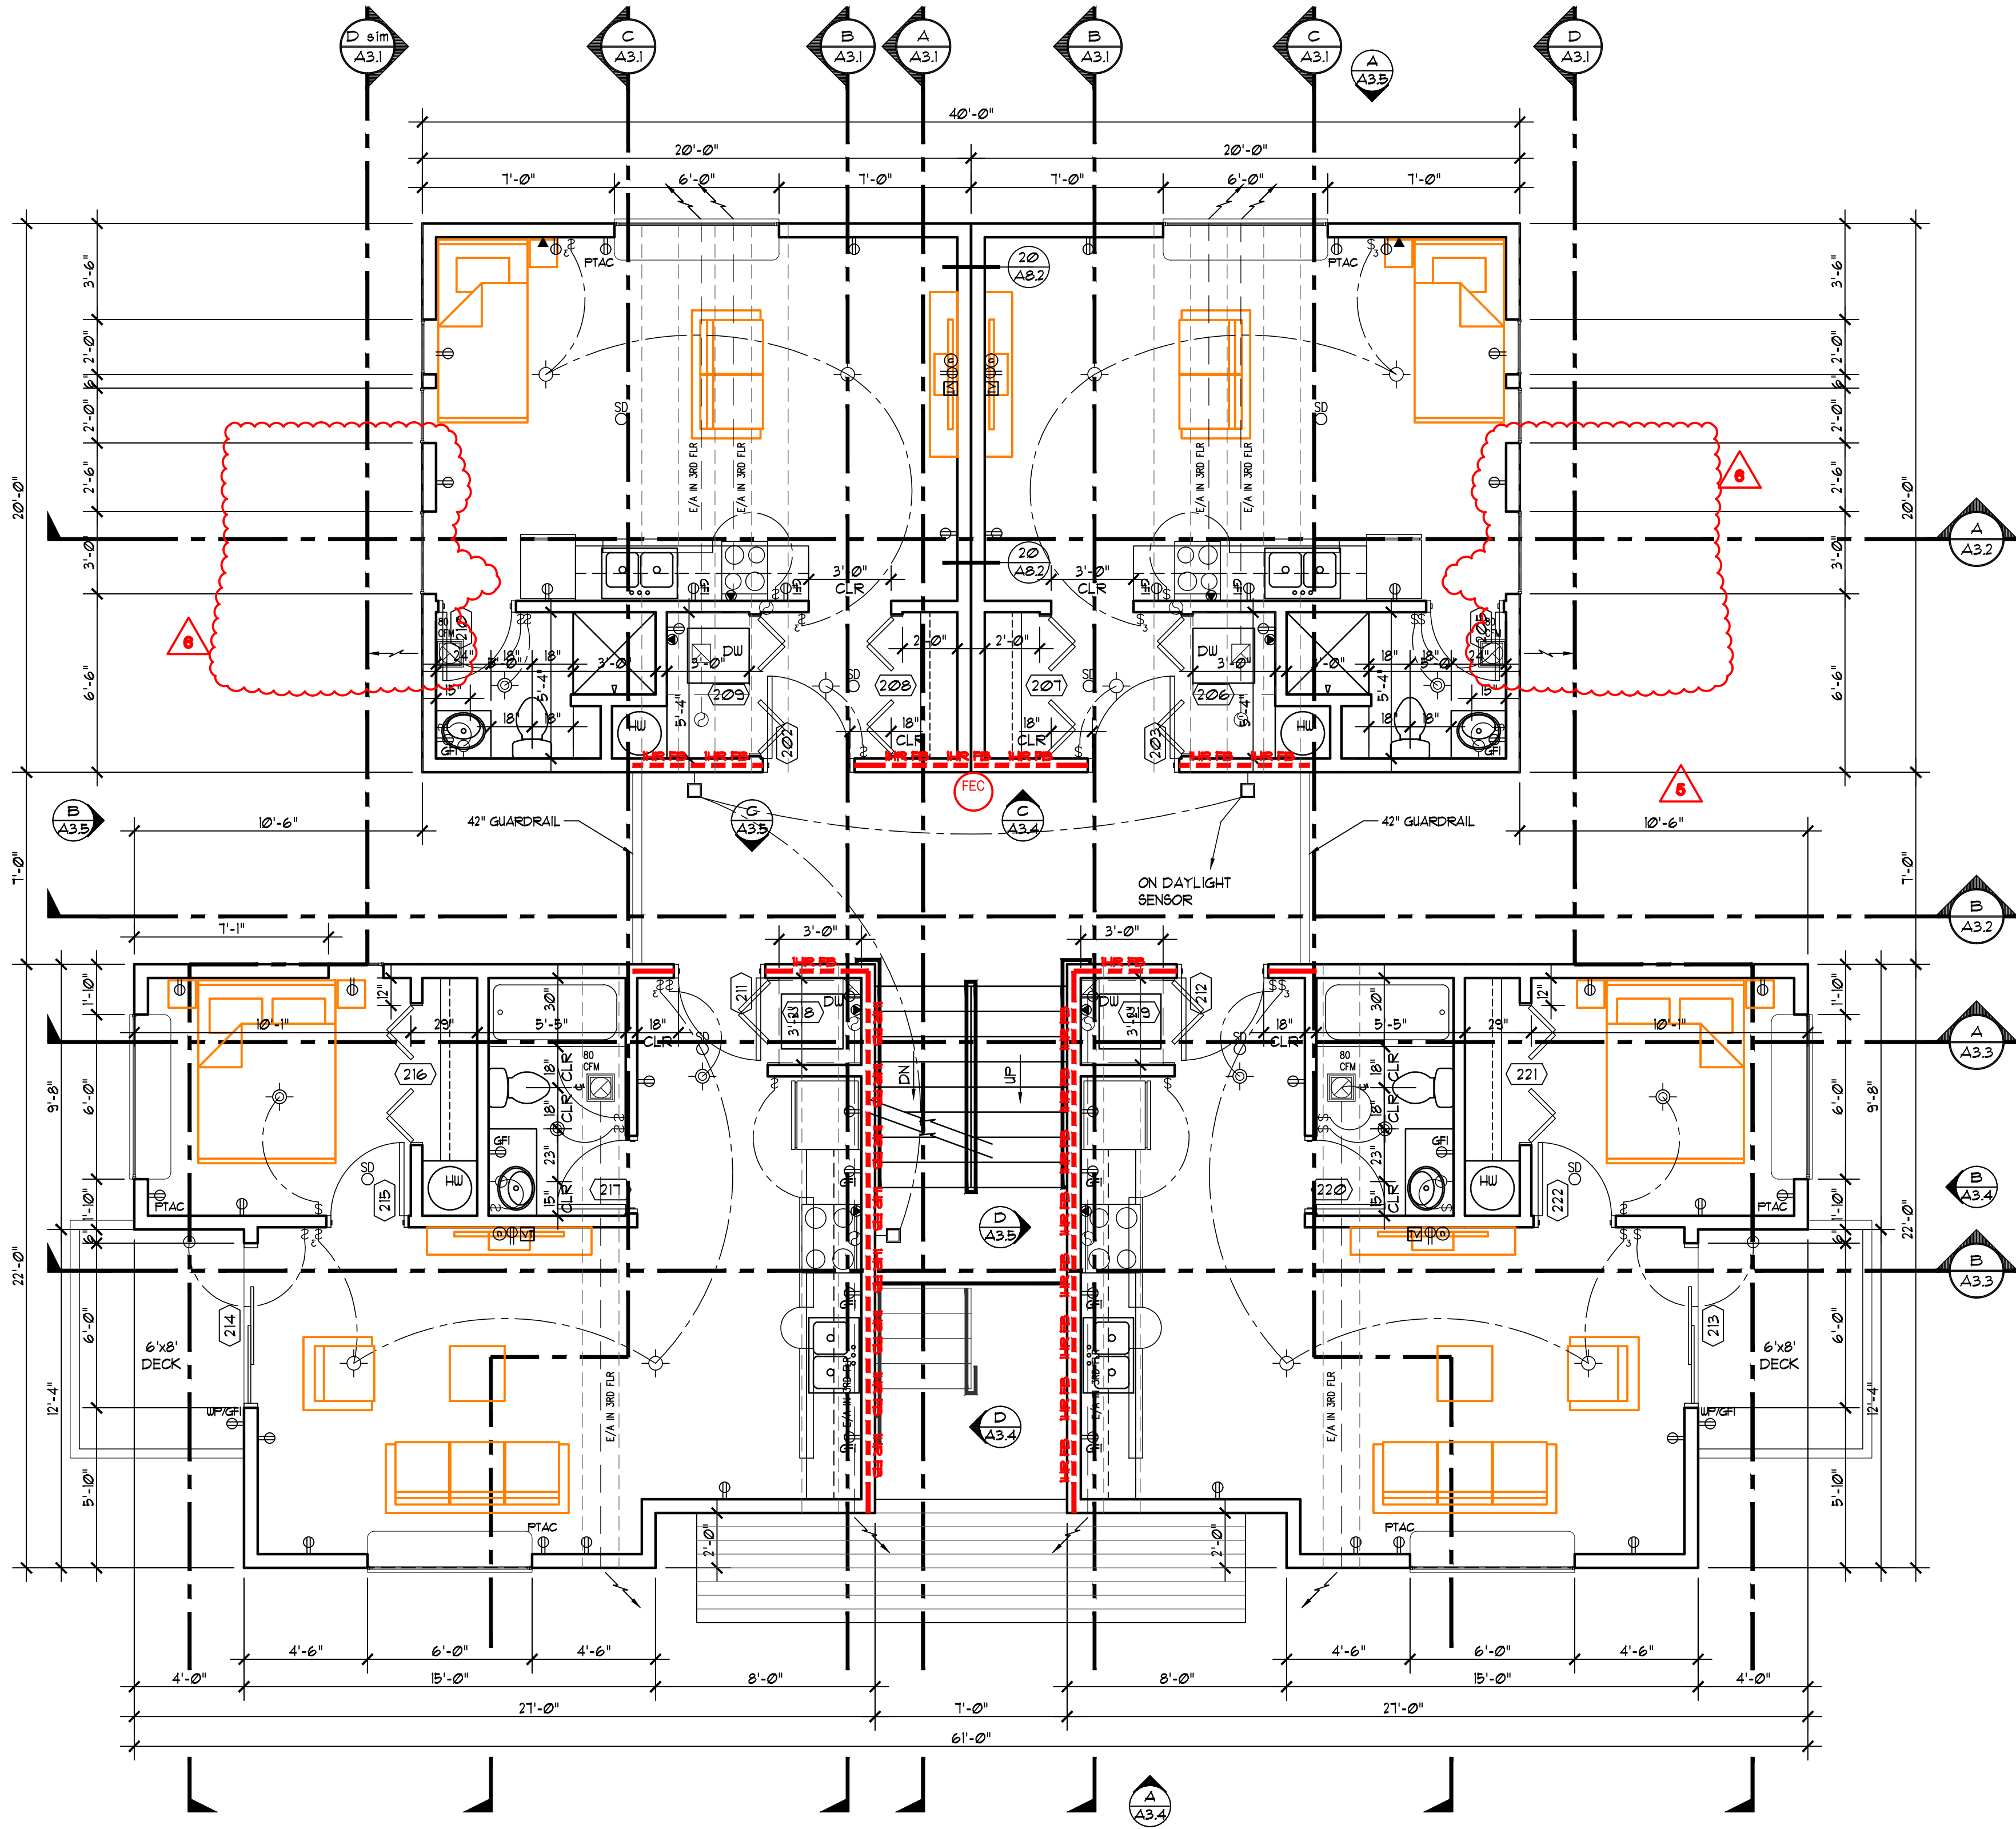

**PROPOSED
SECOND FLOOR PLAN**
SCALE : 1/4" = 1'-0"
**BUILDING "1349" SET
NORTH BUILDING**

DOOR SCHEDULE						
"ALL DOORS TO RECEIVE LEVER TYPE HARDWARE"		TYPE	CONSTR	FINISH	GLASS	RATING
NO.	SIZE					
201	NOT USED					
202	3'-0"x6'-8"x13/4"	B	HM	ME	-	20
203	3'-0"x6'-8"x13/4"	B	HM	ME	-	20
204	NOT USED					
205	3'-0"x6'-8"x13/4"	B	TYPI	TY	-	3
206	5'-0"x6'-8"x13/4"	E	TYPI	TY	-	1
207	5'-0"x6'-8"x13/4"	E	TYPI	TY	-	1
208	5'-0"x6'-8"x13/4"	E	TYPI	TY	-	1
209	5'-0"x6'-8"x13/4"	E	TYPI	TY	-	1
210	3'-0"x6'-8"x13/4"	B	TYPI	TY	-	3
211	3'-0"x6'-8"x13/4"	B	HM	ME	-	20
212	3'-0"x6'-8"x13/4"	B	HM	ME	-	20
213	6'-0"x6'-8"x13/4"	C	VIN	FF	-	1
214	3'-0"x6'-8"x13/4"	B	HM	ME	-	1
215	2'-8"x6'-8"x13/4"	B	TYPI	TY	-	4
216	5'-0"x6'-8"x13/4"	E	TYPI	TY	-	1
217	2'-6"x6'-8"x13/4"	B	TYPI	TY	-	3
218	3'-0"x6'-8"x13/4"	D	TYPI	TY	-	1
219	3'-0"x6'-8"x13/4"	D	TYPI	TY	-	1
220	2'-6"x6'-8"x13/4"	B	TYPI	TY	-	3
221	5'-0"x6'-8"x13/4"	E	TYPI	TY	-	1
222	2'-8"x6'-8"x13/4"	B	TYPI	TY	-	4



- GROUP 1
ALL HARDWARE BY MFR
- GROUP 2
1 LOCK
1 1/2 PR HINGES
THRESHOLD
WEATHER STRIP
- GROUP 3
1 PRIVACY LOCK
1 1/2 PR HINGES
1 WALL STOP
- GROUP 4
1 PRIVACY LOCK
1 1/2 PR HINGES
1 WALL STOP
- GROUP 5
1 LOCK
1 1/2 PR HINGES
1 CLOSER
SMOKE GASKET
THRESHOLD
WEATHER STRIP

SYMBOL KEY

SD	SMOKE DETECTOR HARDWIRED, WITH BATTERY BACKUP
DO	DUPLEX OUTLET
DO GFI	DUPLEX OUTLET GFCI
DO GFI WP	DUPLEX OUTLET GFCI / WATER PROOF
220	220 OUTLET
TV	TELEVISION CABLE CONNECTION
TO	TELEPHONE OUTLET
SPS	SINGLE POLE SWITCH
3WS	THREE WAY SWITCH
SMLF	SURFACE MOUNT LIGHT FIXTURE
EWMLF	EXTERIOR WALL MOUNT LIGHT FIXTURE ON DAYLIGHT SENSOR
KL	KITCHEN STRIP LIGHTING
LEF	LAUNDRY EXHAUST FAN
80 CFM	80 CFM FAN/LIGHT / ON TIMER SWITCH
150 CFM	150 CFM KITCHEN EXHAUST FAN

DOOR TYPES

1. " " SHOWN ON SCHEDULE INDICATES TYPICAL
2. DOOR TYPES
3. CONSTRUCTION
TYPICAL - SOLID CORE
HC - HOLLOW CORE
HM - HOLLOW METAL
MC - MINERAL CORE
RU - ROLL UP/COIL
AL - ALUMINIUM & GLASS
VIN-VINYL
4. MATERIAL/FINISH
TYPICAL - WOOD TRANSPARENT
WF - WOOD FACTORY
PL - PLASTIC LAMINATE
ME - METAL ENAMEL
WE - WOOD ENAMEL
FF - FACTORY FINISH
5. GLASS
TYPICAL - CLEAR WIRE
TP - TEMPERED PLATE
SF - SAFETY GLASS
6. 20, 45, 60, 90, INDICATES RATING IN MINUTES FOR OPENING
7. TYPICAL FRAMES SHOWN " " NUMBER INDICATES DETAIL SHOWN ON SHEET.
8. NUMBER REFERS TO HARDWARE GROUP OF HARDWARE SCHEDULE

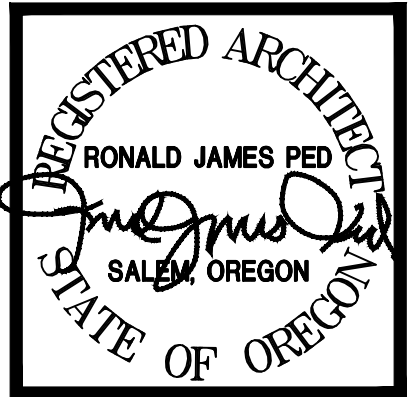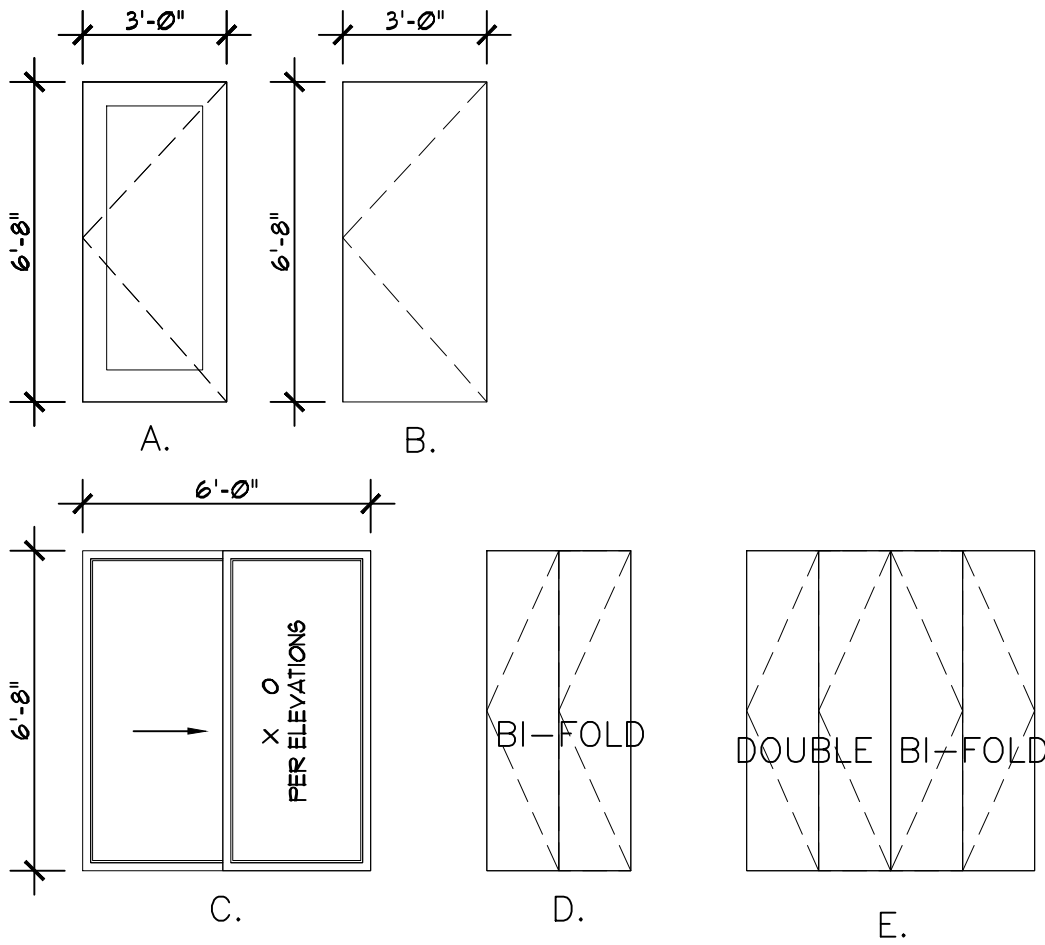

1. 13 MARCH 2023
6PR COMMENTS
2. 9 FEB. 2024
CITY OF SALEM COMMENTS
3. 9 FEB. 2024
REVIEW COMMENTS
4. 28 MAR. 2024
CITY OF SALEM COMMENTS
5. 14 JUNE 2024
EGRESS STAIR CHANGE
6. 3 JULY 2024
CHANGE OFFICE TO STUDIO 207
4 REMOVAL OF STUDIO BALCONIES

NEW APARTMENTS FOR-
SE
Waller St SE
1349 Waller St Salem, Or

DATE: 20 APRIL 2022
DRAWN:
JOB NO.: 2207

A2.2

CONSTRUCTION SET 04.29.2024