




LAST SAVED: Tue, 16 Jul 2024 - 11:34 am
PRINTED BY: Tue, 16 Jul 2024 - 11:40 am
LOCATION: C:\Users\trevo\appdata\local\temp\AcPublish_21152\A2.1_BldgB-1349.dwg
A3.5
trevo

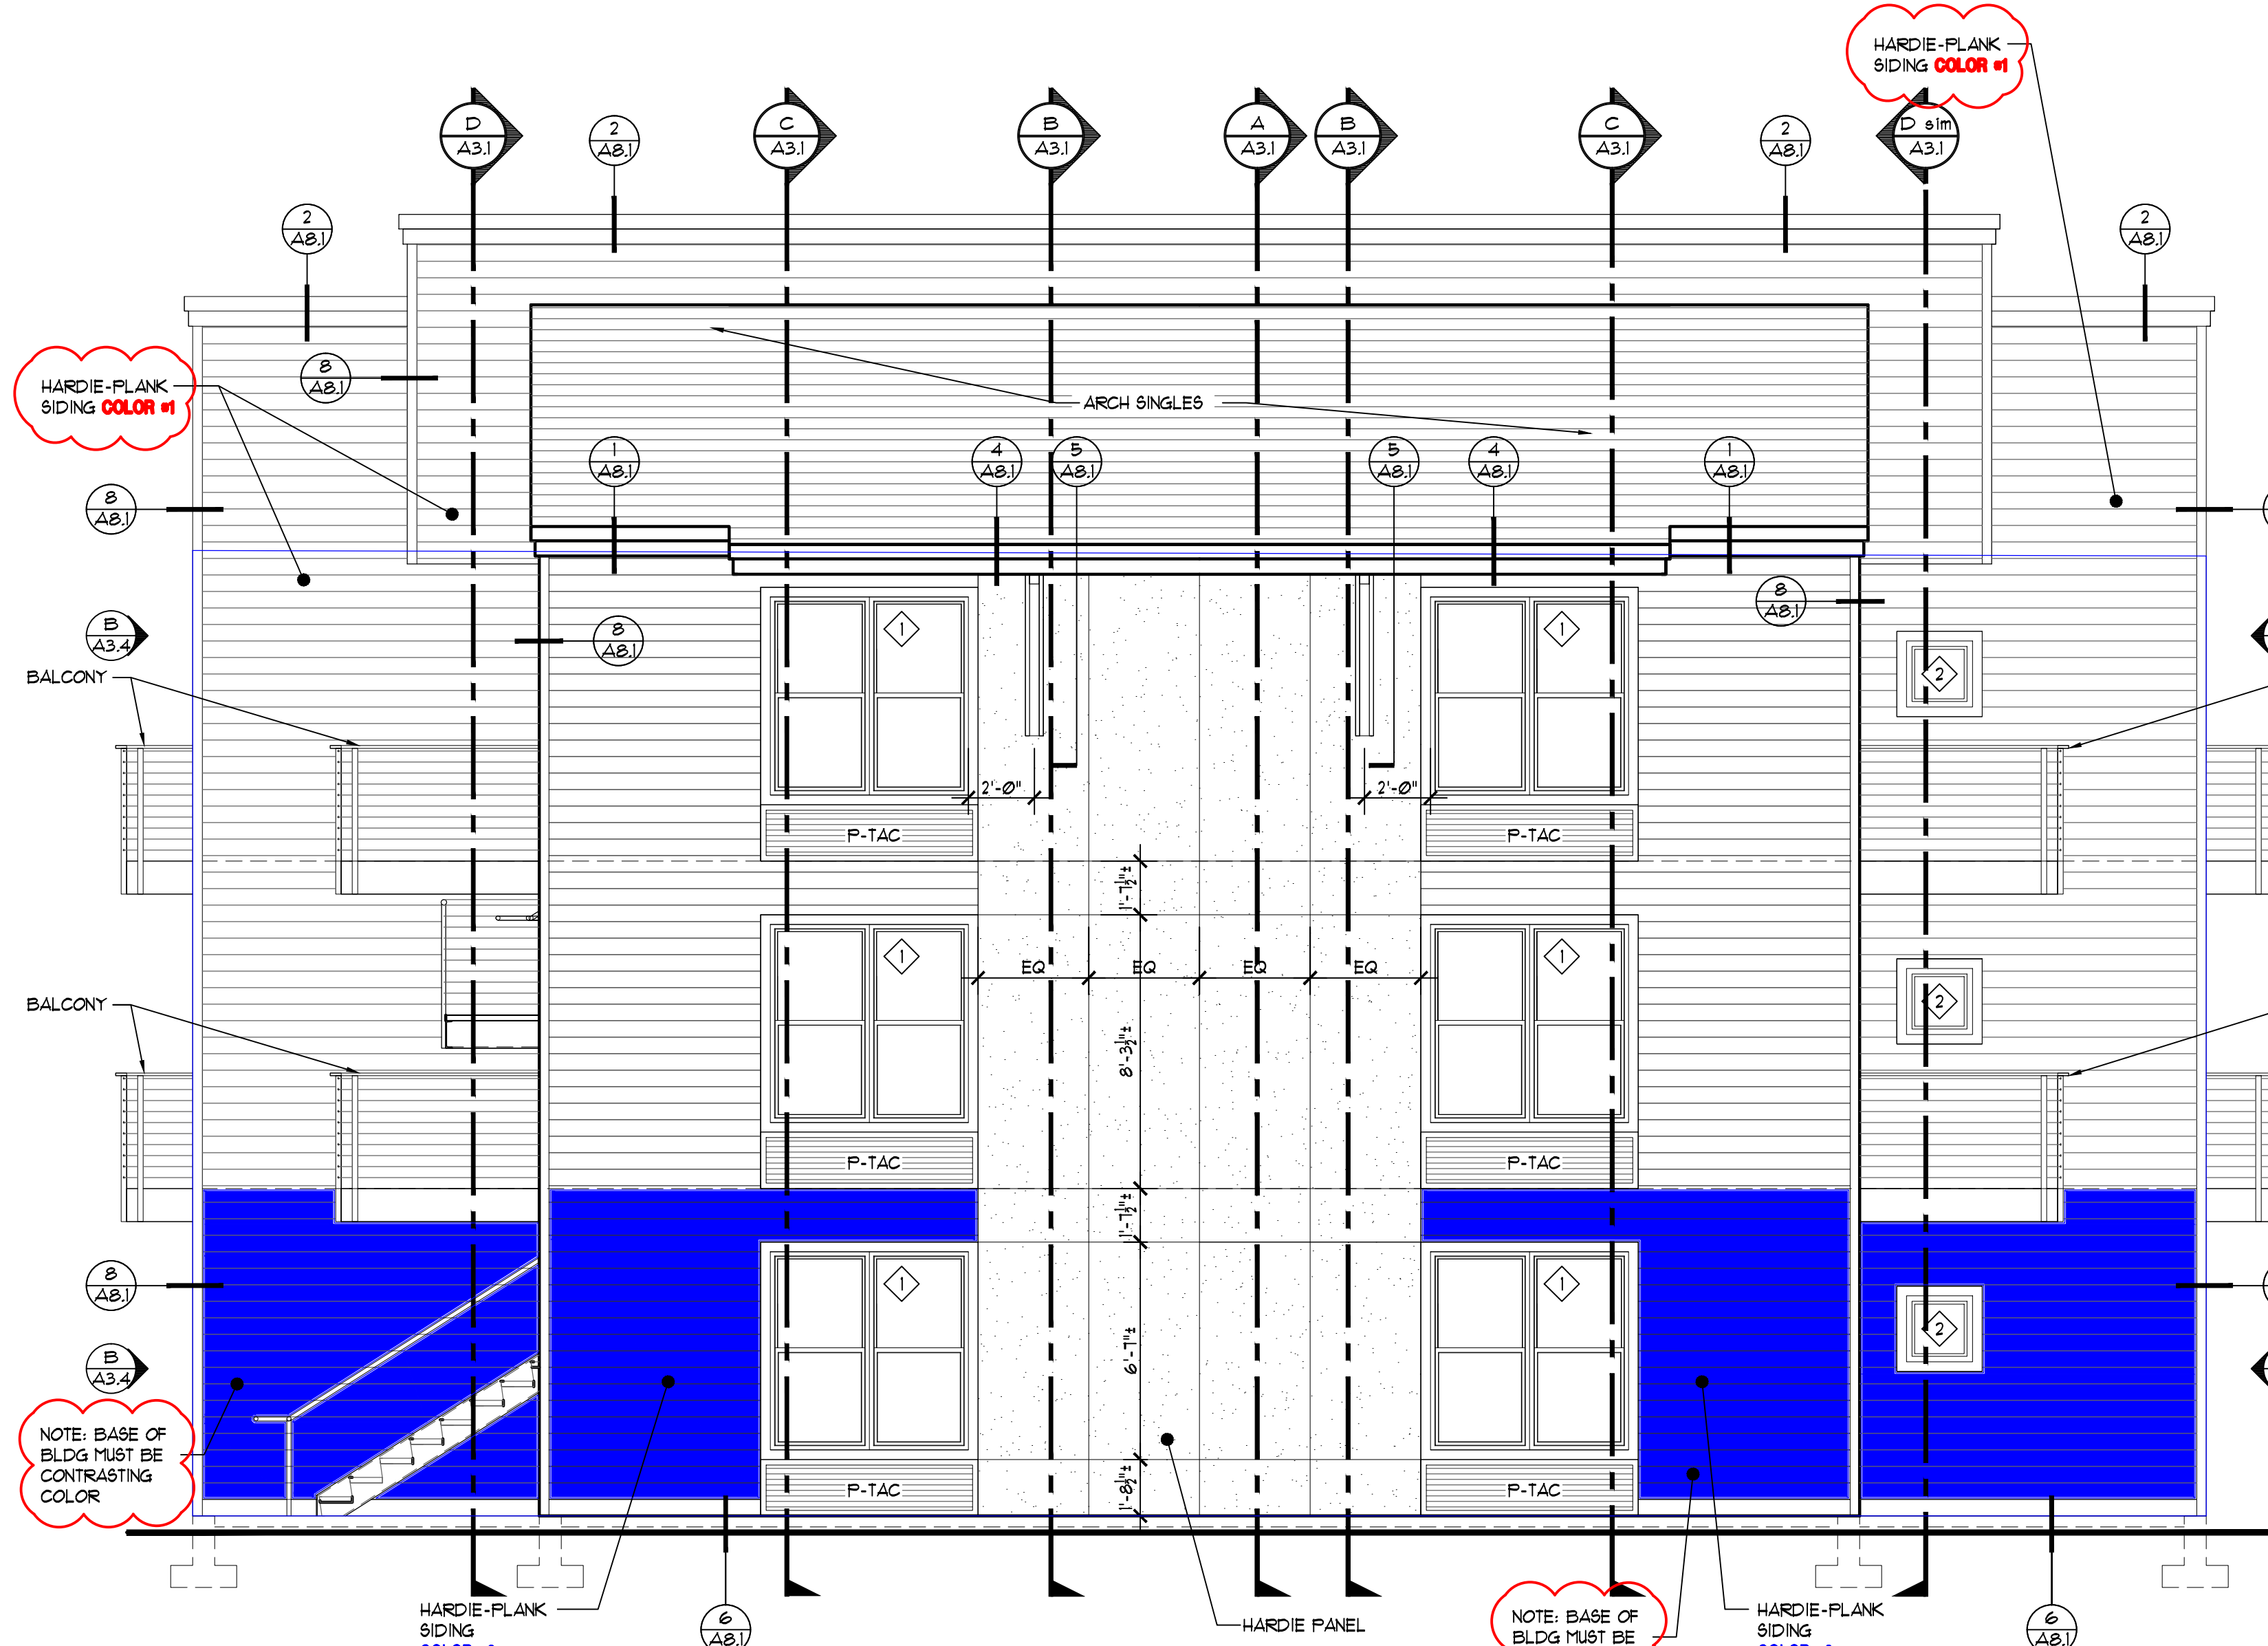


**NORTH-BUILDING "B"
WEST ELEVATION**
SCALE: 1/4" = 1'-0"

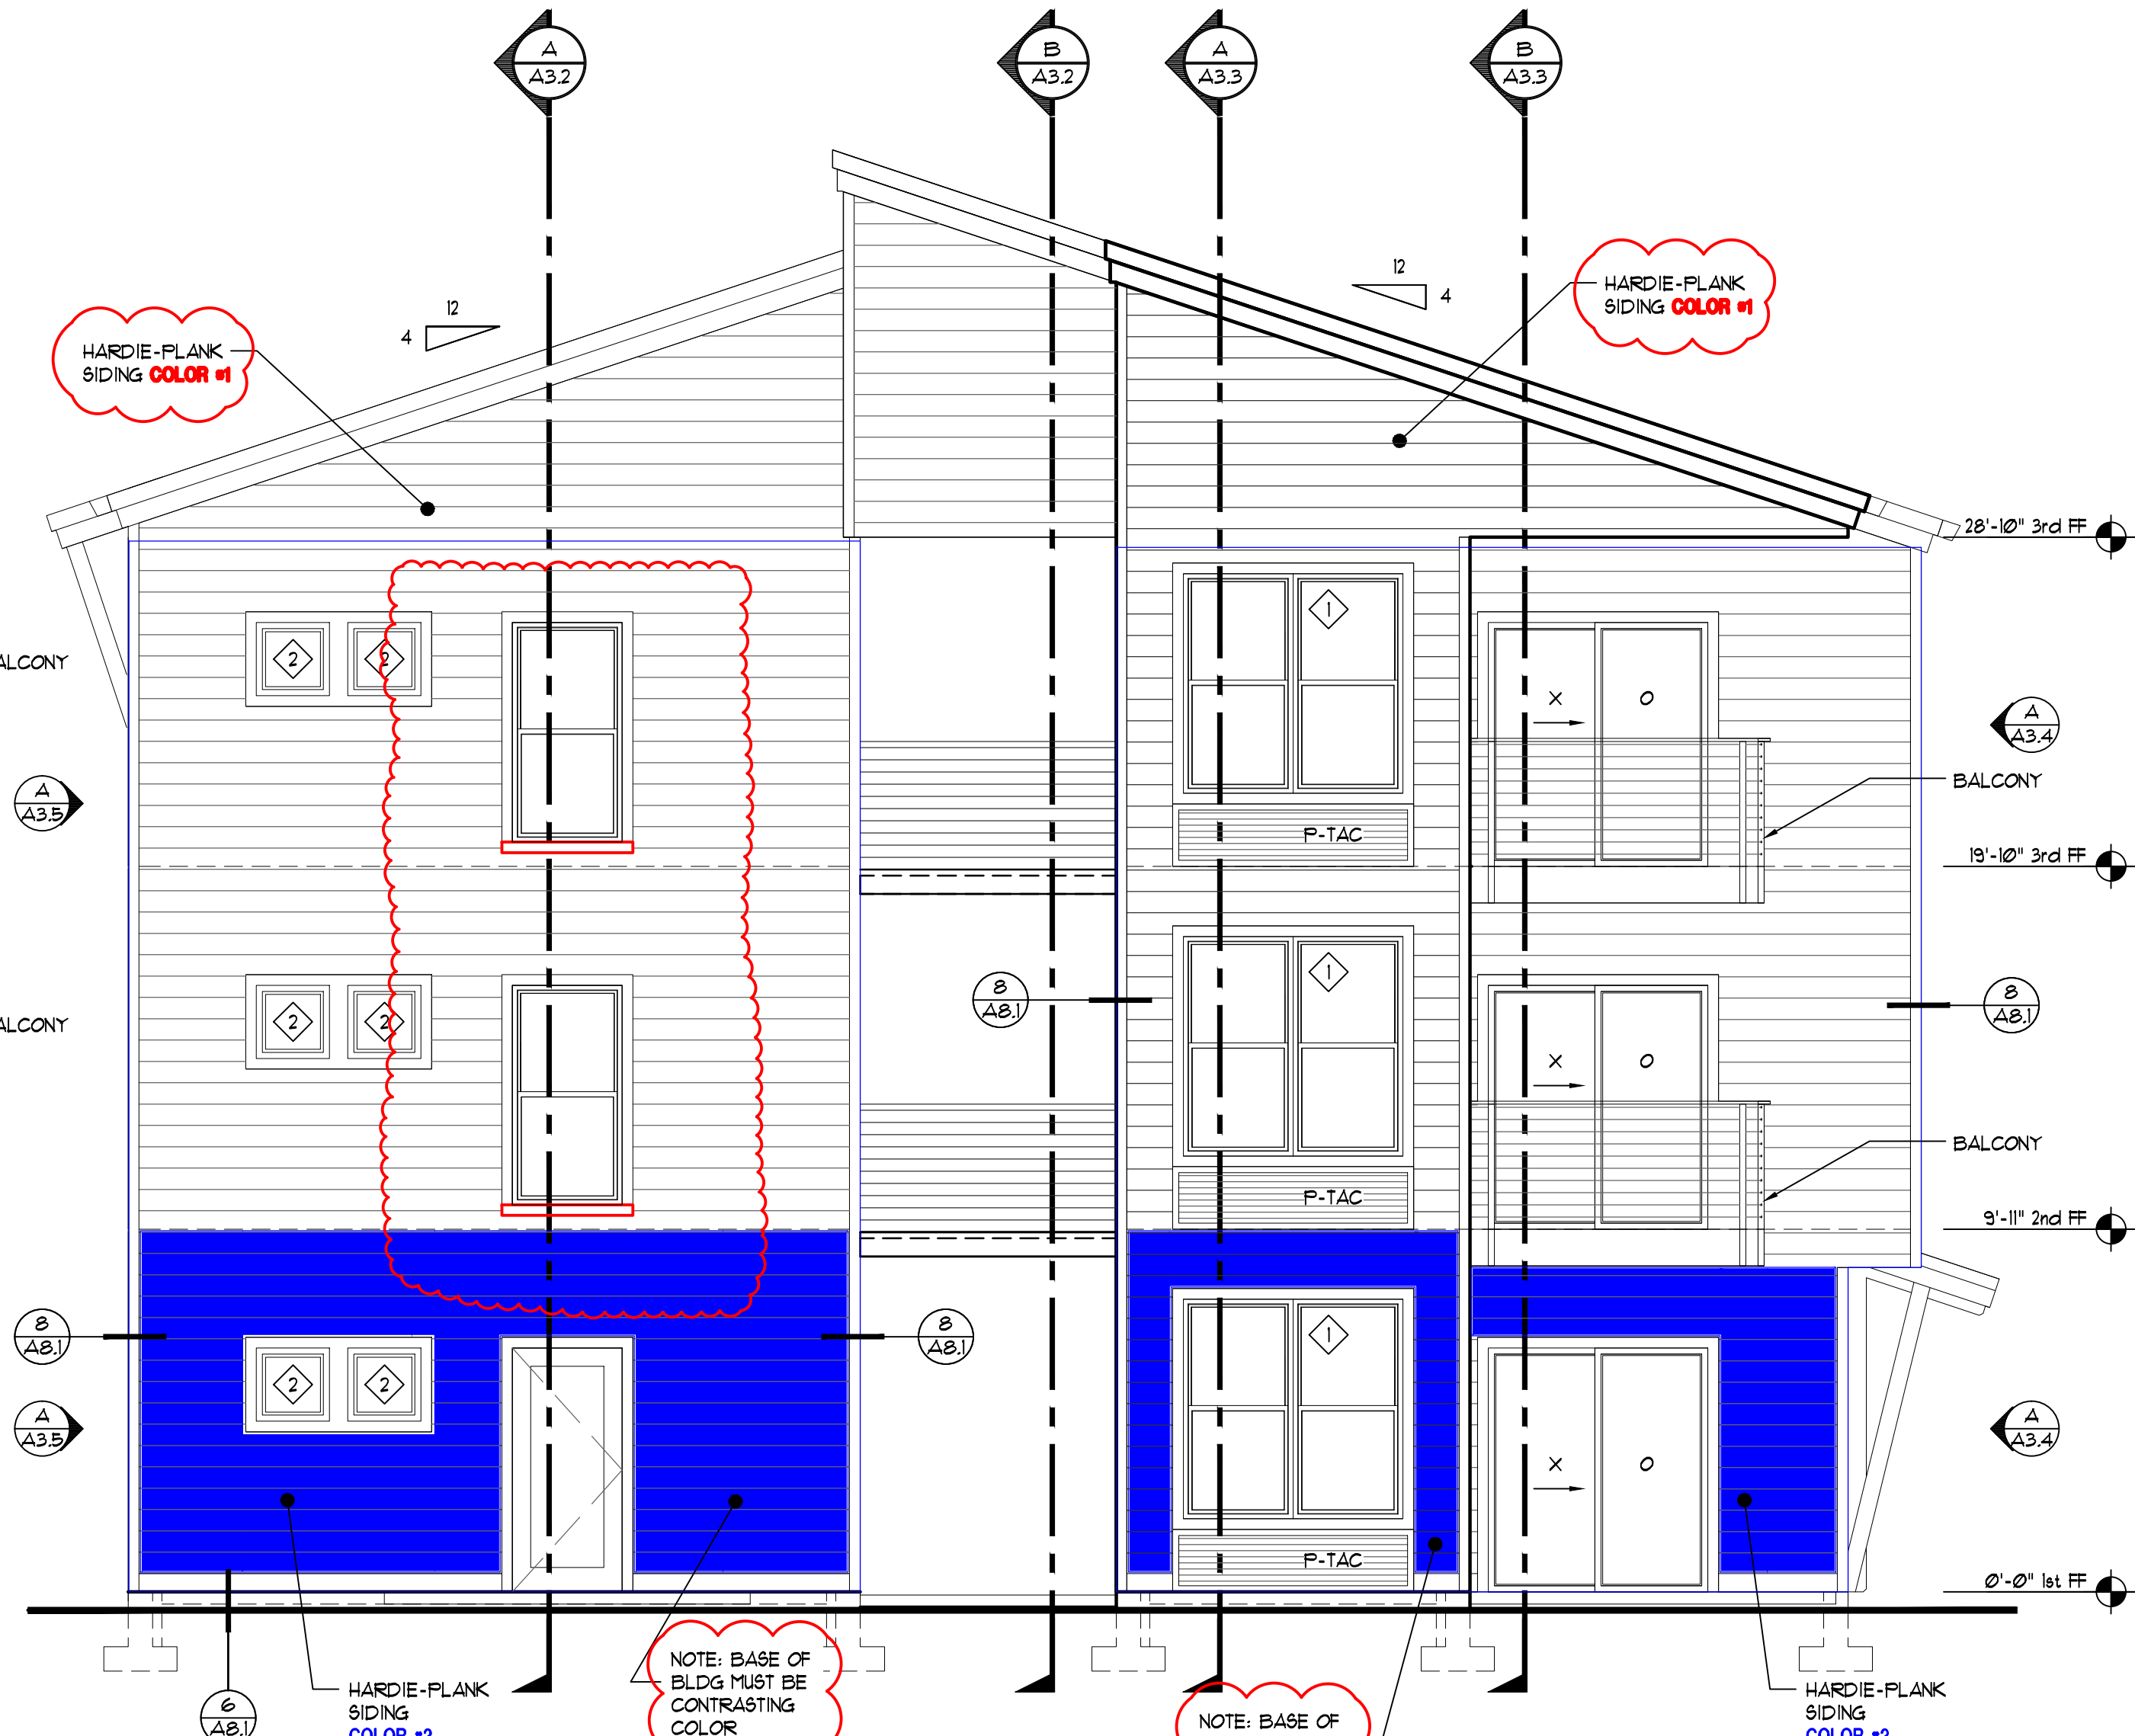


**NORTH-BUILDING "B"
SOUTH ELEVATION**
SCALE: 1/4" = 1'-0"

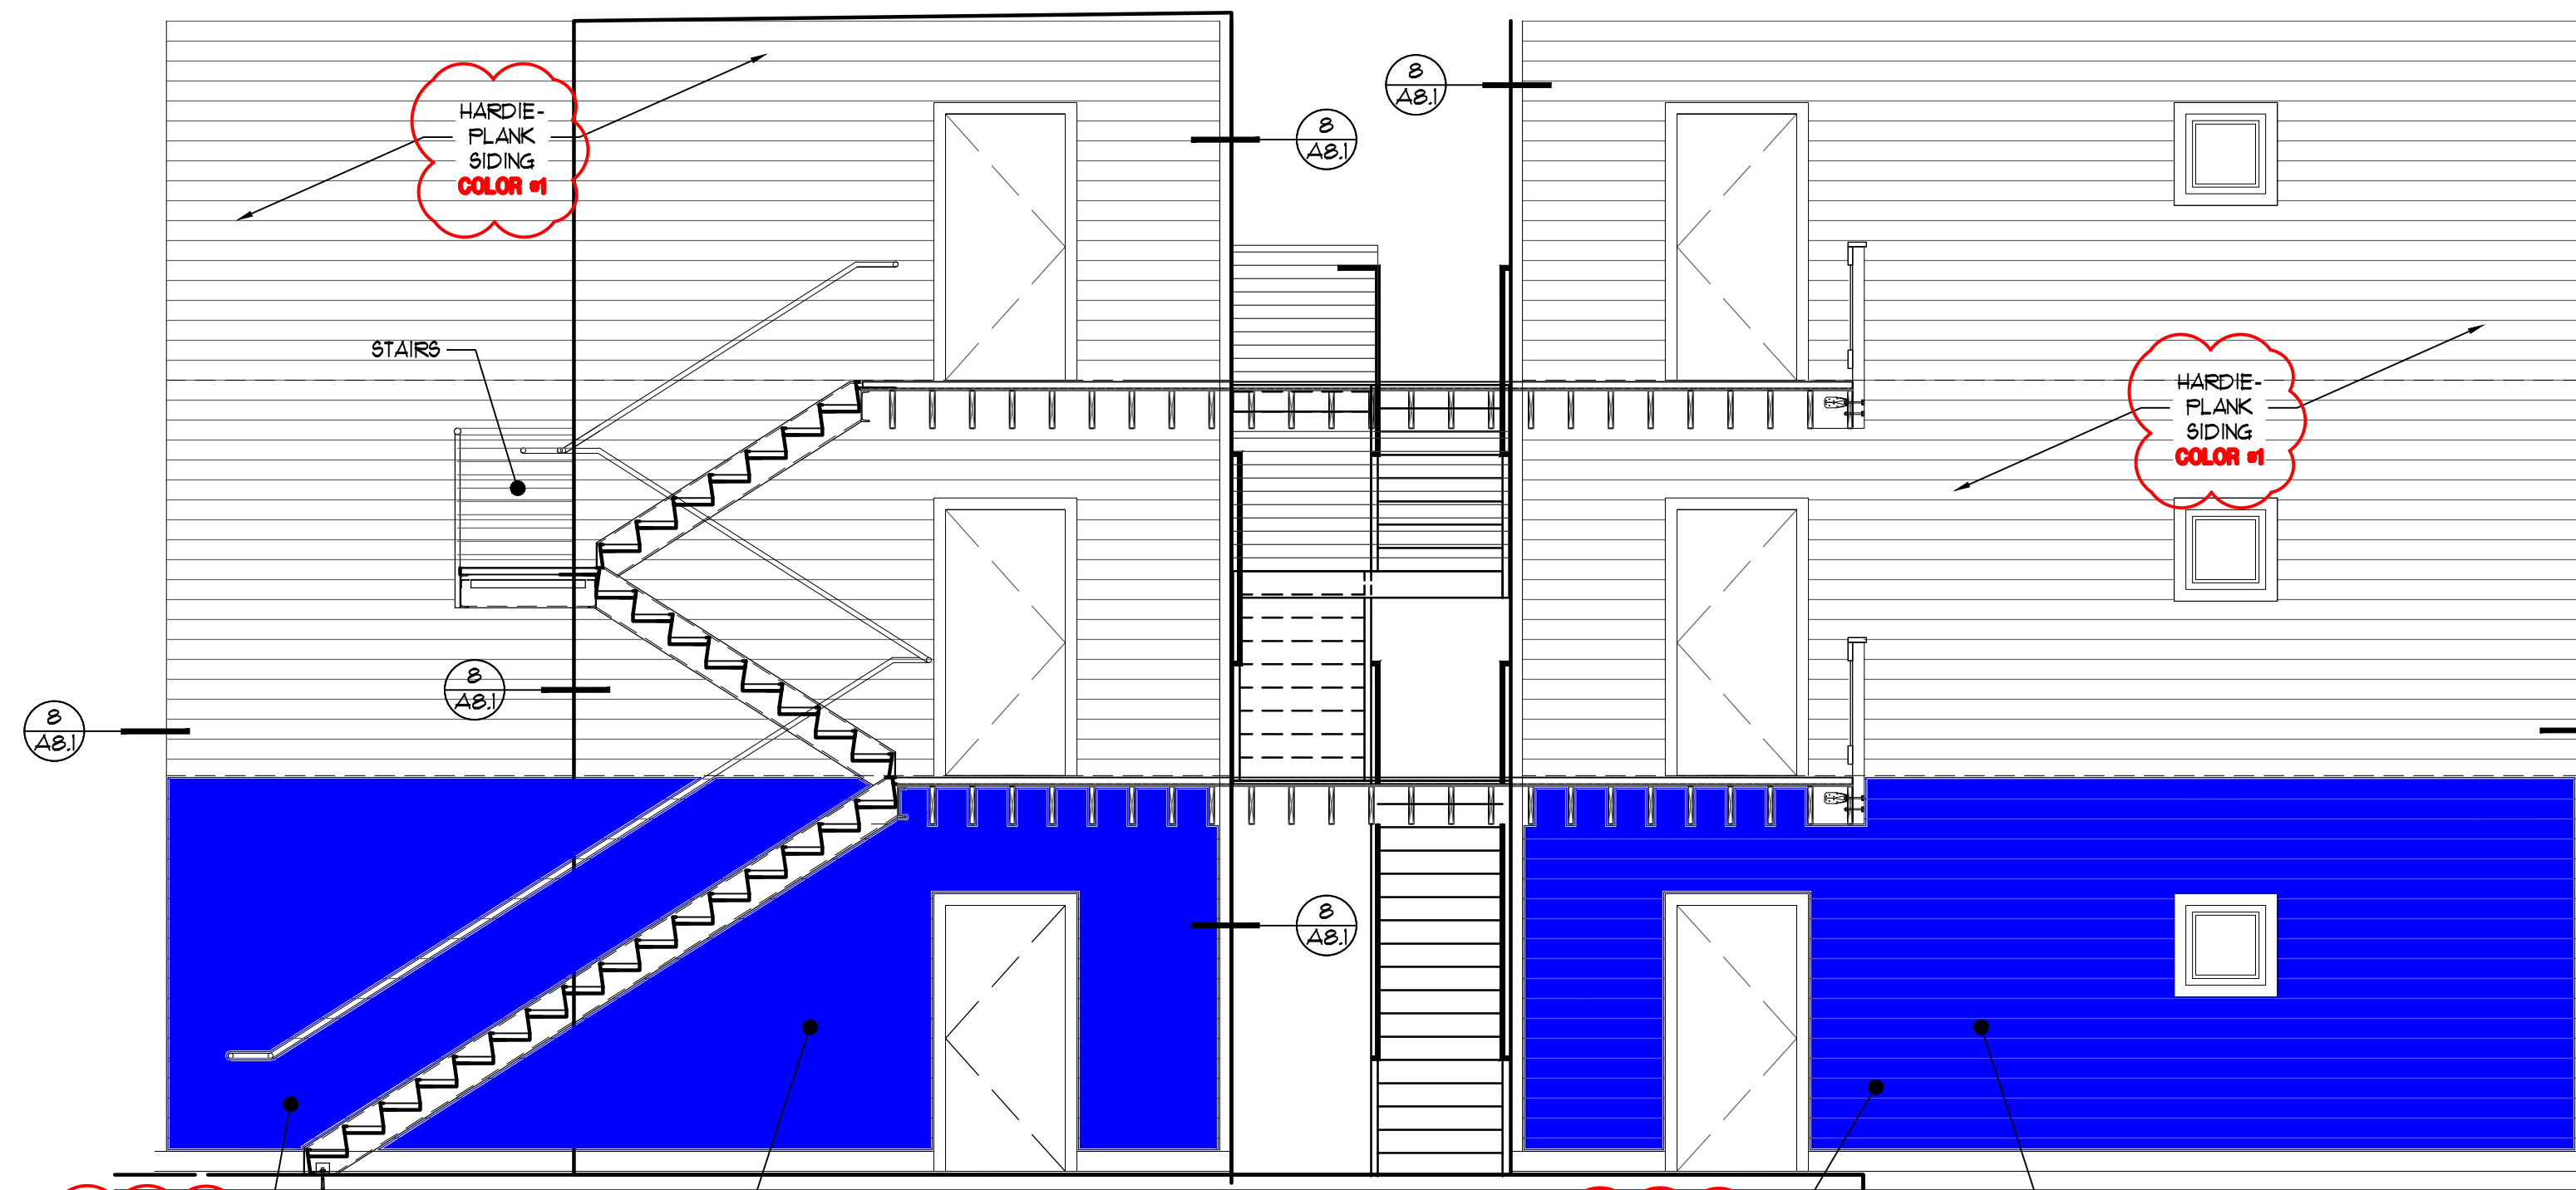


INTERIOR ELEVATION
SCALE: 1/4" = 1'-0"

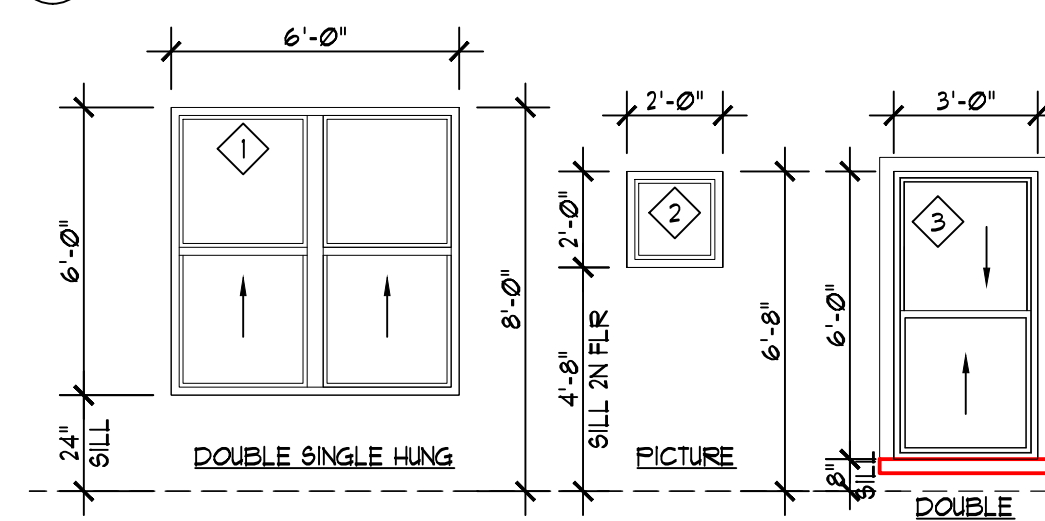

WINDOW TYPES
SCALE: 1/4" = 1'-0"

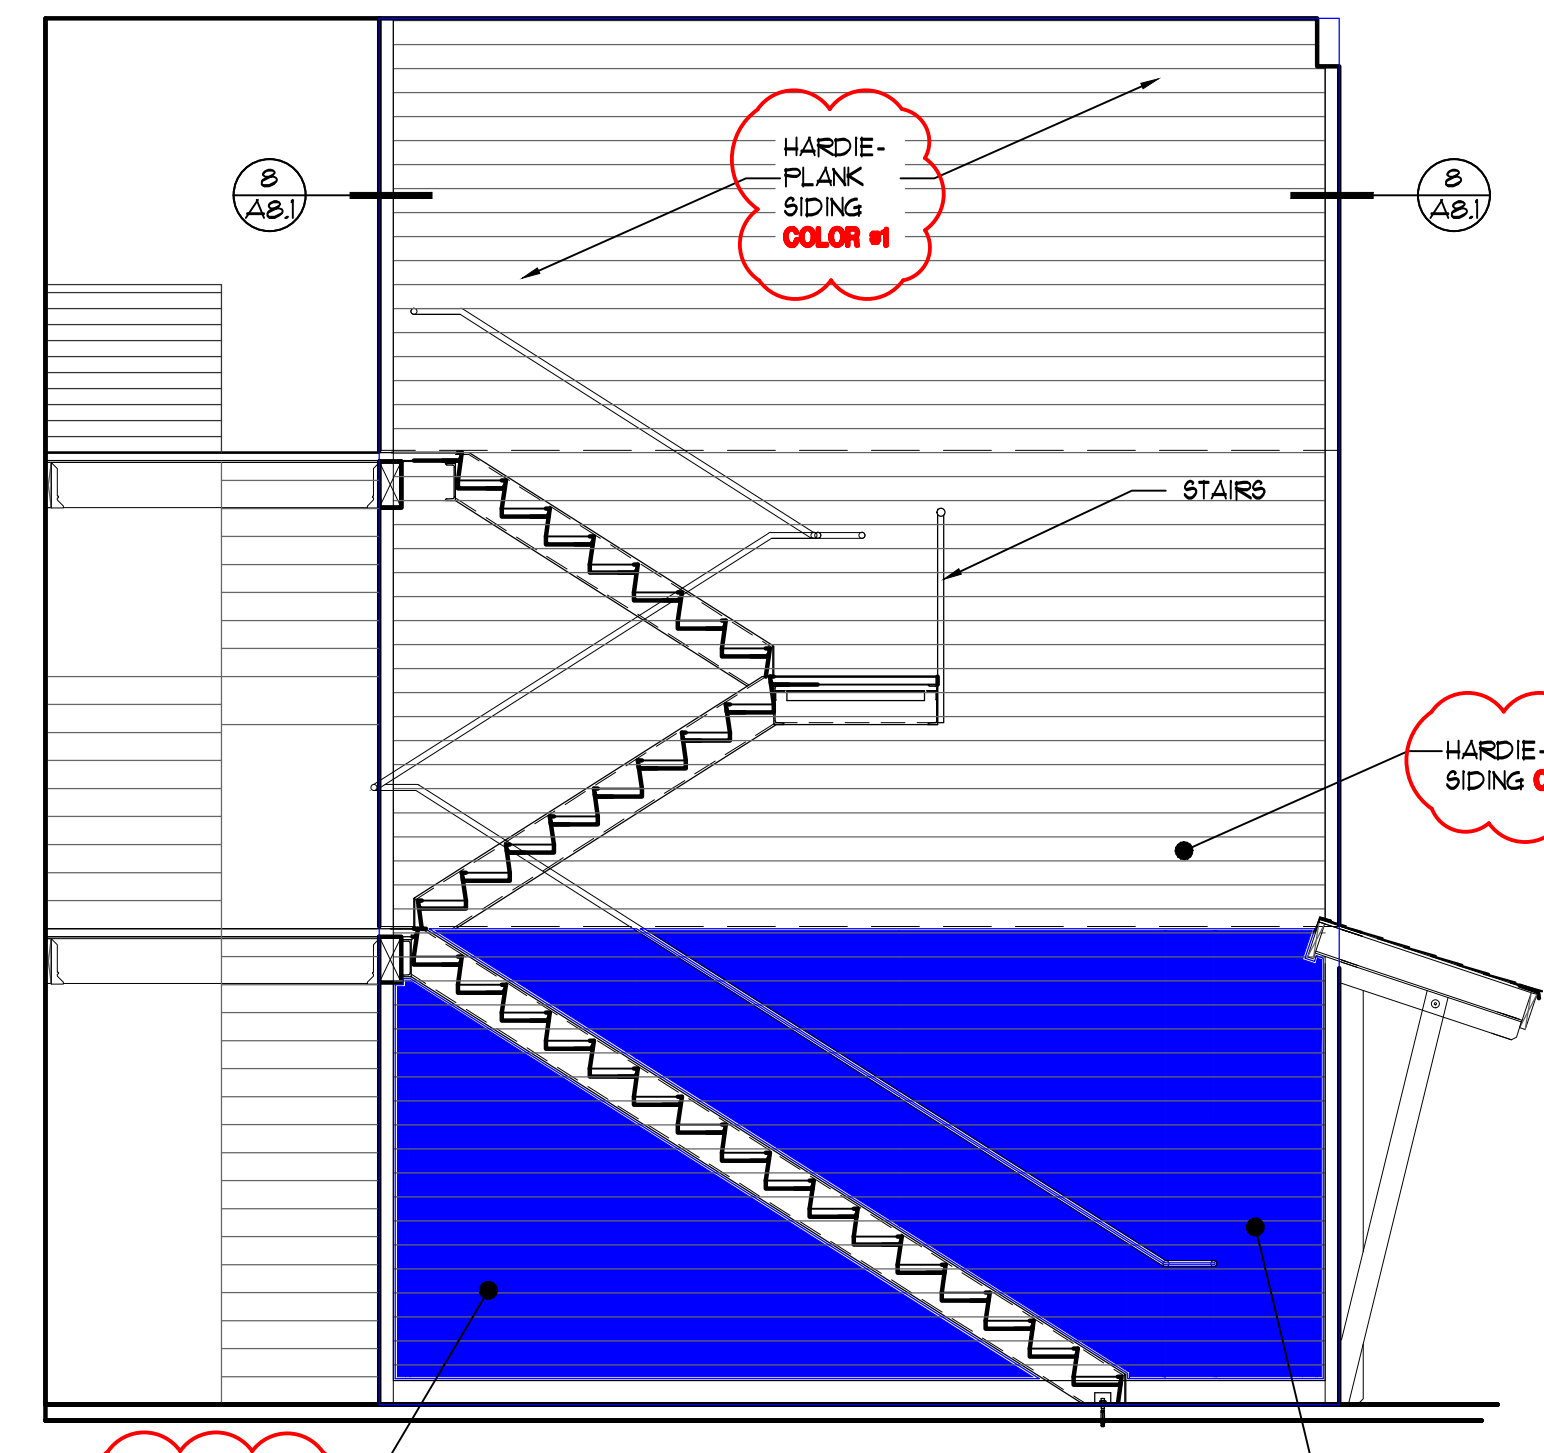

INTERIOR ELEVATION
SCALE: 1/4" = 1'-0"

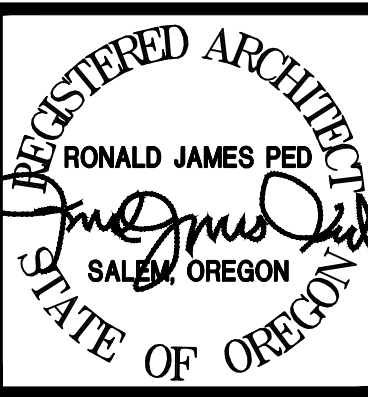

- 1 13 MARCH 2023 6PR COMMENTS
- 2 9 FEB. 2024 CITY OF SALEM COMMENTS
- 3 9 FEB. 2024 REVIEW COMMENTS
- 4 28 MAR. 2024 CITY OF SALEM COMMENTS
- 5 14 JUNE 2024 EXPRESS STAIR CHANGE
- 6 3 JULY 2024 CHANGE OFFICE TO STUDIO 224
4 REMOVAL OF STUDIO BALCONIES

NEW APARTMENTS FOR
Waller St SE
1349 Waller St Salem, Or

DATE: 20 APRIL 2022
DRAWN: JOB NO. 2207

A3.5

CONSTRUCTION SET 04.29.2024