
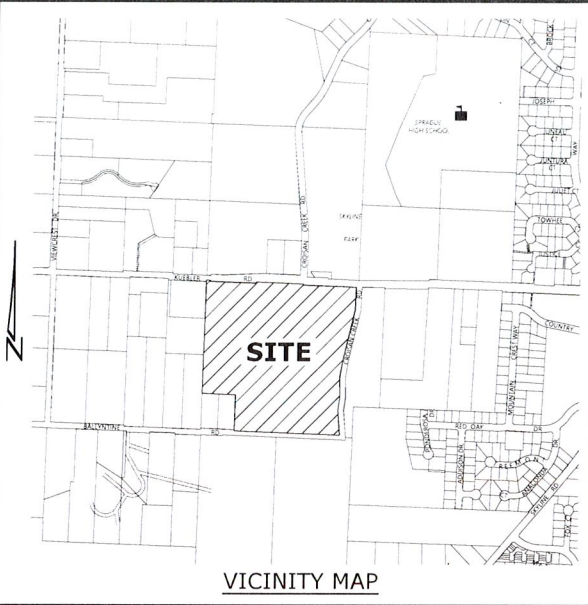


Owner/Developer:
COMFORT HOMES, L.L.C.
P.O. BOX 5607
CITY, OREGON 97304

KUEBLER PARTITION


SEC. 17, T. 8 S., R. 3 W., W.M.
CITY OF SALEM
MARION COUNTY, OREGON
3 PARCELS - 34.23 ACRES

PROPOSED PARTITIONING

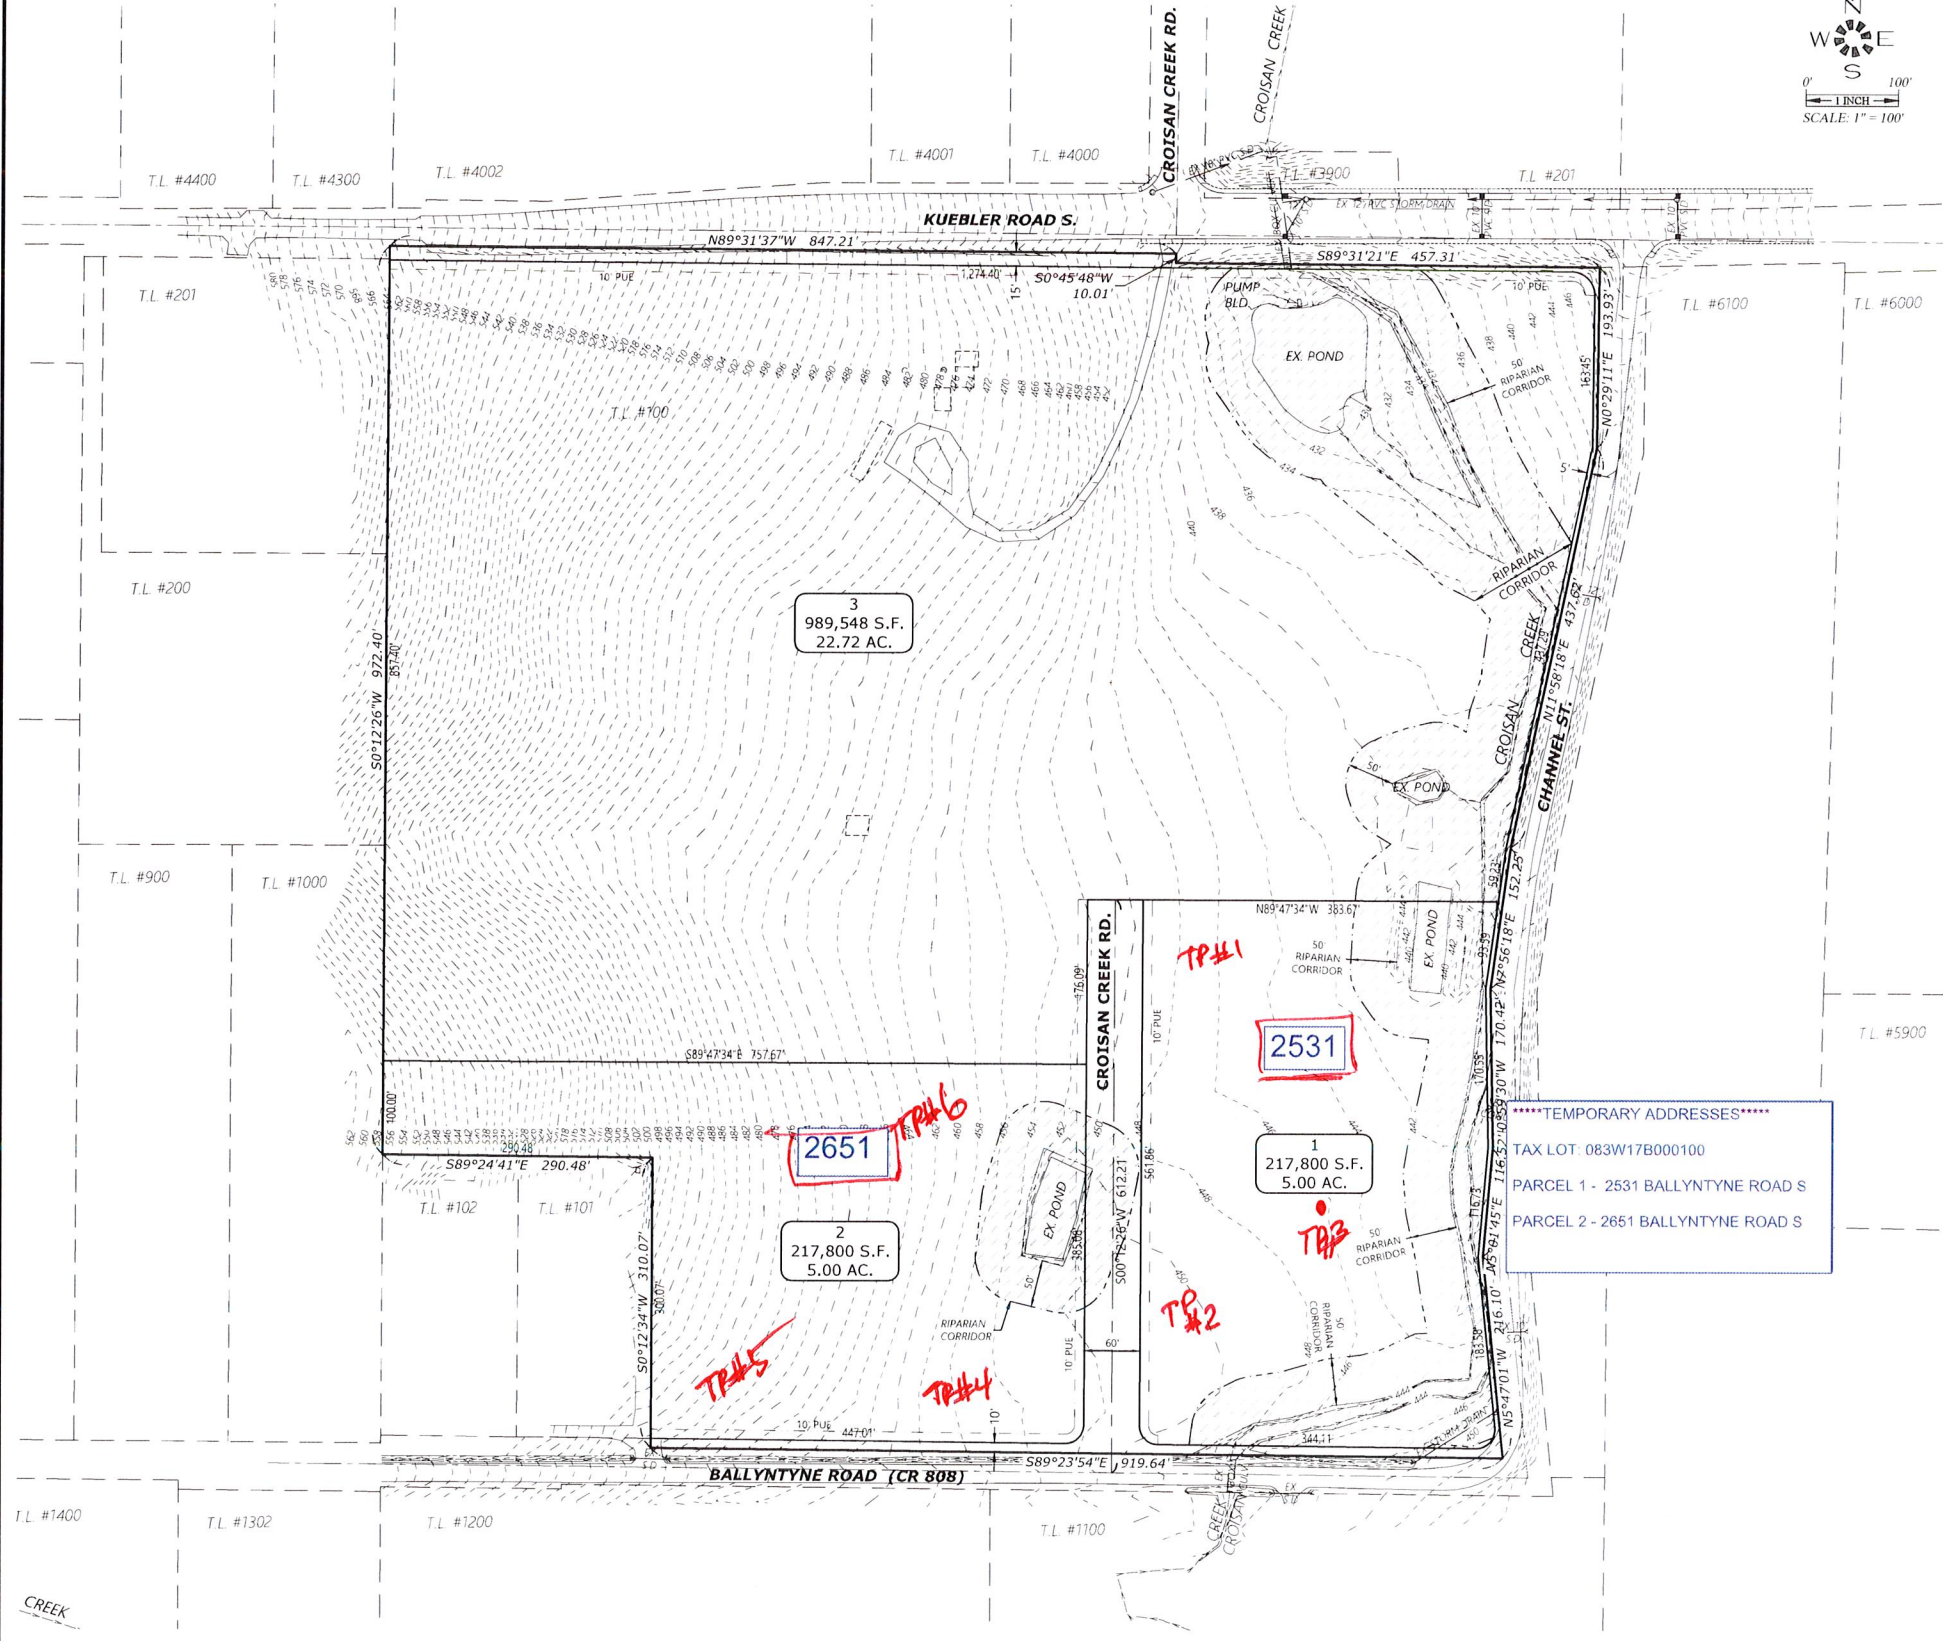

T.B.M. 444.79
RIM ELEVATION OF EXISTING STORM DRAIN MANHOLE AT THE INTERSECTION OF KUEBLER BLVD. AND CROISAN CREEK DR. BASED ON BENCH MARK DESIGNATED 3070 BEING A BRASS DISK LOCATED AT THE INTERSECTION OF JUSTICE WAY & CROISAN SCENIC WAY ON THE SOUTH SIDE OF JUSTICE WAY IN THE CENTER ISLAND. 1.20' SOUTH OF NORTH TIP OF ISLAND. ELEV.: 530.660 (NAVD 29)

SHEET INDEX	
P1	PARTITIONING PLAN
P2	SHADOW PLAN
P3	TREE PLAN
P4	GRADING PLAN

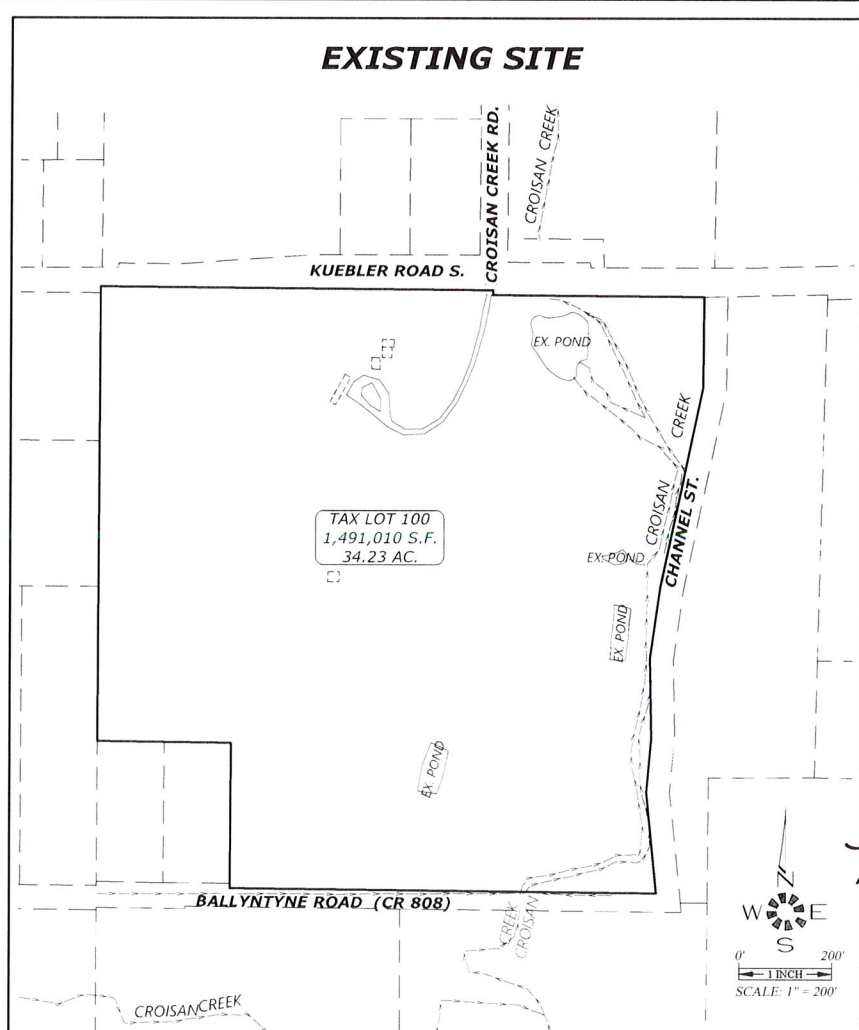

MULTI/TECH
ENGINEERING SERVICES, INC.
1155 13TH ST. S.E. SALEM, OR 97302
PH: (503) 363-9227 FAX: (503) 364-1260
www.mtengineering.com office@mtengineering.com

PARTITIONING PLAN

KUEBLER PARTITION

NO CHANGES, MODIFICATIONS OR REPRODUCTIONS TO BE MADE TO THESE DRAWINGS WITHOUT THE WRITTEN AUTHORIZATION OF THE DESIGN ENGINEER.
DIMENSIONS & NOTES TAKE PRECEDENCE OVER GRAPHICAL REPRESENTATION.

Design: M.D.G.
Drawn: D.G.G.
Checked: M.D.G.
Issue Date: 11/5/24
Scale: AS SHOWN
As-Built: -----

REGISTERED PROFESSIONAL ENGINEER
JULY 1978
EXPIRES 06-30-2025
JOB # 7651