



Owner / Developer:

Northstar Communities L.L.C.

9550 S.E. CLACKAMAS Rd.
CLACKAMAS, OREGON 97015

NORTHSTAR

SEC. 32, T. 6 S., R. 2 W., W.M.
CITY OF SALEM
MARION COUNTY, OREGON

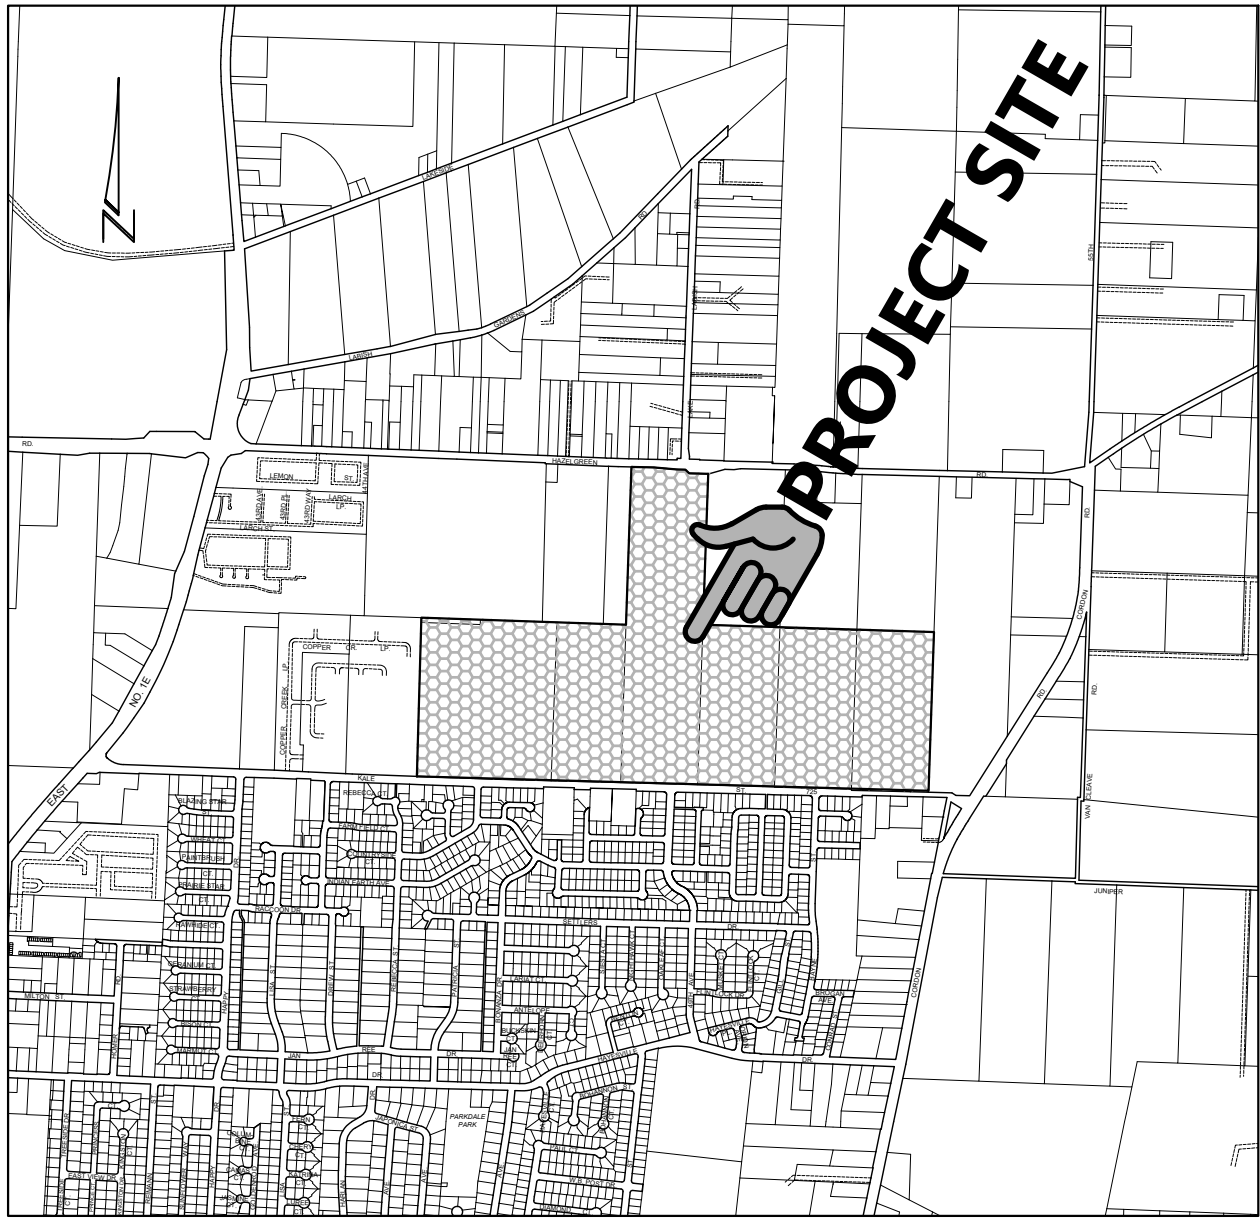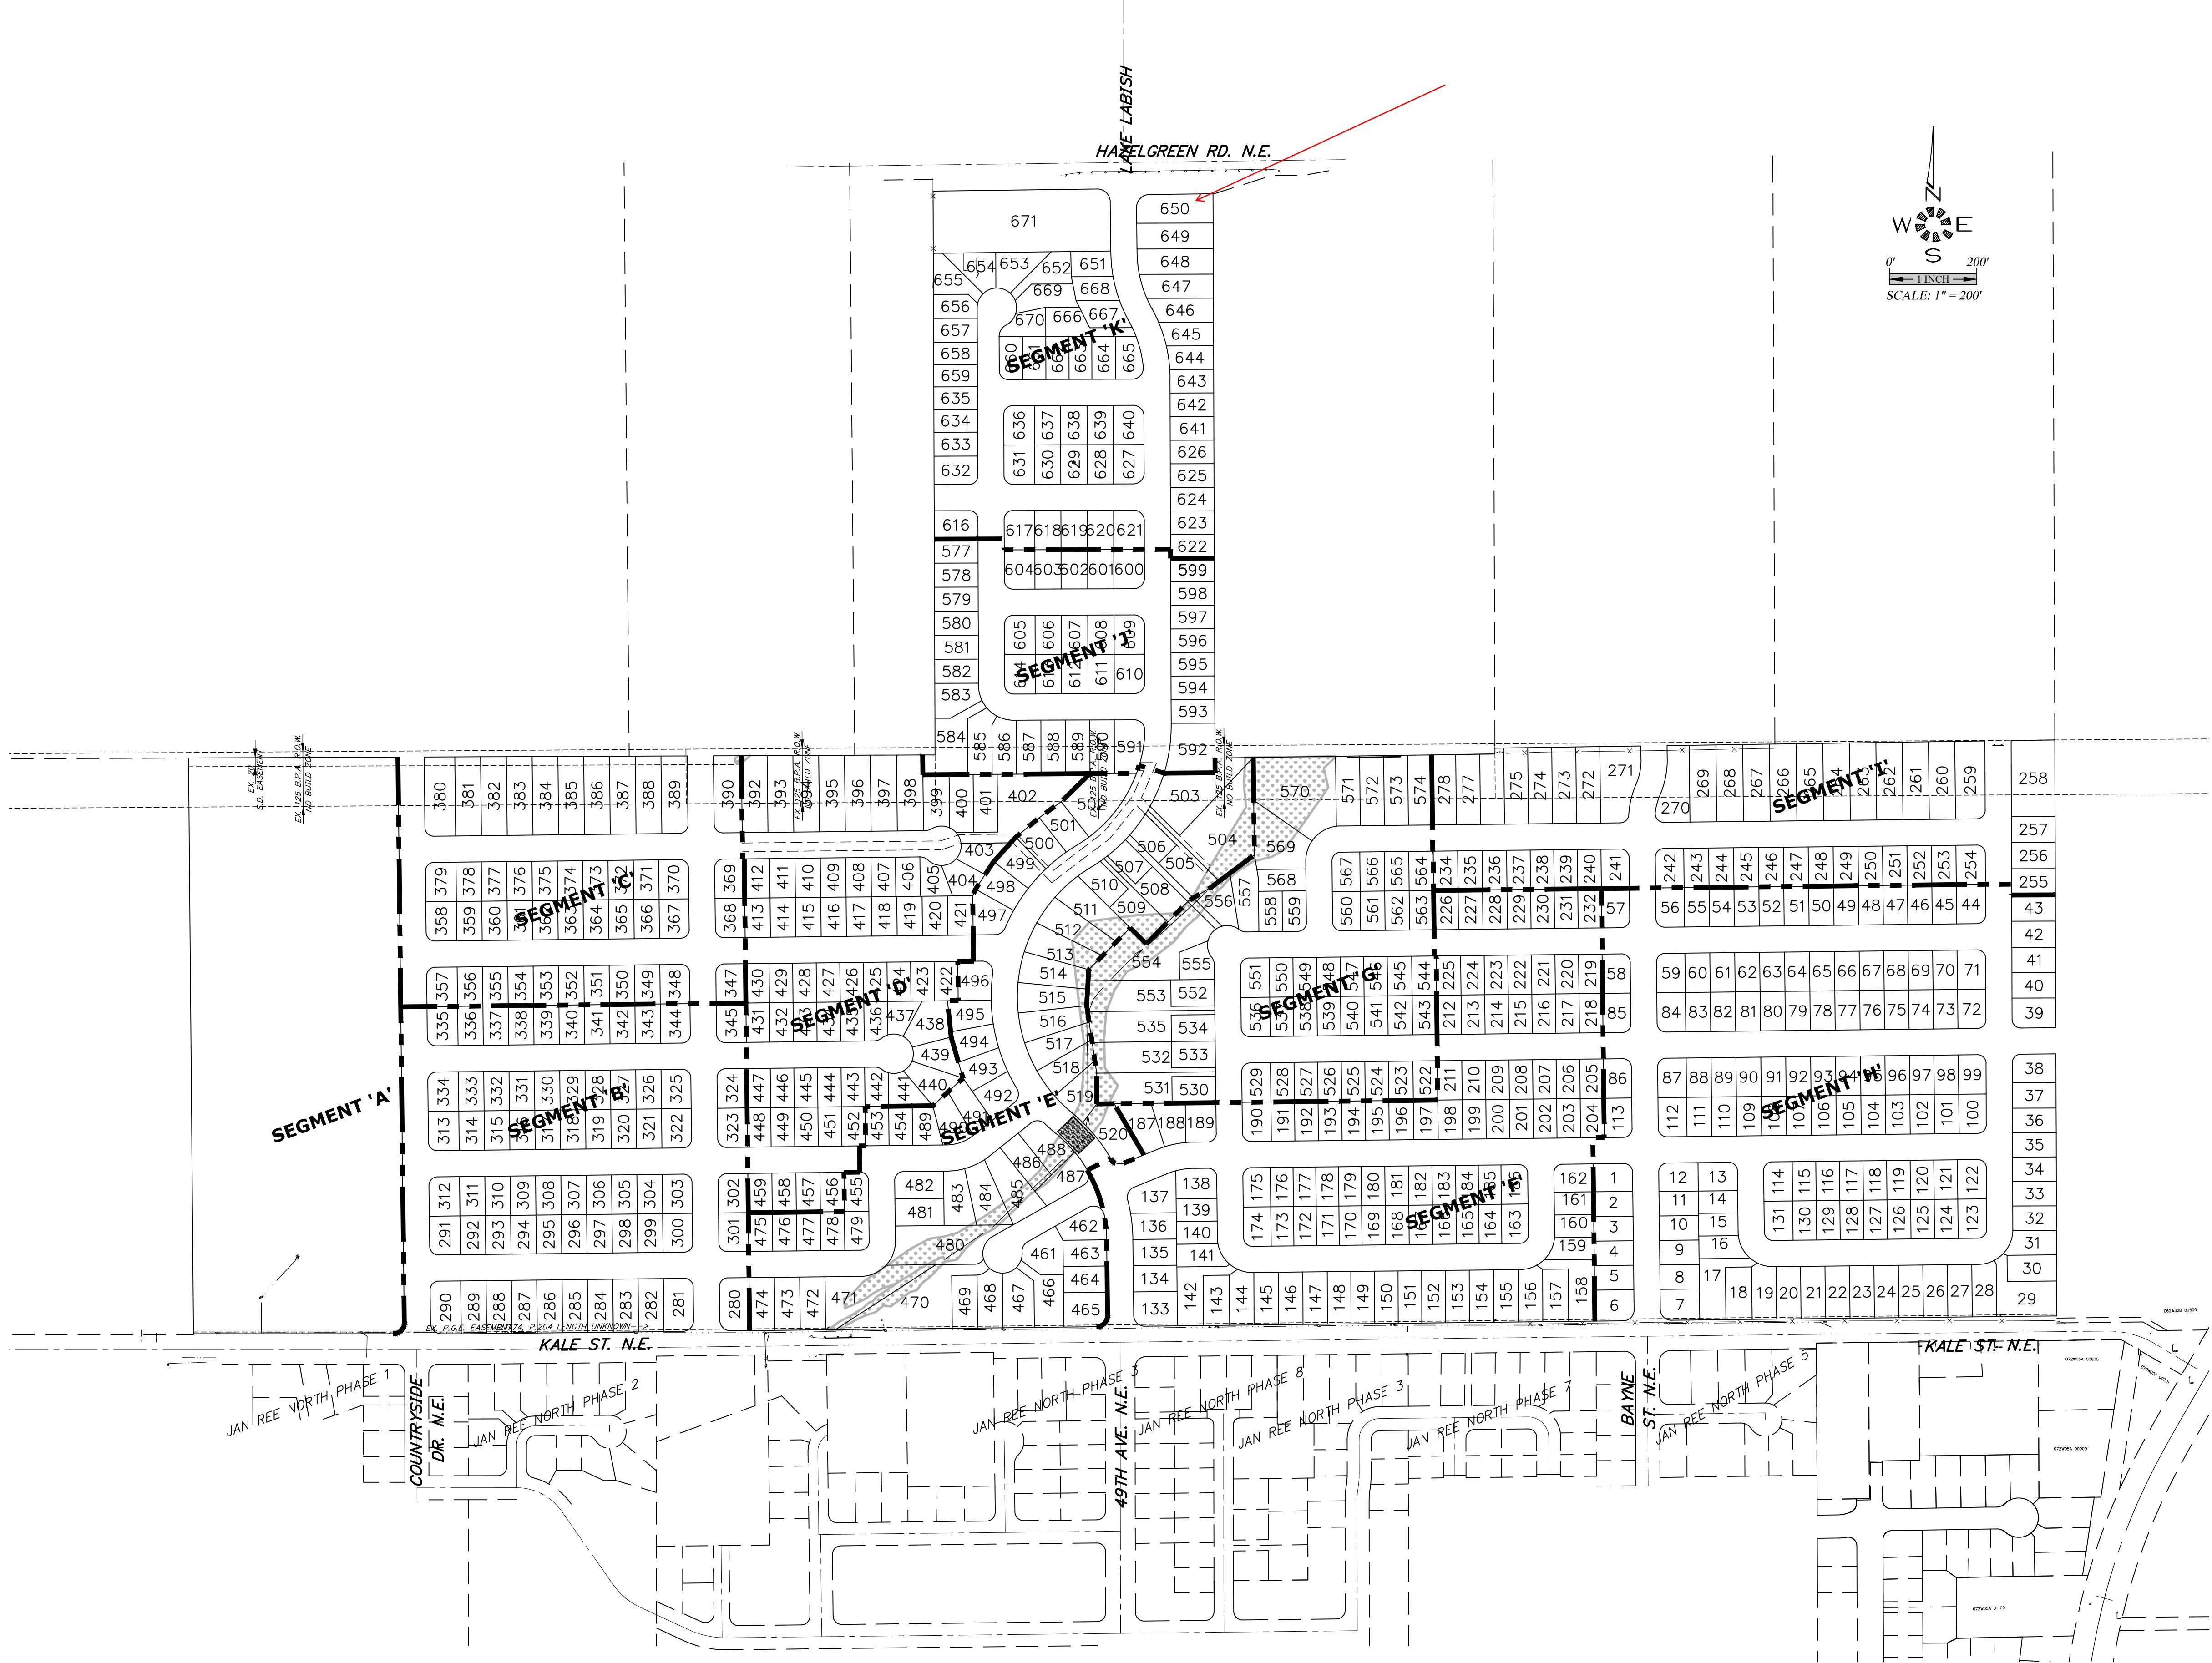

NUMBER OF LOTS BY SEGMENT		
SEGMENT	PROPOSED	ORIGINAL
A	1	50
B	66	66
C	44	44
D	65	70
E	63	67
F	100	100
G	53	55
H	130	131
I	45	46
J	38	38
K	55	62
TOTALS	660	729
CHANGE	-69	

MULTI/TECH

ENGINEERING SERVICES, INC.
11555 13TH ST. S.E. SALEM, OR. 97302
PH. (503) 363 - 9227 FAX (503) 364-1260
www.mtechengineering.net office@mtechengineering.net

COVER SHEET

PROPOSED MODIFICATION

MULTI/TECH ENGINEERING EXEMPT FROM LIABILITY IF NOT STAMPED APPROVED

NOT FOR CONSTRUCTION UNLESS STAMPED APPROVED HERE

NO CHANGES, MODIFICATIONS OR REPRODUCTIONS TO BE MADE TO THESE DRAWINGS WITHOUT WRITTEN AUTHORIZATION FROM THE DESIGN ENGINEER.

DIMENSIONS & NOTES TAKE PRECEDENCE OVER GRAPHICAL REPRESENTATION.

6616-00000 1 of 7-2019

Design: M.D.G. Drawn: C.F.S. ProjMgr: J.J.G. Date: FEB. 2019 Scale: AS SHOWN As-Built: ----

