




17 trees to be preserved
47 Trees to be Removed
36% persevered

100% 64 TOTAL TREES WITHIN BOUNDARY
16% 10 MINIMUM TREES TO REMAIN
X = EXISTING TREE WHICH MAY BE REMOVED
o = EXISTING TREE TO REMAIN

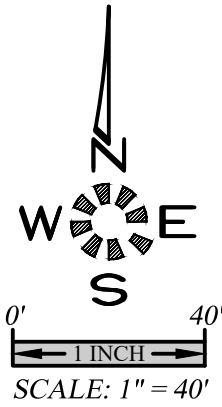

MULTI/TECH


ENGINEERING SERVICES, INC.
1155 13th ST., S.E. SALEM, OR. 97302
PH. (503) 363-5777 FAX (503) 364-5660
www.mtengr.com office@mtengr.com

PRELIMINARY
TREE CONSERVATION
PLAN - ONSITE: WEST

DEVON ESTATES

NO CHANGES, MODIFICATIONS
OR REVISIONS TO BE
MADE TO THESE DRAWINGS
WITHOUT WRITTEN
AUTHORIZATION FROM THE
DESIGN ENGINEER.
DIMENSIONS & NOTES TAKE
PRECEDENCE OVER
GRAPHICAL REPRESENTATION.




Design:	M.D.G.
Drawn:	P.H.S.
Checked:	M.D.G.
Date:	NOV. 2017
Scale:	AS SHOWN
As-Built:	----

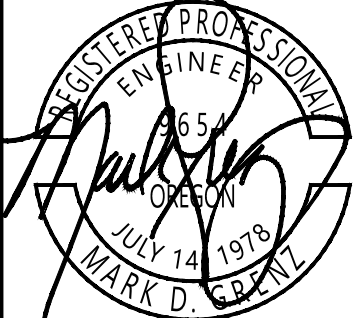

EXPIRES: 06-30-2021

JOB # 6502

 Z:\6502-6599\6502-DevonAvenueSubdivision\dwg\6502\650220.dwg, P104.Plt, 1/20/2021 2:51:19 PM, P5ounders

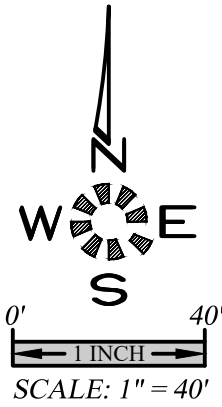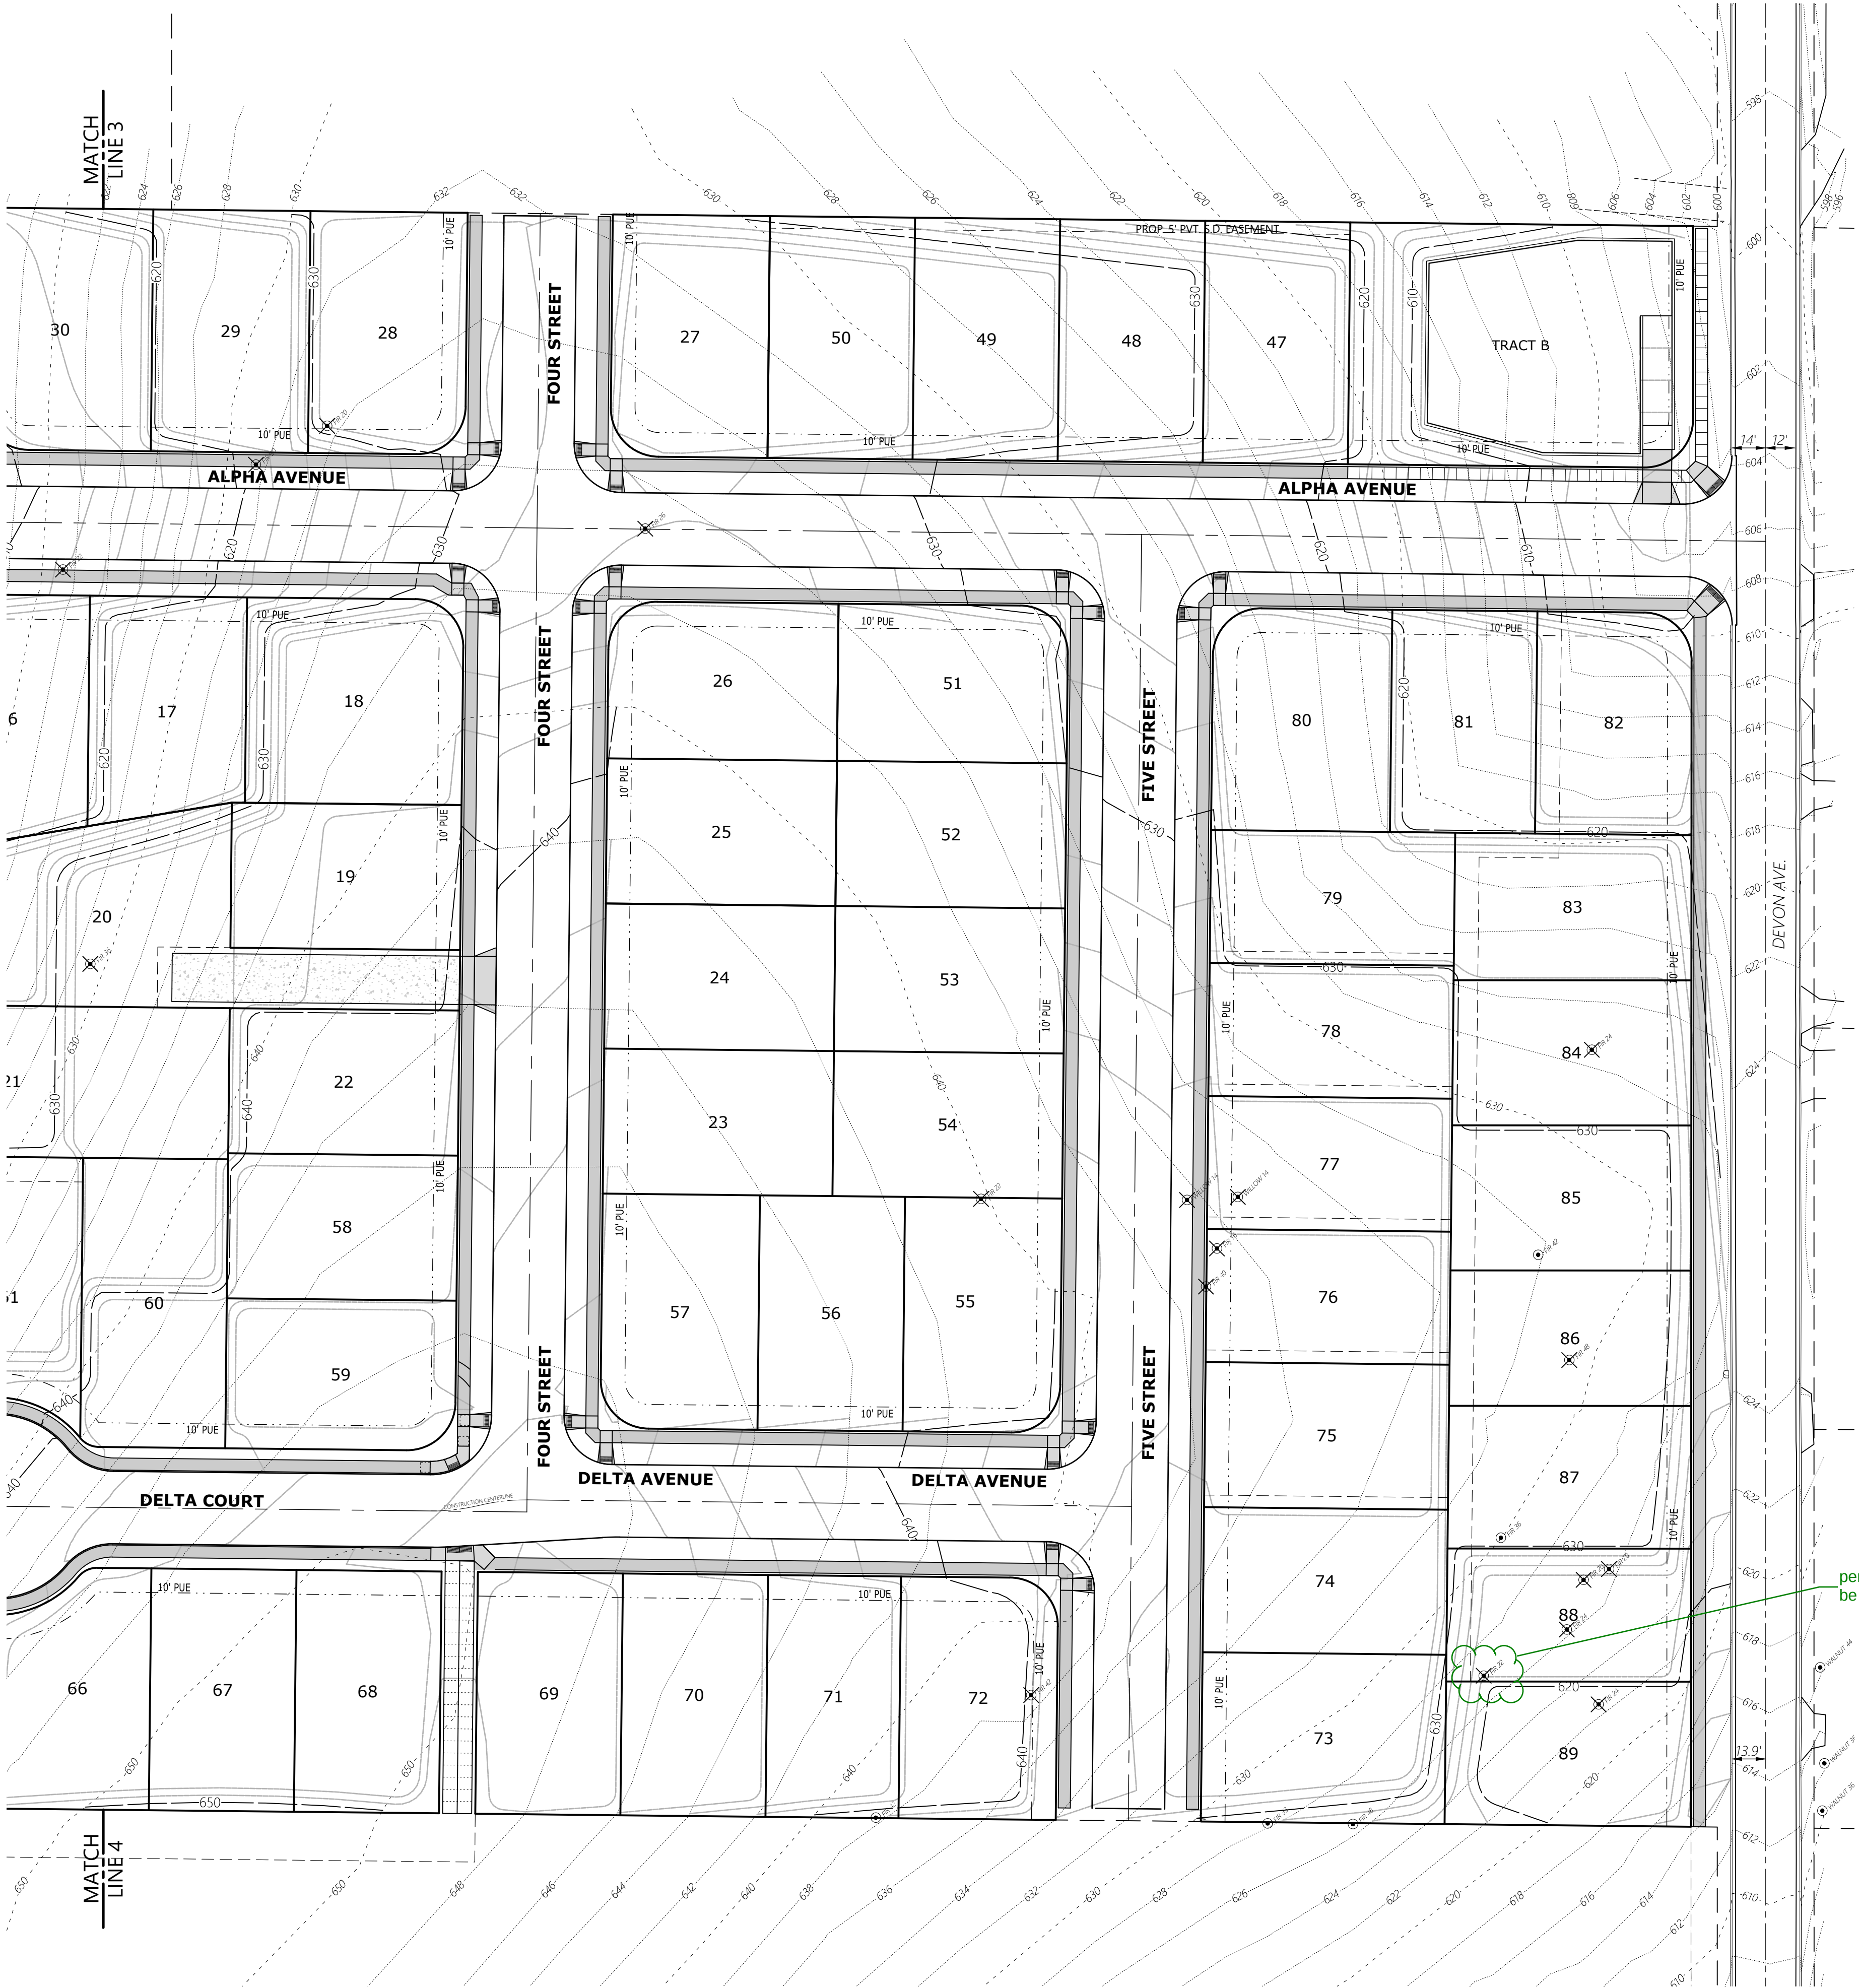

MULTI/TECH

ENGINEERING SERVICES, INC.


1155 13TH ST. S.E. SALEM, OR. 97302
 PH. (503) 363-3277 FAX (503) 366-7560
 www.mtengr.com email: office@mtengr.com

**PRELIMINARY
TREE CONSERVATION
PLAN - ONSITE: EAST**

DEVON ESTATES

NO CHANGES, MODIFICATIONS
OR REVISIONS SHALL BE
MADE TO THESE DRAWINGS
WITHOUT WRITTEN
AUTHORIZATION FROM THE
DESIGN ENGINEER.
DIMENSIONS & NOTES TAKE
PRECEDENCE OVER
GRAPHICAL REPRESENTATION.

Design:	M.D.G.
Drawn:	P.H.S.
Checked:	M.D.G.
Date:	NOV. 2017
Scale:	AS SHOWN
As-Built:	----

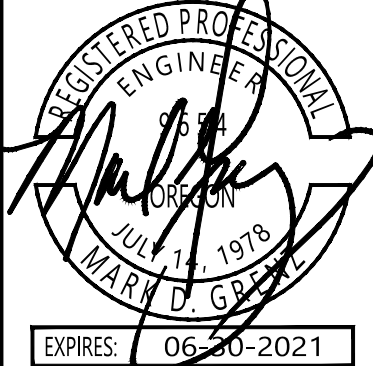

JOB # 6502

P104