


J:\6500-6599\6502-DevonAvenueSubdivision\Drawings\6502base.dwg, M00-SPT, 11/4/2021 8:45:28 AM, P:\surders

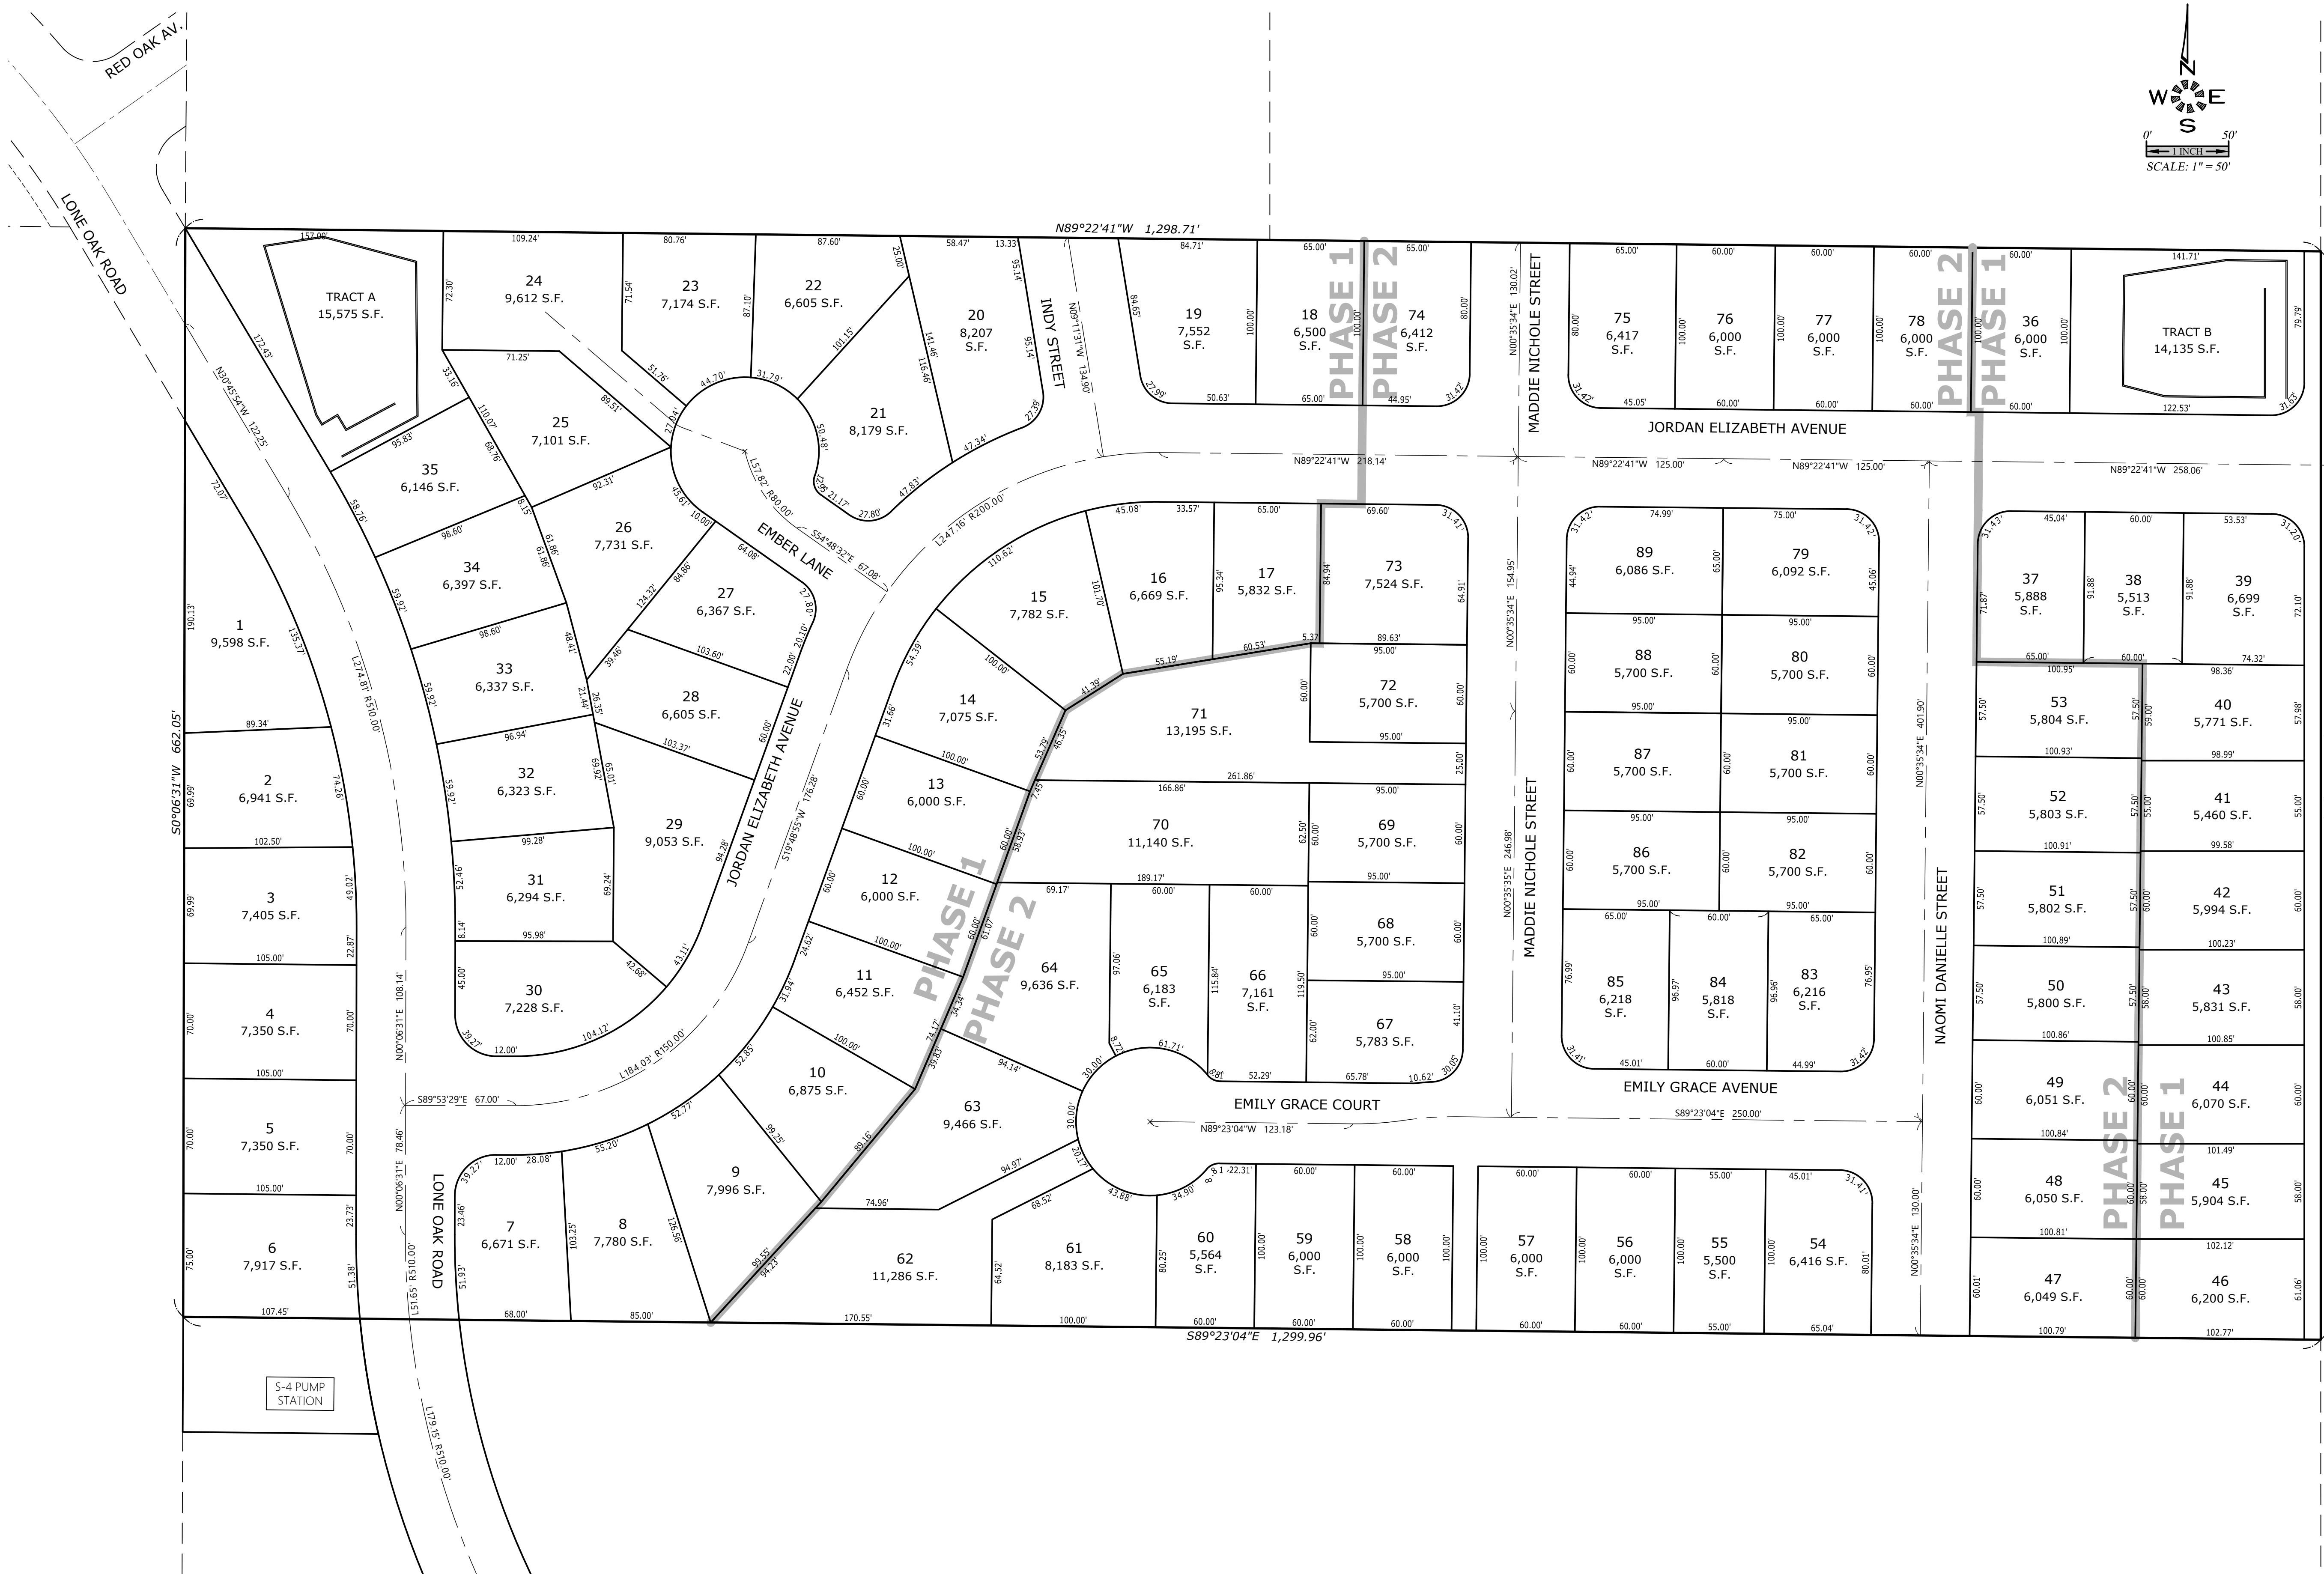

MODIFICATION
PHASING
SITE PLAN

DEVON ESTATES

NO CHANGES, MODIFICATIONS
OR REVISIONS SHALL BE
MADE WITHOUT WRITTEN
AUTHORIZATION FROM THE
DESIGN ENGINEER.
DIMENSIONS & NOTES TAKE
PRECEDENCE OVER
GRAPHICAL REPRESENTATION.

Design: M.D.G.
Drawn: P.H.S.
Checked: M.D.G.
Date: NOV. 2017
Scale: AS SHOWN
As-Built: ----



EXPIRES: 06-30-2023

JOB # 6502