

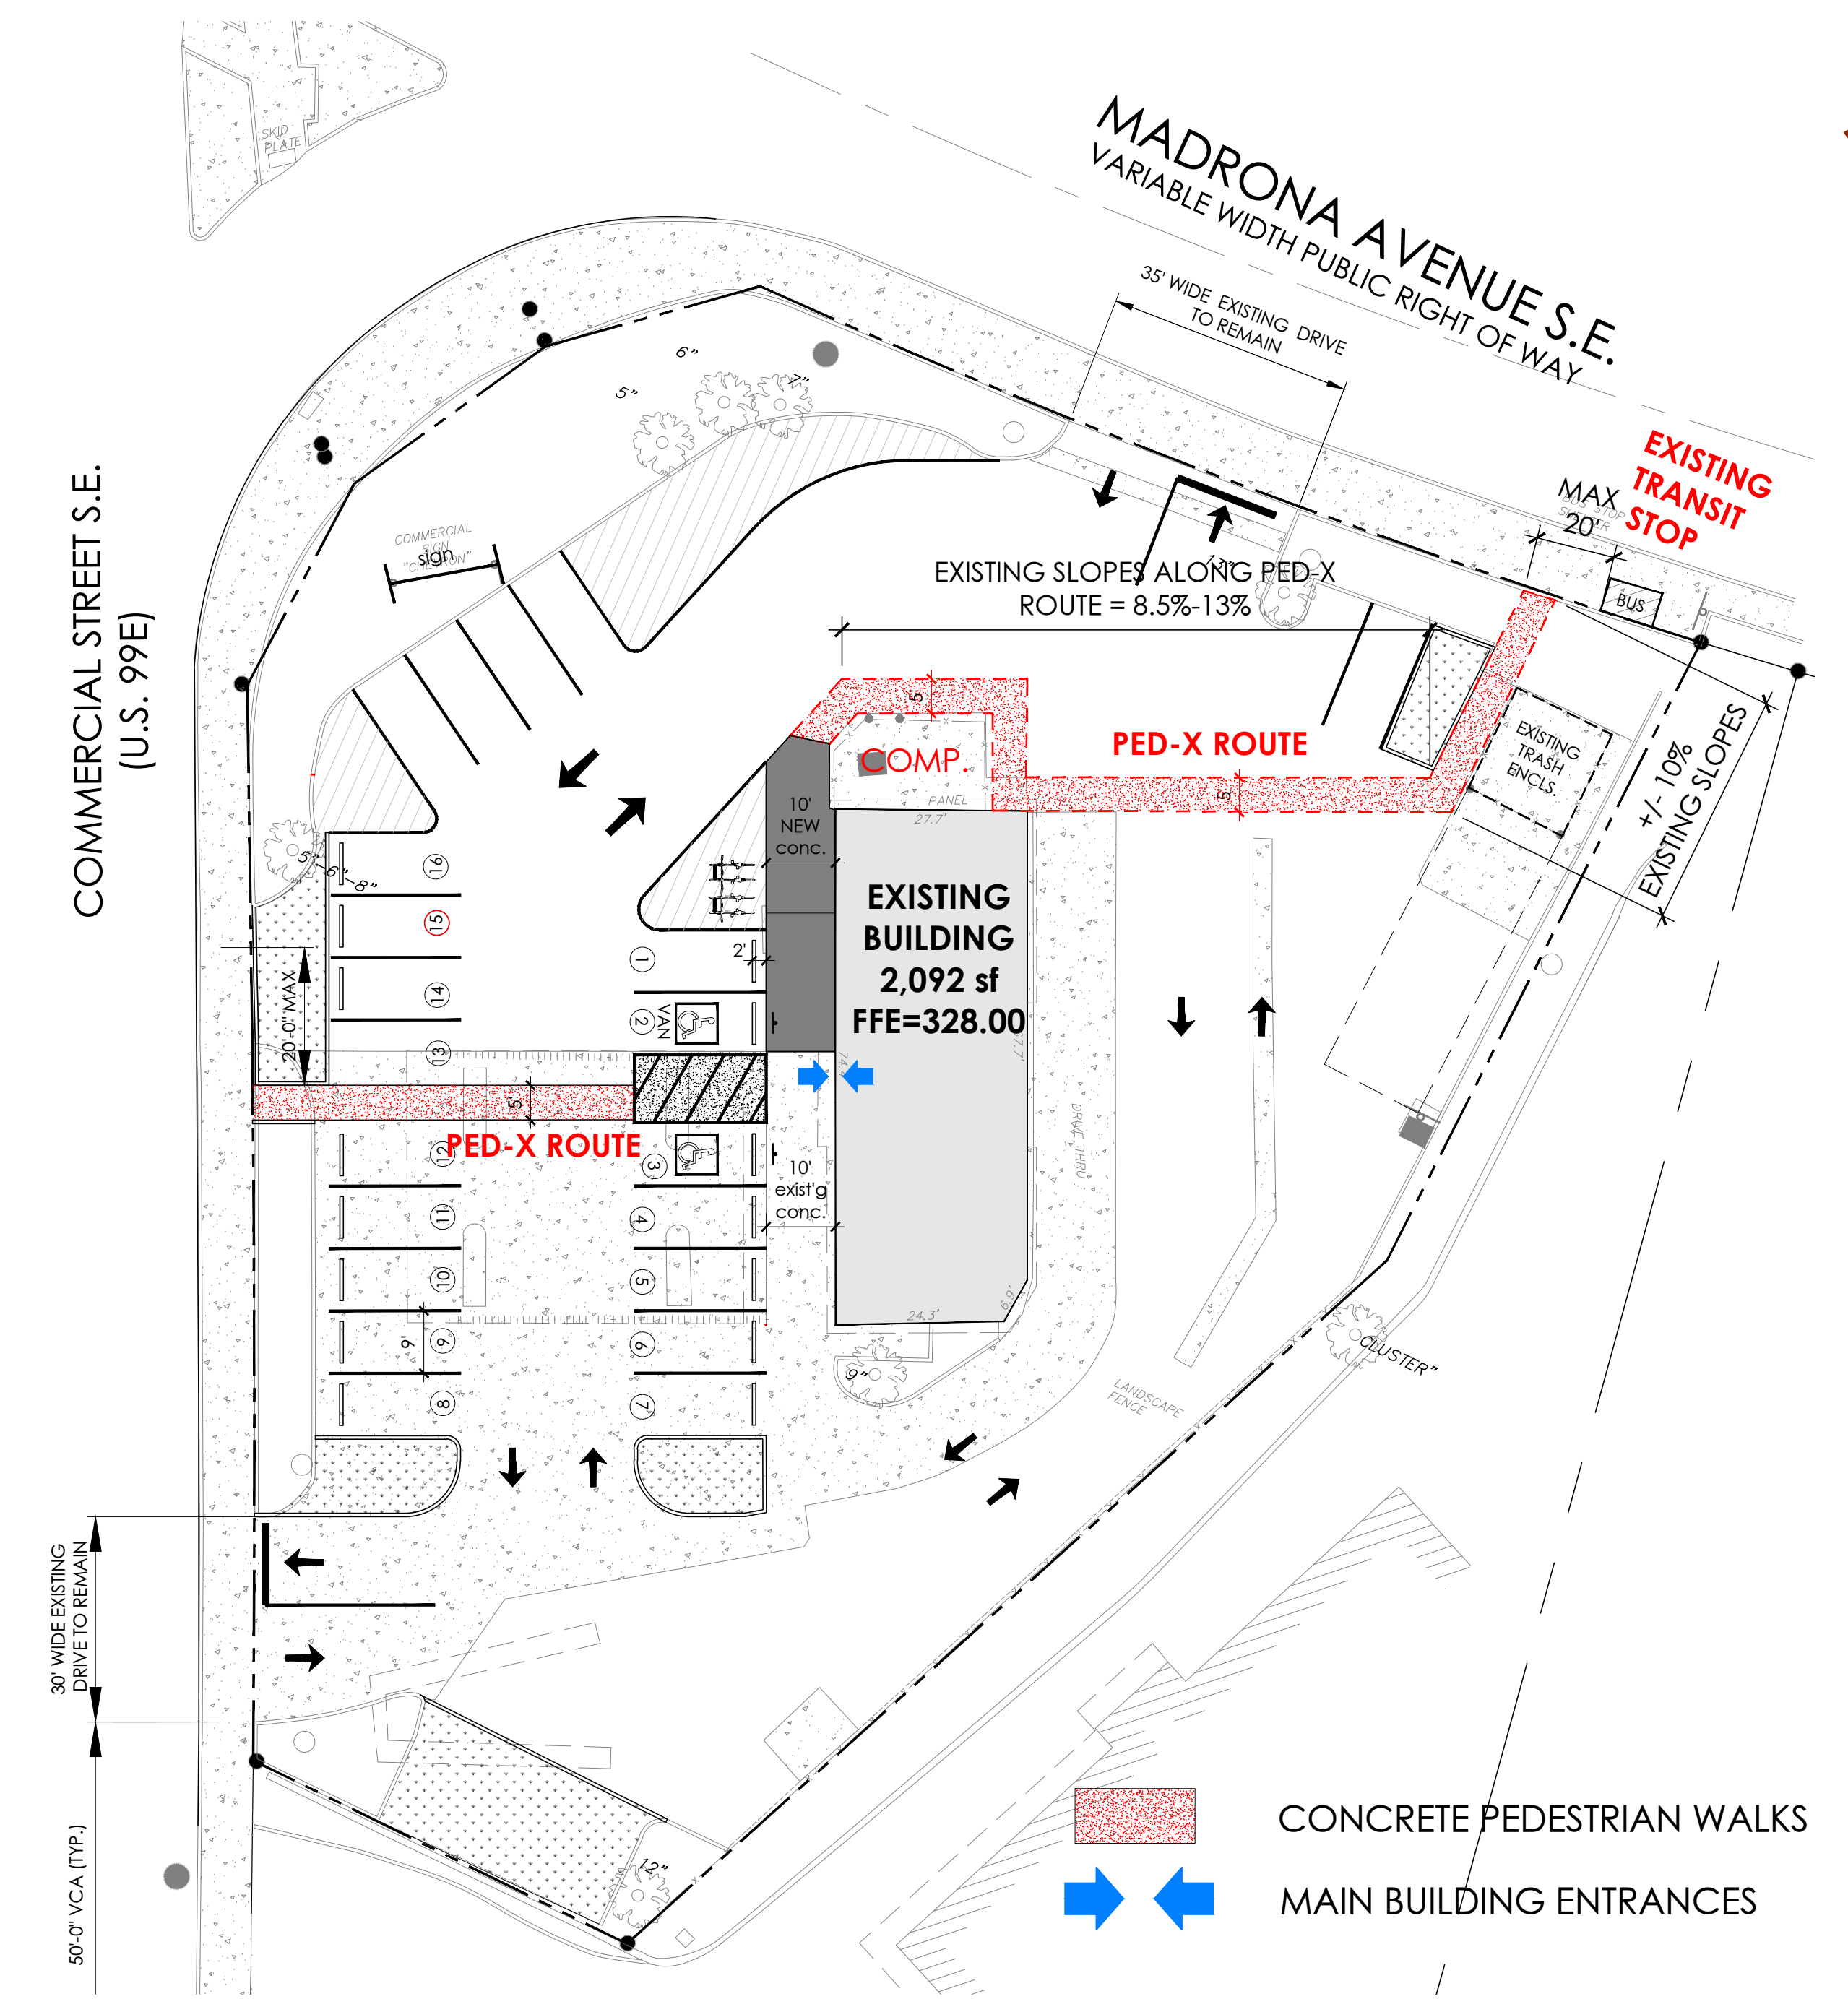


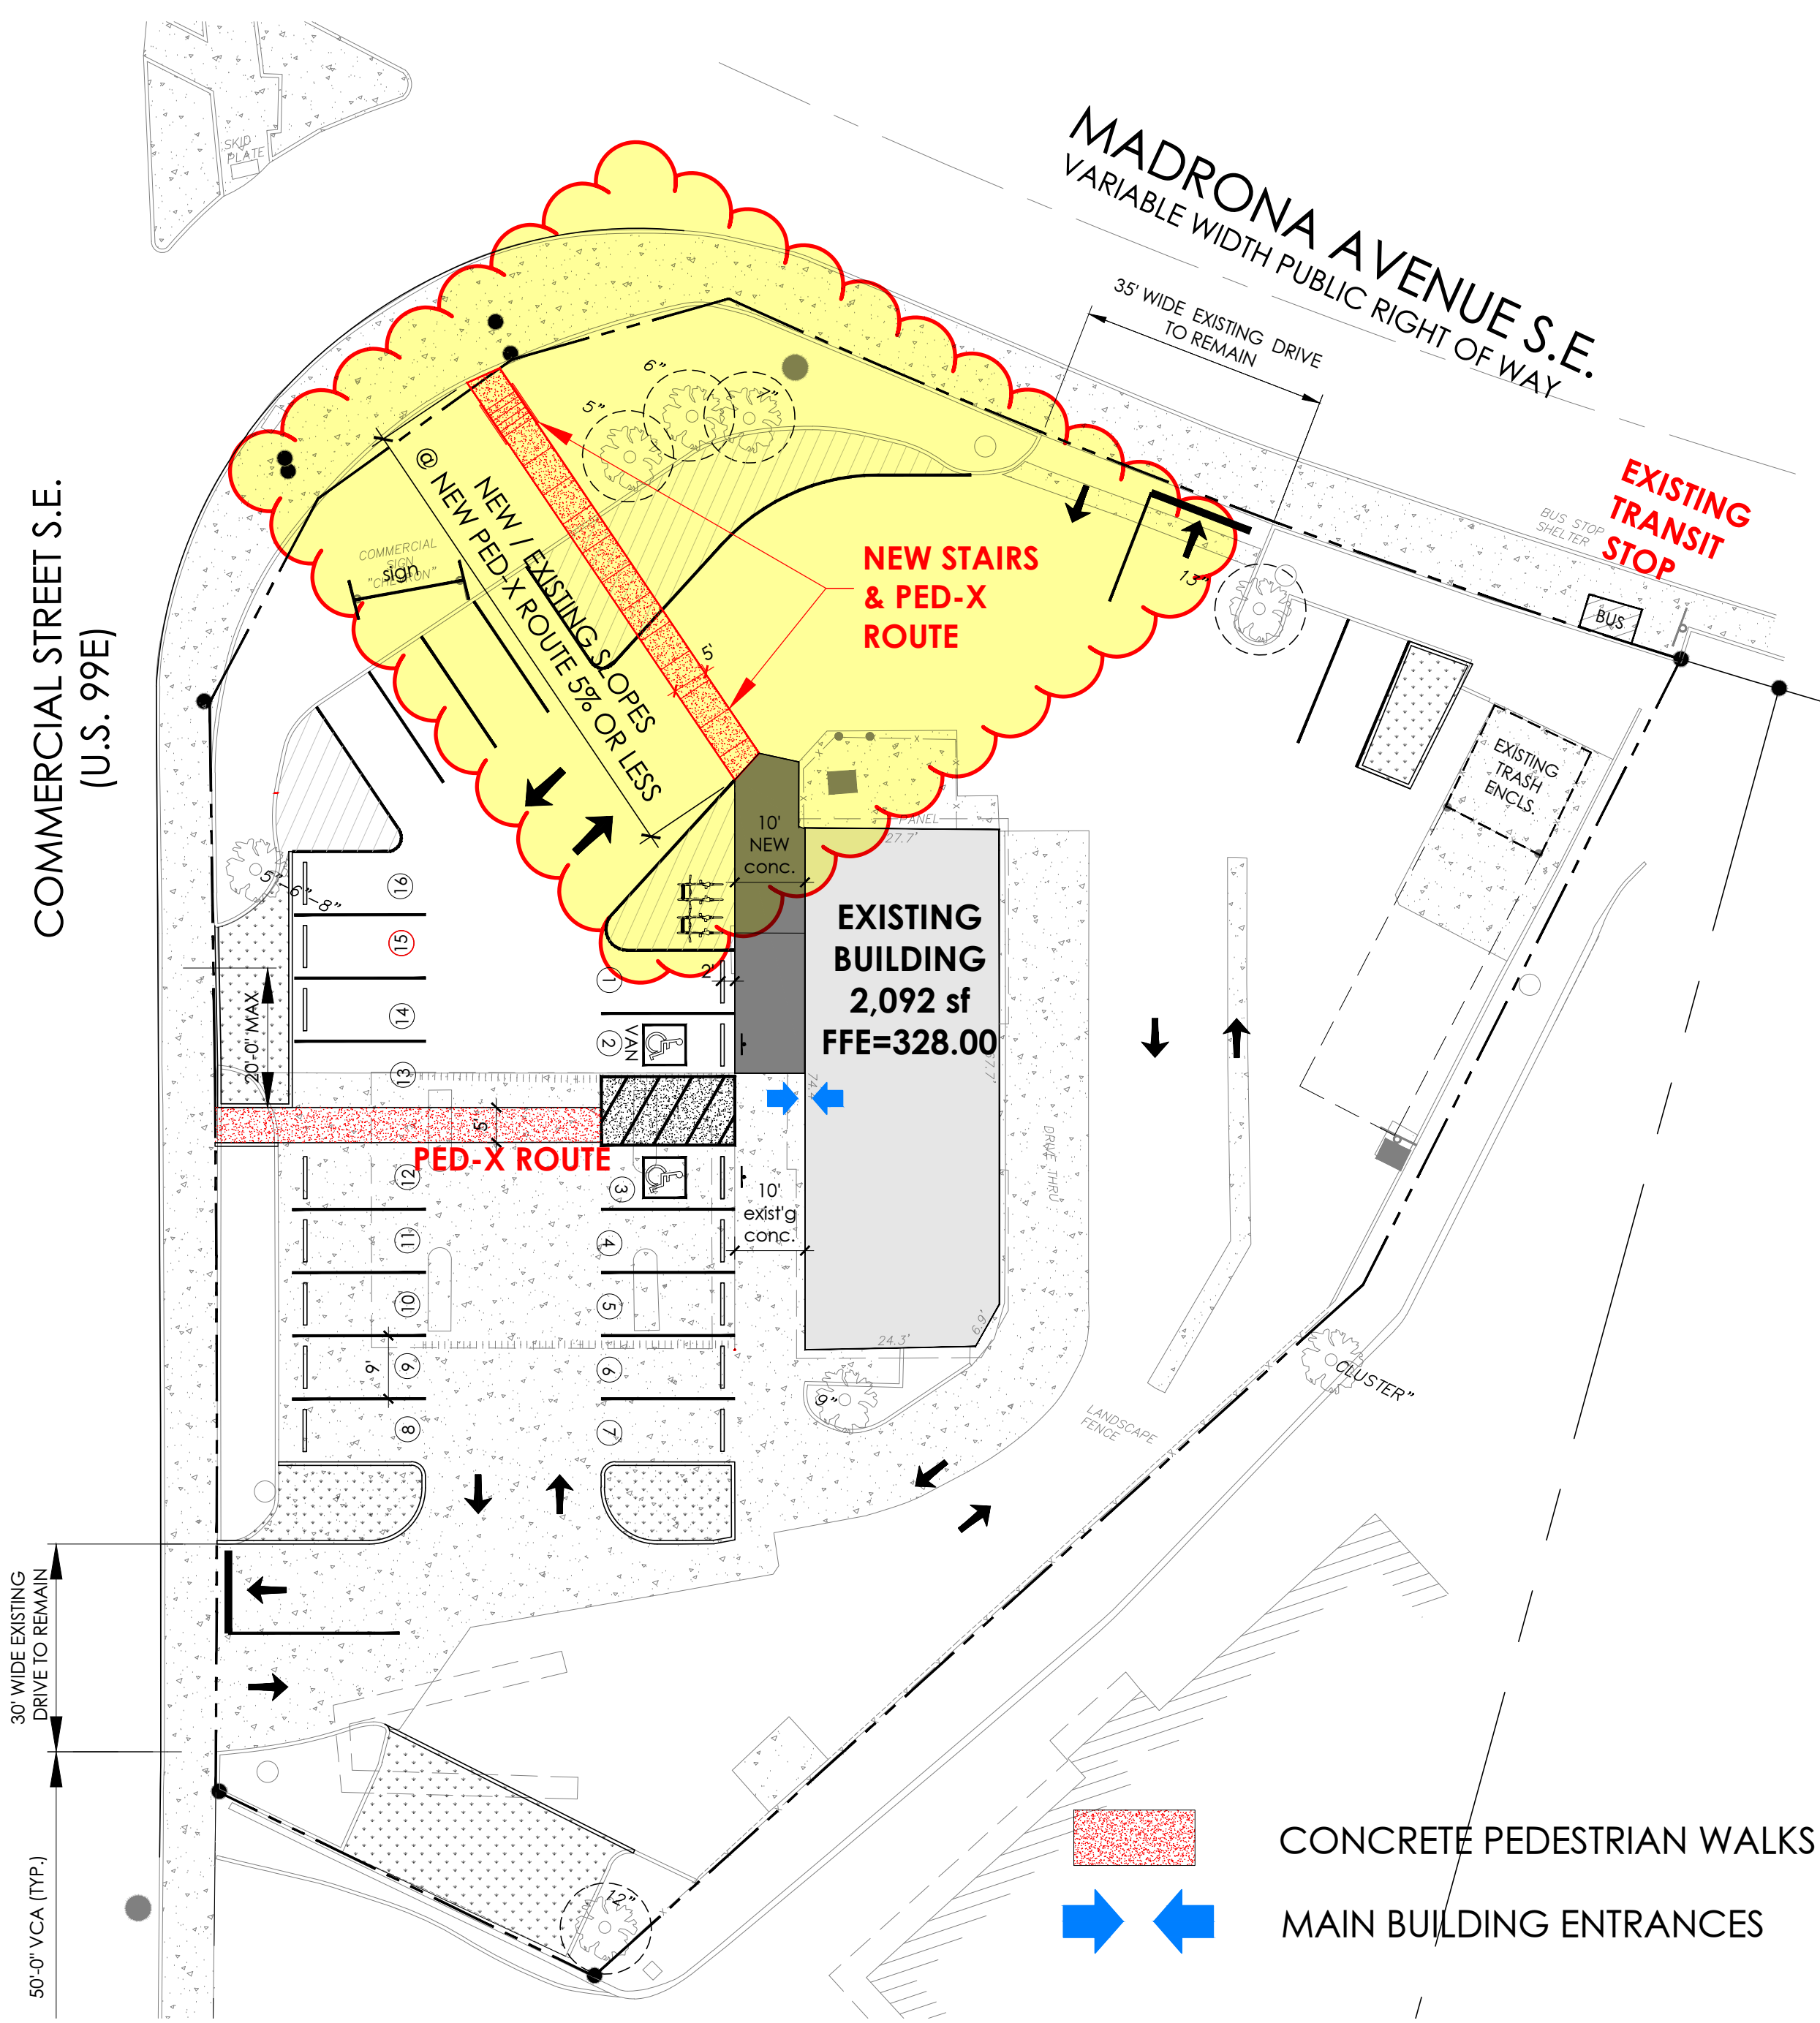

ADJUSTMENT REQUEST

APPROVED SITE PLAN

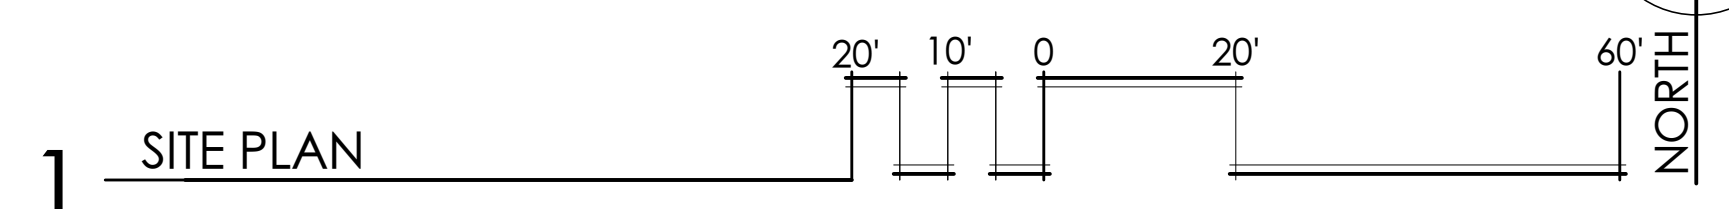

SGA
SG ARCHITECTURE, LLC

10940 SW Barnes Road #344
Portland, Oregon 97225
503-201-7025 | 503-347-4685

CLASS 3
SITE PLAN REVIEW
ADJUSTMENT

JJS HOLDINGS, LLC
JJS HOLDINGS, LLC
18066 NE AIRPORT WAY
PORTLAND, OREGON 97320

SITE & INTERIOR
TENANT IMPROVEMENTS
LOCATED AT THE
EXISTING CHEVRON
FOOD MART
3514 COMMERCIAL STREET SE
SALEM, OR 97302

PROJECT NUMBER:
21-105

ISSUE DATE:
MAR 17, 2022

DRAWN BY:
KG & SS

Revisions:

A1.5

\\192.168.0.11\sgarch\01 Projects\2021\21-105 Nectar JJS Commercial_Salem\05 CDs & Class 2 SPR\21-105_SPT SITE & DETAILS (rev 05-Exhibit).dwg