


TOPOGRAPHIC SURVEY

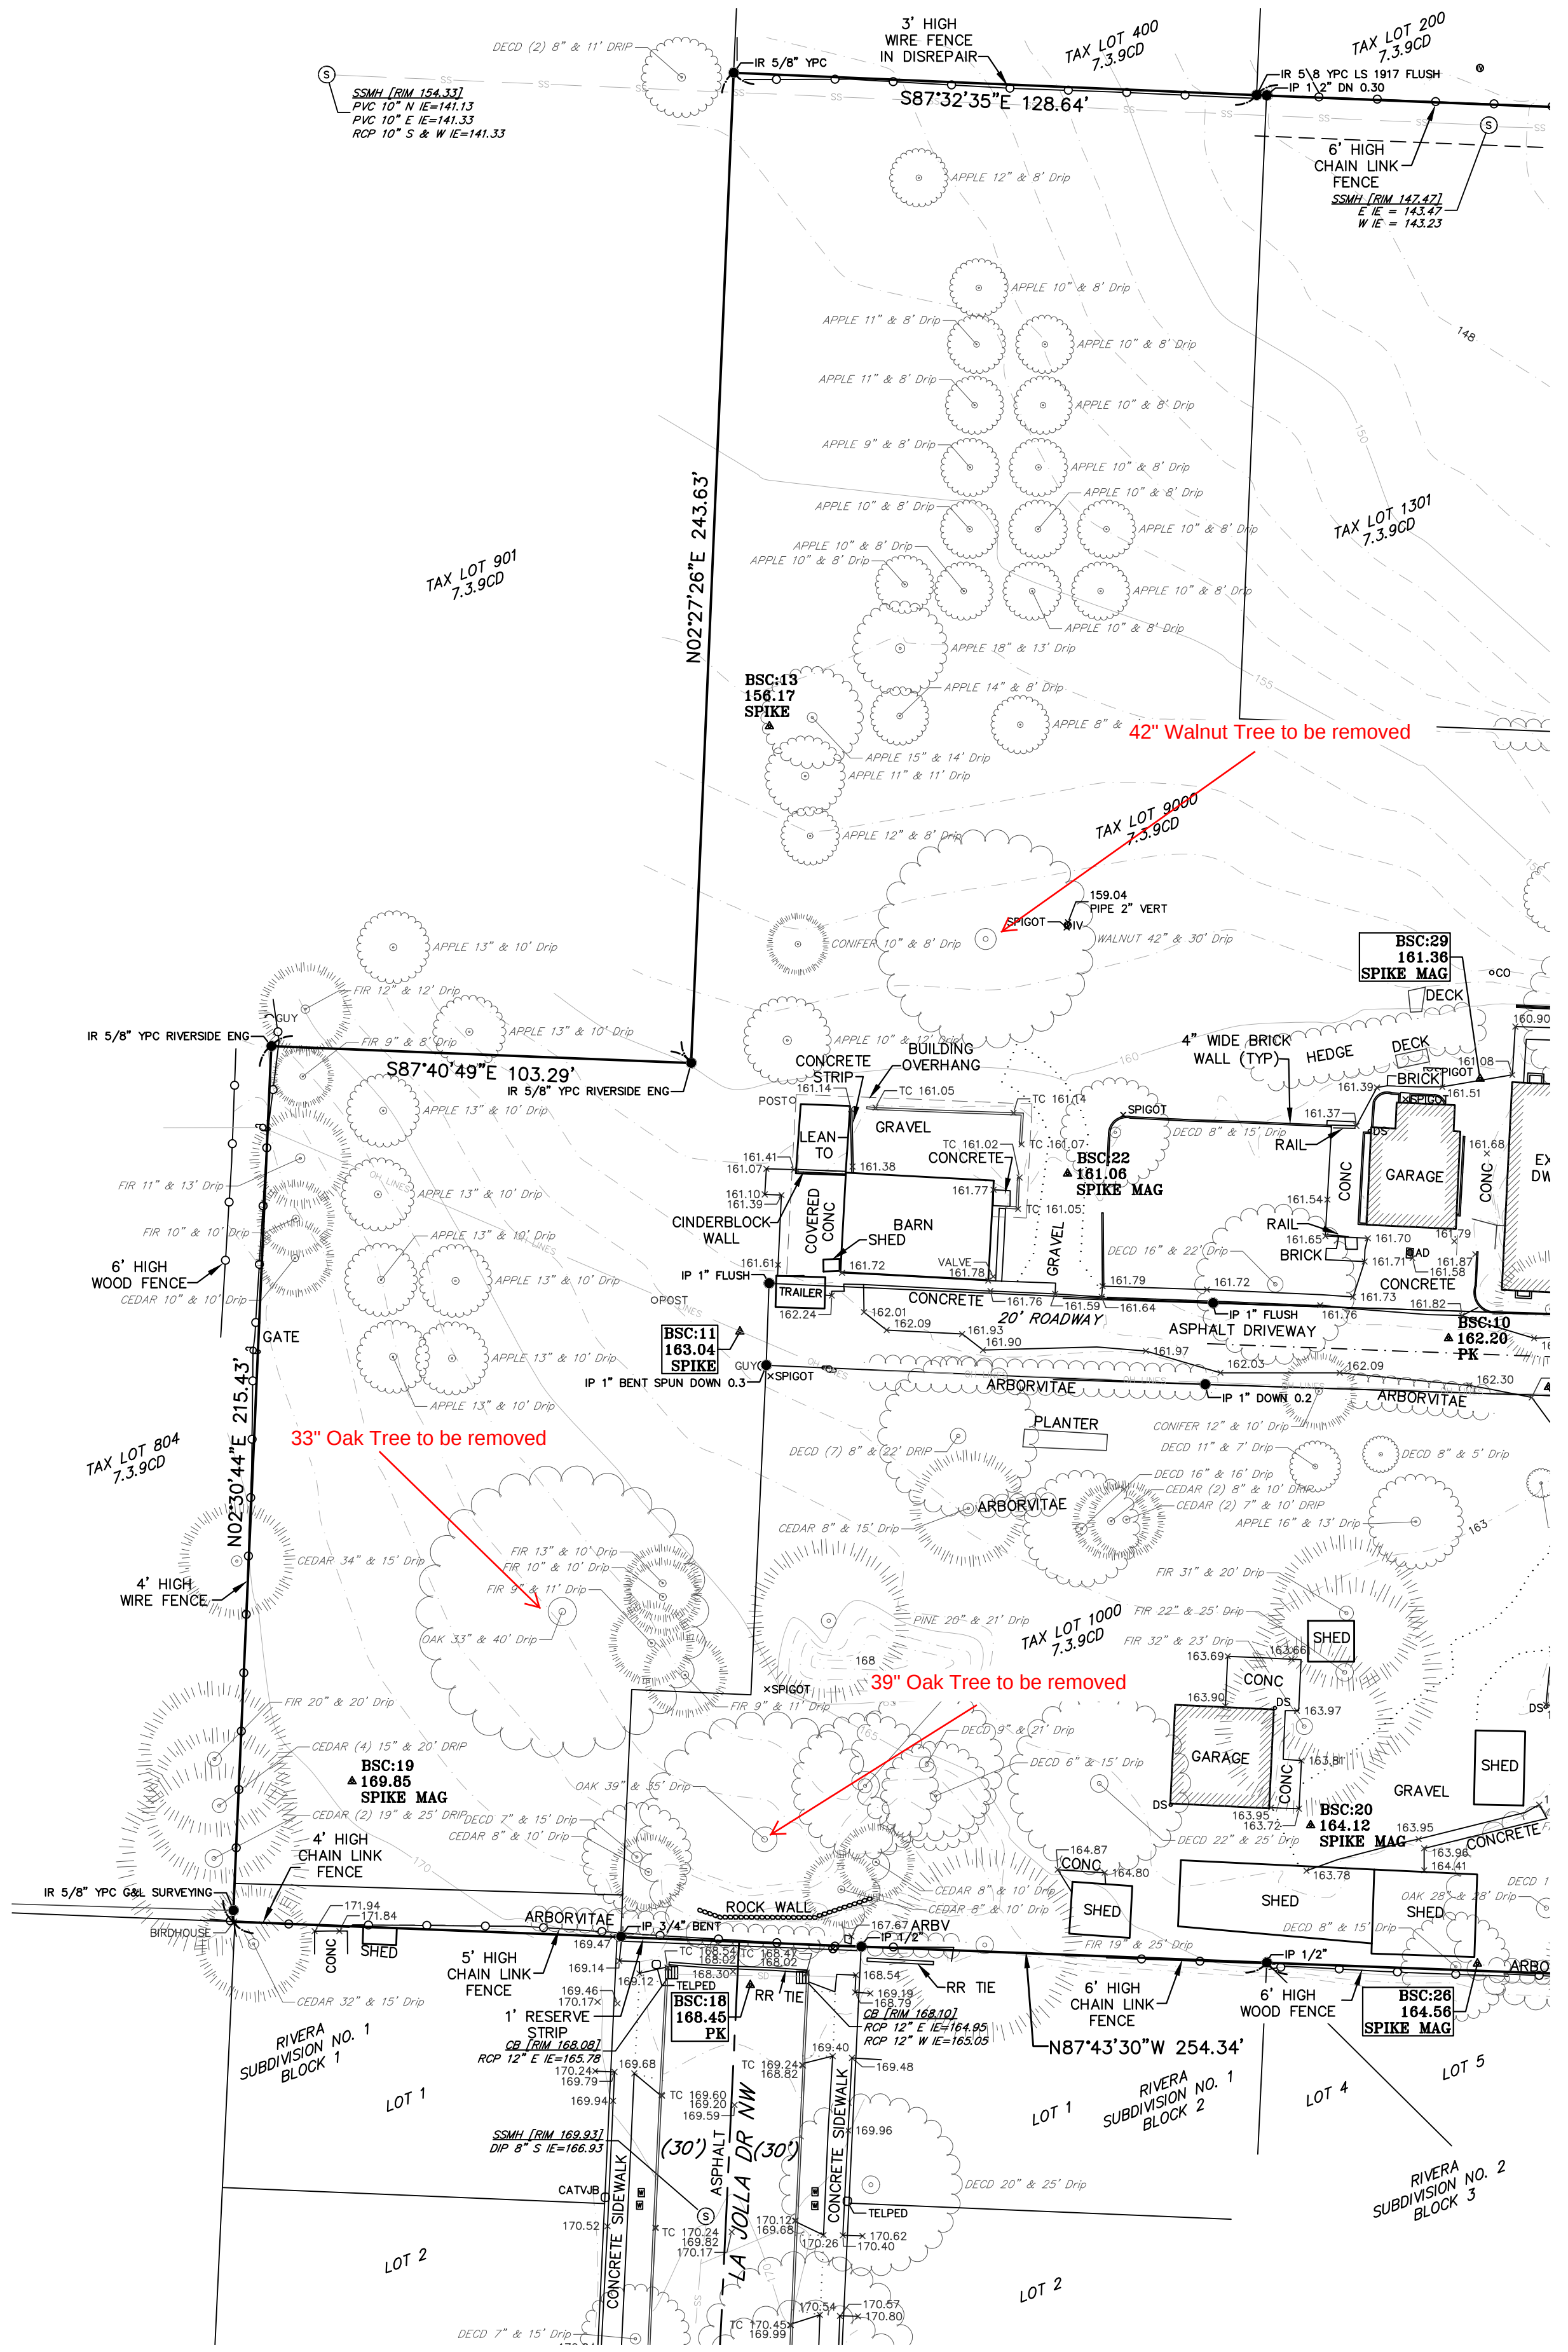

ABBREVIATIONS



ASPH	ASPHALT	IRR	IRRIGATION
AD	AREA DRAIN	INV	INVERT
ASSY	ASSEMBLY	JB	JUNCTION BOX
BLDG, BLD	BUILDING	LP	LIGHT POLE
BW	BOTTOM OF WALL	M	METER, MAIN
CATV	CABLE TELEVISION	MB	MAILBOX
CB	CATCH BASIN	MH	MANHOLE
CO	CLEAN-OUT	OH	OVER-HEAD
CONC	CONCRETE	P/L, R	PROPERTY LINE
CL	CENTERLINE	PP	POWER POLE
DIP	DUCTILE IRON PIPE	PVC	POLYVINYL CHLORIDE
EG	EDGE OF GRAVEL	PWR	POWER
EOP, EP	EDGE OF PAVEMENT	R, RAD	RADIUS
ELEV	ELEVATION	ROW, R/W	RIGHT-OF-WAY
EX, EXIST	EXISTING	SS	SANITARY SEWER
FDC	FIRE DEPT. CONNECTOR	SD	STORM DRAIN
FT	FEET	SVC	SERVICE
FF	FINISH FLOOR	SWK, S/W	SIDEWALK
FG	FINISH GRADE	TC	TOP OF CURB
FH	FIRE HYDRANT	TEL	TELEPHONE
FI	FIELD INLET	TR	TRANSFORMER
FM	FORCE MAIN	TS	TRAFFIC SIGNAL
GRAV	GRAVEL	TW	TOP OF WALL
GM	GAS METER	TYP	TYPICAL
GP	GATE POST	UG, U/G	UNDER GROUND
GS	GROUND SHOT	UTIL	UTILITY
GV	GAS VALVE	VLT	VAULT
HC	HANDICAP	W/	WITH
HYD	HYDRANT	WM	WATER METER
IR	IRON ROD	WLM	WETLANDS MARKER
IP	IRON PIPE	YPC	YELLOW PLASTIC CAP

SYMBOLS

AD	AREA DRAIN	✓	SIGN POST
CB or []	CATCH BASIN	□	PEDESTAL
CO	CLEANOUT	□	MAIL BOX
⊗	FIRE HYDRANT	⊗	IRRIGATION VALVE
⊕	GAS VALVE	☆	LIGHT POLE
⊕	WATER VALVE	⊕	UTILITY/POWER POLES
⊕	GAS/POWER/WATER METER	⊕	TEST PIT
DSO	DOWN SPOUT	●	MONUMENT FOUND
⊕	MANHOLE TELEPHONE		
⊕	MANHOLE STORM DRAIN		
⊕	MANHOLE SANITARY SEWER		
⊕	TREES - *TREENAME* DIAMETER (INCHES)/DRIP RADIUS (FEET)		

LINE TYPES

CATV LINE	---
COMMUNICATION LINE	---
EASEMENT LINE	---
FENCE LINE	---
FIBER OPTIC LINE	---
GAS LINE	---
EDGE OF GRAVEL LINE	---
OVERHEAD LINE	---
PHONE LINE	---
POWER LINE	---
SANITARY SEWER LINE	---
STORM DRAIN LINE	---
WATER LINE	---

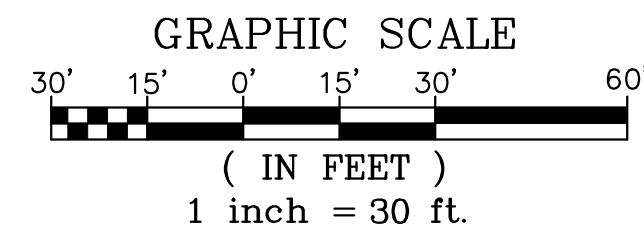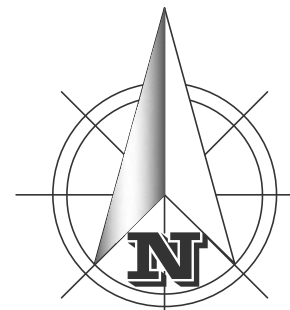

BENCHMARK UTILIZED:
ELEV: 178.12' NGVD 29
SURVEY MAG NAIL BSC POINT #11001 IN ASPHALT AS SHOWN
ELEVATIONS ARE BASED ON GPS OBSERVATION WITH A VERTCON ADJUSTMENT
OF -3.36' FROM NAVD 88 TO NGVD 29 DATUM

DISCLAIMER: UTILITIES DEPICTED ARE BASED ON EVIDENCE FOUND IN THE FIELD, MUNICIPALITY AND/OR OTHER GOVERNMENT ENTITY AS-BUILT PLANS, CONTRACTOR PLANS AND OTHER DOCUMENTS OF RECORD. BARKER SURVEYING ASSUMES NO RESPONSIBILITY FOR UTILITIES THAT ARE NO LONGER IN USE, INSTALLED AFTER THE DATE OF ACTUAL SURVEY, NOT IDENTIFIED OR NOT LOCATED. THIS INCLUDES UTILITIES UPON PUBLIC OR PRIVATE PROPERTY.
SPECIFIC UTILITY POSITIONS INDICATED ON THE GROUND SURFACE PROVIDED BY LOCATION SERVICES MAY VARY DUE TO UNDERGROUND DETECTION CAPABILITIES.




REGISTERED
PROFESSIONAL
LAND SURVEYOR

OREGON
GREGORY L. WILSON
2687

EXPIRATION DATE: 6/30/2020

SURVEY FOR	WESTECH ENGINEERING
LOCATION:	TAX LOTS 900, 1000, & 1301 7.3.9CD
SCALE:	1"=30'
DATE:	4/10/2019
DRAWN BY:	R.J.C.
BARKER SURVEYING 3657 KASHMIR WAY SE SALEM, OREGON 97317 PHONE (503) 588-8800 FAX (503) 363-2469 EMAIL: INFO@BARKERWILSON.COM	CITY OF SALEM POLK COUNTY, OREGON SHEET 1 OF 2 JOB NUMBER: 40843

TOPOGRAPHIC SURVEY

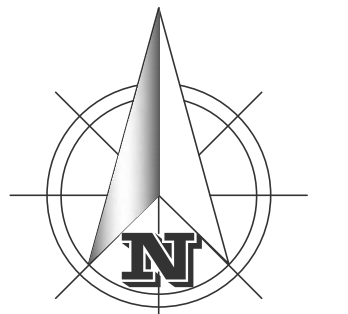

GRAPHIC SCALE
30' 15' 0' 15' 30' 60'
(IN FEET)
1 inch = 30 ft.

ABBREVIATIONS

ASPH	ASPHALT	IRR	IRRIGATION
AD	AREA DRAIN	INV	INVERT
ASSY	ASSEMBLY	JB	JUNCTION BOX
BLDG, BLD	BUILDING	LP	LIGHT POLE
BW	BOTTOM OF WALL	M	METER, MAIN
CATV	CABLE TELEVISION	MB	MAILBOX
CB	CATCH BASIN	MH	MANHOLE
CO	CLEAN-OUT	OH	OVER-HEAD
CONC	CONCRETE	P/L	PROPERTY LINE
CL	CENTERLINE	PP	POWER POLE
DIP	DUCTILE IRON PIPE	PVC	POLYVINYL CHLORIDE
EG	EDGE OF GRAVEL	PWP	POWER
EOP, EP	EDGE OF PAVEMENT	R, RAD	RADIUS
ELEV	ELEVATION	ROW, R/W	RIGHT-OF-WAY
EX, EXIST	EXISTING	SS	SANITARY SEWER
FDG	FIRE DEPT. CONNECTOR	SD	STORM DRAIN
FT	FEET	SVC	SERVICE
FF	FINISH FLOOR	SWK, S/W	SIDEWALK
FG	FINISH GRADE	TC	TOP OF CURB
FH	FIRE HYDRANT	TEL	TELEPHONE
FI	FIELD INLET	TR	TRANSFORMER
FM	FORCE MAIN	TS	TRAFFIC SIGNAL
GRAV	GRAVEL	TW	TOP OF WALL
GM	GAS METER	TYP	TYPICAL
GP	GATE POST	UG, U/G	UNDER GROUND
GS	GROUND SHOT	UTL	UTILITY
GV	GAS VALVE	VLT	VAULT
HC	HANDICAP	W/	WITH
HYD	HYDRANT	WM	WATER METER
IR	IRON ROD	WLM	WETLANDS MARKER
IP	IRON PIPE	YPC	YELLOW PLASTIC CAP

SYMBOLS

AD	AREA DRAIN	✓	SIGN POST
CB	CATCH BASIN	PED	PEDESTAL
COO	CLEANOUT	MB	MAIL BOX
✓	FIRE HYDRANT	✓	IRRIGATION VALVE
✓	GAS VALVE	✓	LIGHT POLE
✓	WATER VALVE	✓	UTILITY/POWER POLES
✓	GAS/POWER/WATER METER	✓	TEST PIT
DSO	DOWN SPOUT	•	MONUMENT FOUND
✓	MANHOLE TELEPHONE		
✓	MANHOLE STORM DRAIN		
✓	MANHOLE SANITARY SEWER		
✓	TREES - *TREE NAME* DIAMETER (INCHES)/DRIP RADIUS (FEET)		

NOTE: DIAMETER MEASURED AT BREAST HEIGHT

LINE TYPES

CATV LINE	CATV
COMMUNICATION LINE	COM
EASEMENT LINE	EASE
FIBER OPTIC LINE	FOC
GAS LINE	GAS
EDGE OF GRAVEL LINE	EG
OVERHEAD LINE	OH
PHONE LINE	PH
POWER LINE	ELEC
SANITARY SEWER LINE	SS
STORM DRAIN LINE	SD
WATER LINE	W

BENCHMARK UTILIZED:

ELEV: 178.12' NGVD29

SURVEY MAG NAIL BSC POINT #11001 IN ASPHALT AS SHOWN

ELEVATIONS ARE BASED ON GPS OBSERVATION WITH A VERTICAN ADJUSTMENT OF -3.36' FROM NAVD 88 TO NGVD 29 DATUM

DISCLAIMER: UTILITIES DEPICTED ARE BASED ON EVIDENCE FOUND IN THE FIELD, MUNICIPALITY AND/OR OTHER GOVERNMENT ENTITY AS-BUILT PLANS, CONTRACTOR PLANS AND OTHER DOCUMENTS OF RECORD. BARKER SURVEYING ASSUMES NO RESPONSIBILITY FOR UTILITIES THAT ARE NO LONGER IN USE, INSTALLED AFTER THE DATE OF ACTUAL SURVEY, NOT IDENTIFIED OR NOT LOCATED. THIS INCLUDES UTILITIES UPON PUBLIC OR PRIVATE PROPERTY.

SPECIFIC UTILITY POSITIONS INDICATED ON THE GROUND SURFACE PROVIDED BY LOCATION SERVICES MAY VARY DUE TO UNDERGROUND DETECTION CAPABILITIES.



REGISTERED
PROFESSIONAL
LAND SURVEYOR

OREGON
JULY 19, 1994
GREGORY L. WILSON
2687

EXPIRATION DATE: 6/30/2020

SURVEY FOR	WESTECH ENGINEERING
LOCATION:	TAX LOTS 900, 1000, & 1301 7.3.9CD
SW 1/4 SECTION 9 T7S, R3W, W.M.	CITY OF SALEM POLK COUNTY, OREGON
SCALE: 1"=30'	BARKER SURVEYING 3657 KASHMIR WAY SE SALEM, OREGON 97317 PHONE (503) 588-8800 FAX (503) 363-2469 EMAIL: INFO@BARKERWILSON.COM
DATE: 4/10/2019	SHEET 2 OF 2
DRAWN BY: R.J.C.	JOB NUMBER: 40843