


P:\2181 Thermal Supply 3130 22nd\A2.1 06.16.2022.dwg, SPR-8, 7/6/2022 2:50:33 PM, Andy, 1:1

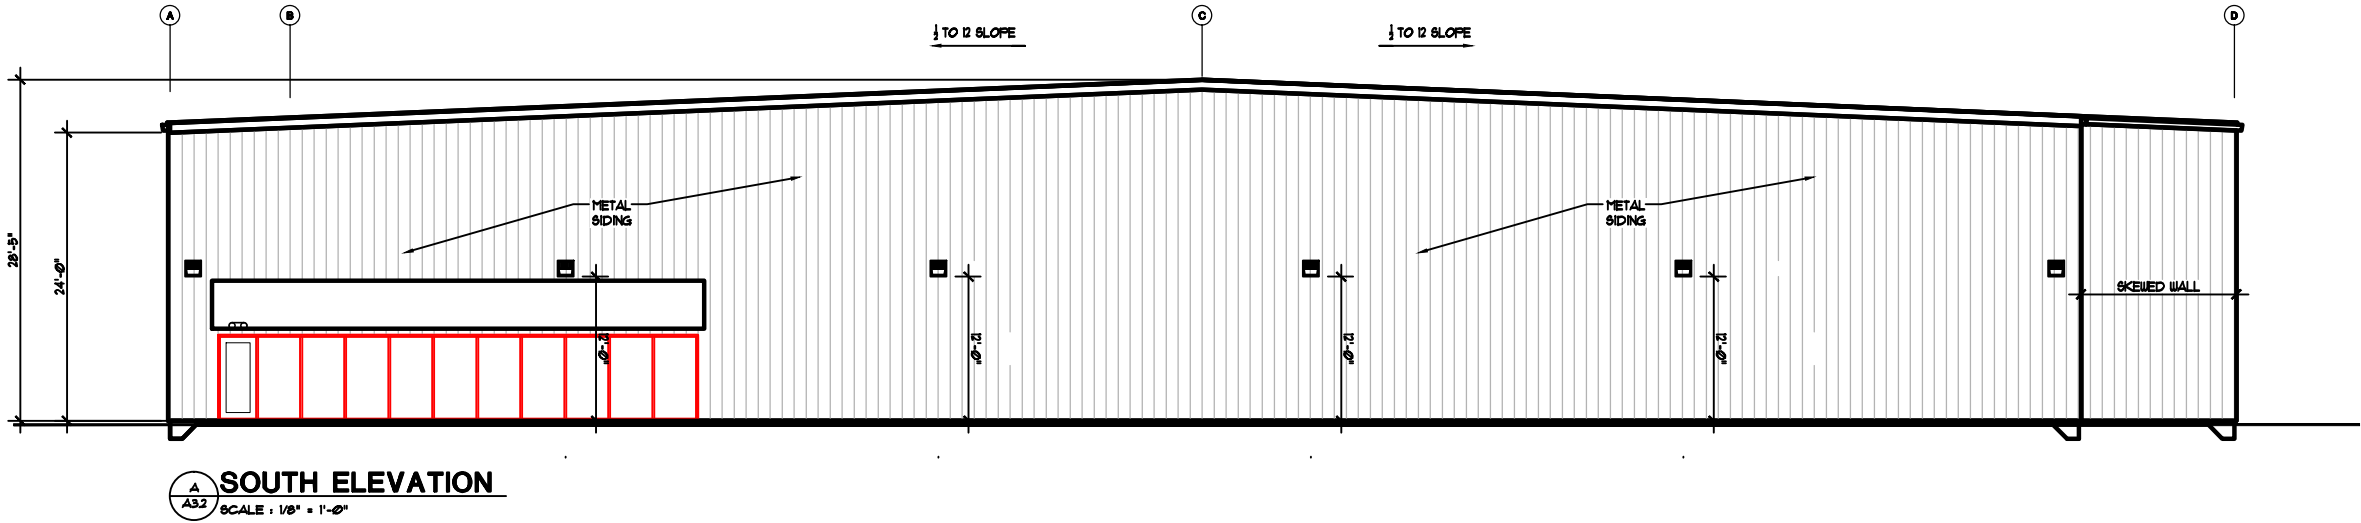

**SOUTH ELEVATION**

SCALE : 1/16" = 1'-0"



DATE: 04.22.2022  
DRAWN: glm  
JOB NO.: 2181

**SPR 8**

Site Plan Review Class 2  
**Thermal Supply**  
3120 22nd St SE, Salem, OR 97302

