
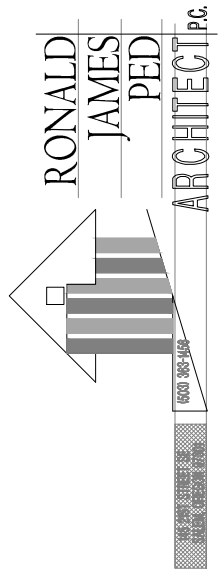


Non-SFR < 10,000 Square Feet:
SRC does not require Non-SFR projects consisting of less than 10,000 square feet of new or replaced impervious surface to provide stormwater flow control or general storm water treatment. However, reducing impervious surface area may reduce SDC fees and stormwater utility rates.

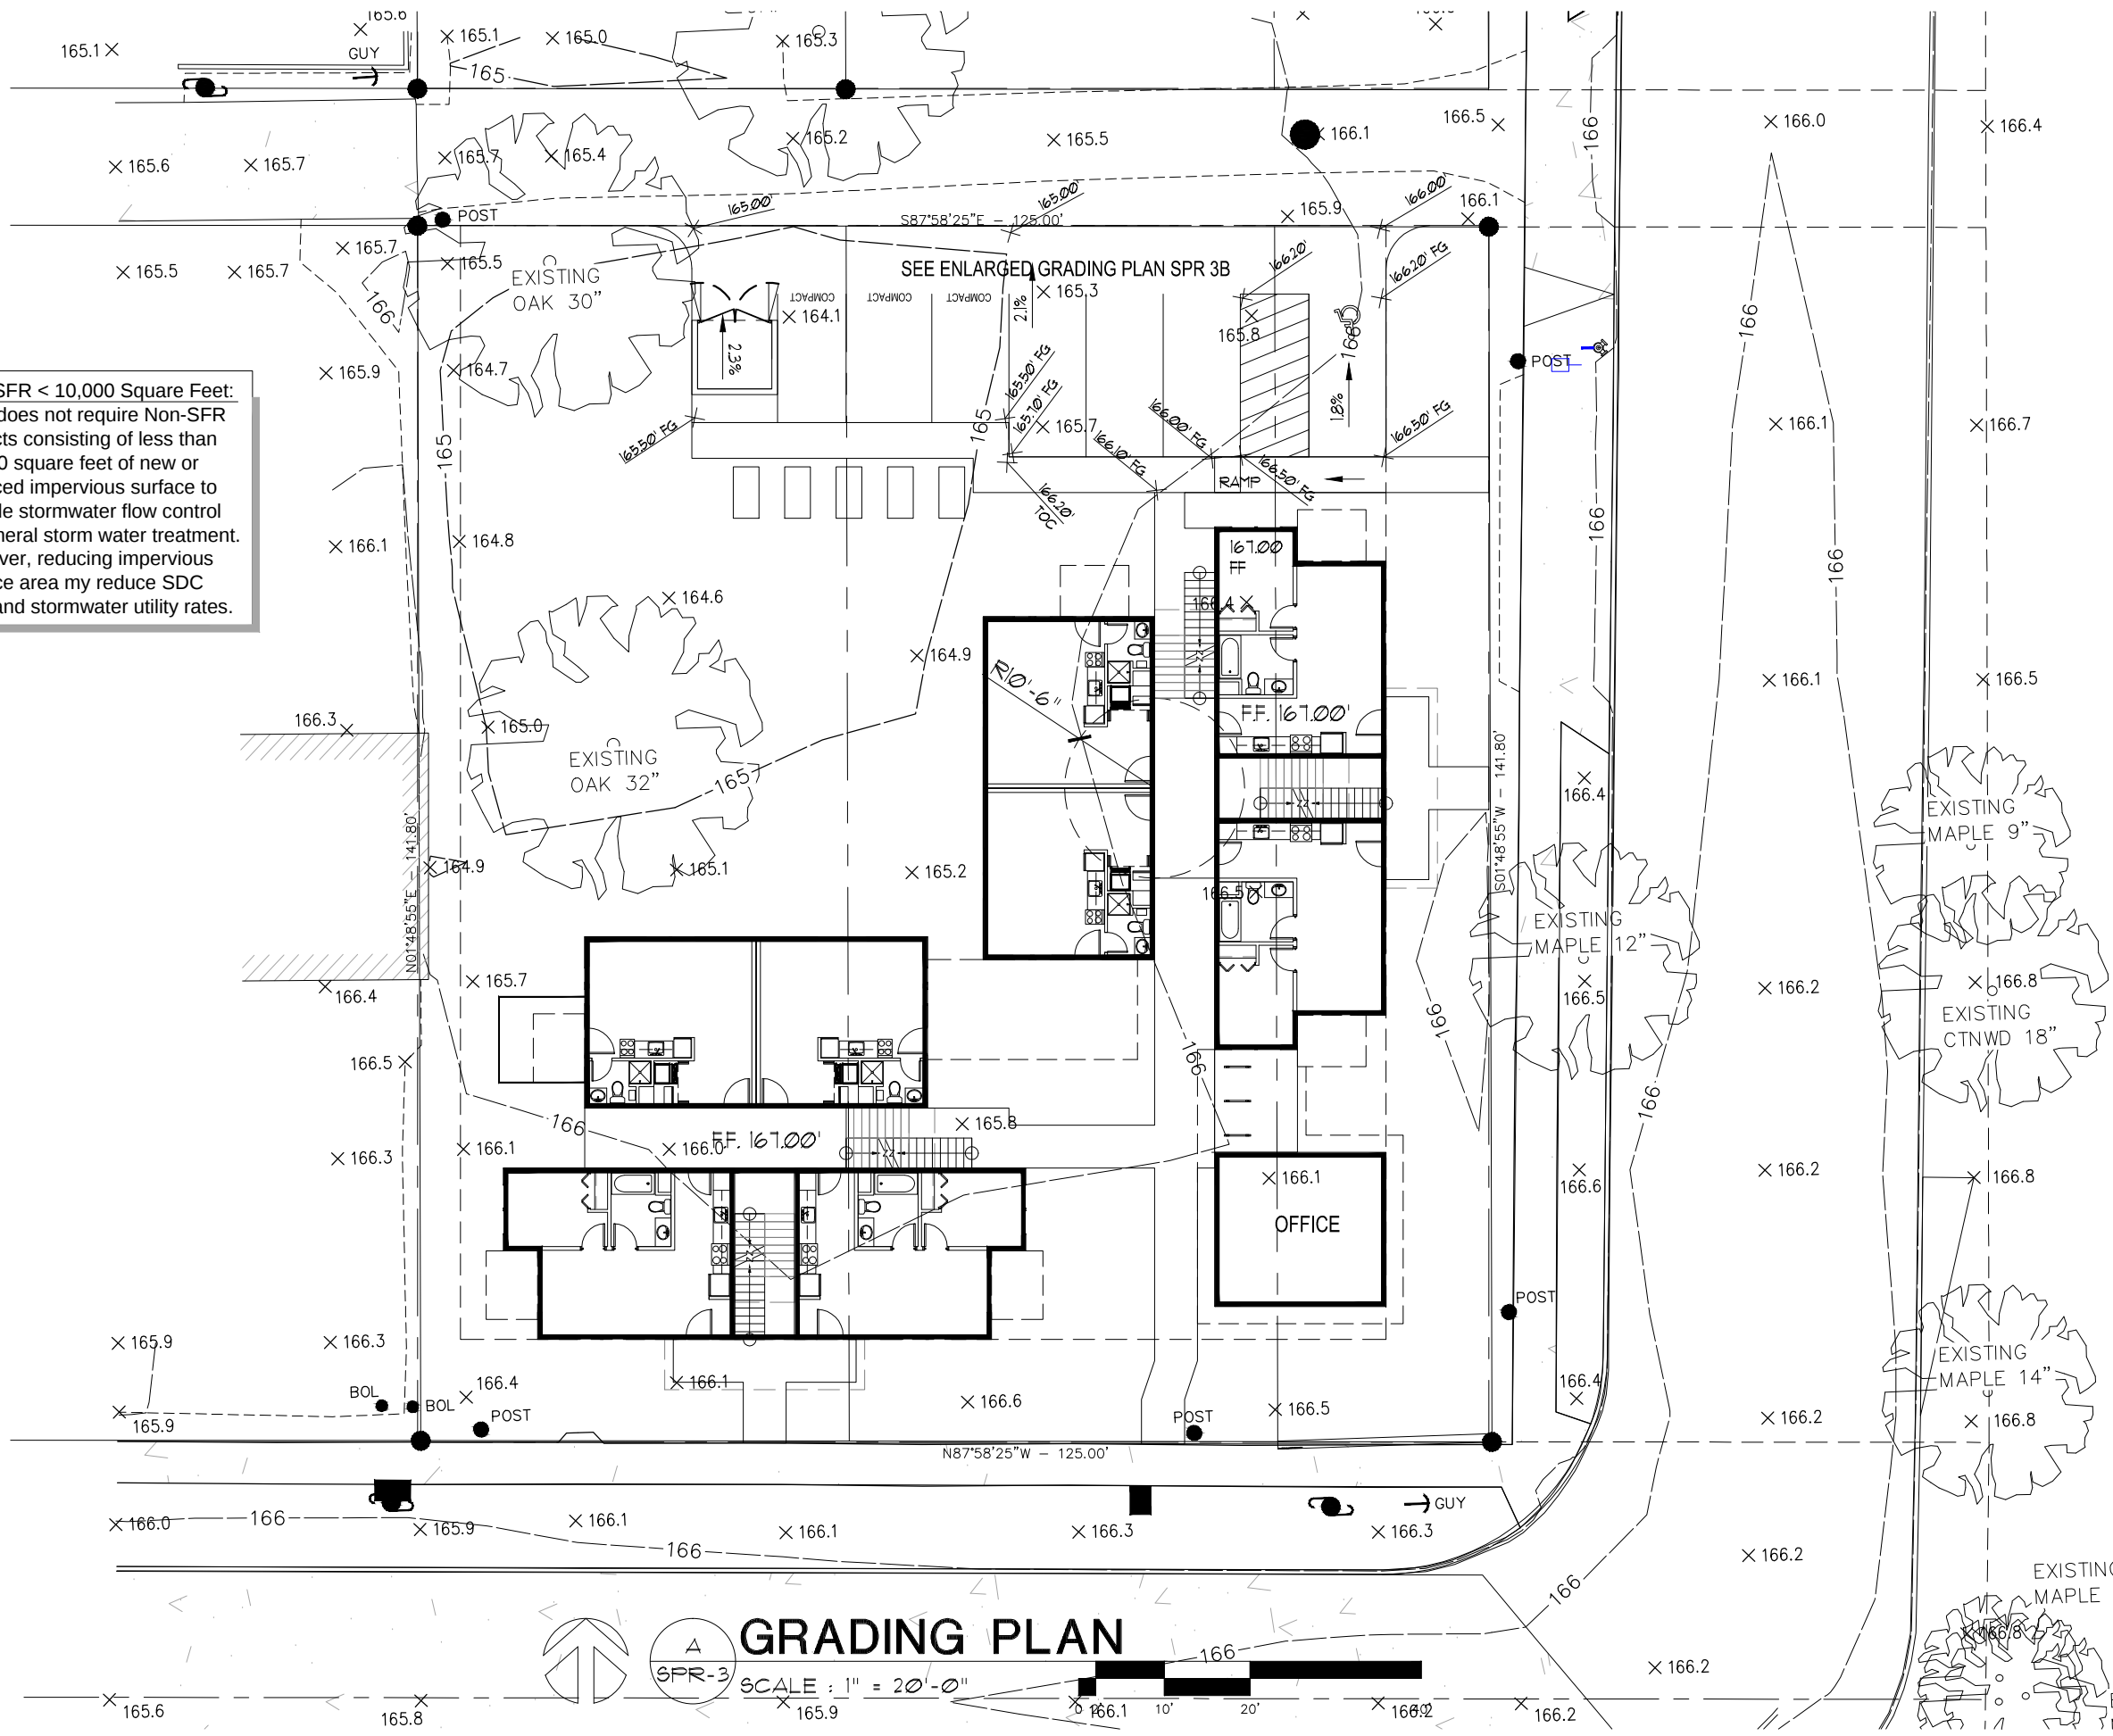

Site Plan Review Class 3
Fahman Glaze Apartments
1341 Waller St., Salem, Or

DATE: 9 JAN 2023
DRAWN: glm
JOB NO.: 2207
SPR 3