


SITE PLAN


CONTRACTOR:

WIND RIVER HOMES
(503) 983-9188

LOT # 44
6,070 SF

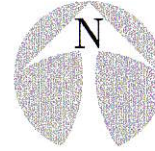

1"=20'

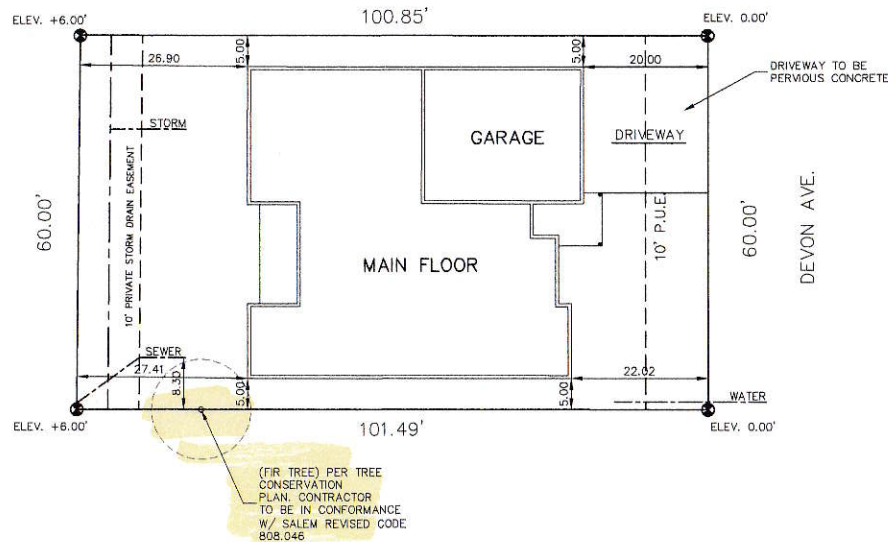

SUBDIVISION: AFFINITY ESTATES LOT: 44 BLK:
NAME: PH. #
ADDRESS: CDA:
ASBUILT # MAP #
STORM DRAINAGE:
WATER SERVICE LEVEL: CODE: PS:
SIDEWALK:

APPROVAL STAMPS

* CONTRACTOR TO VERIFY ALL
DIMENSIONS IN FIELD*

* ALL UTILITY LOCATIONS ARE
TO BE DETERMINED BY CONTRACTOR.*

* ALL PROPERTY ELEVATIONS
ARE TO BE DETERMINED BY CONTRACTOR.*

SITE PLAN
LOT#44. 6731 DEVON AVE. S.E.
SALEM, OREGON
SCALE: 1" = 20.00'