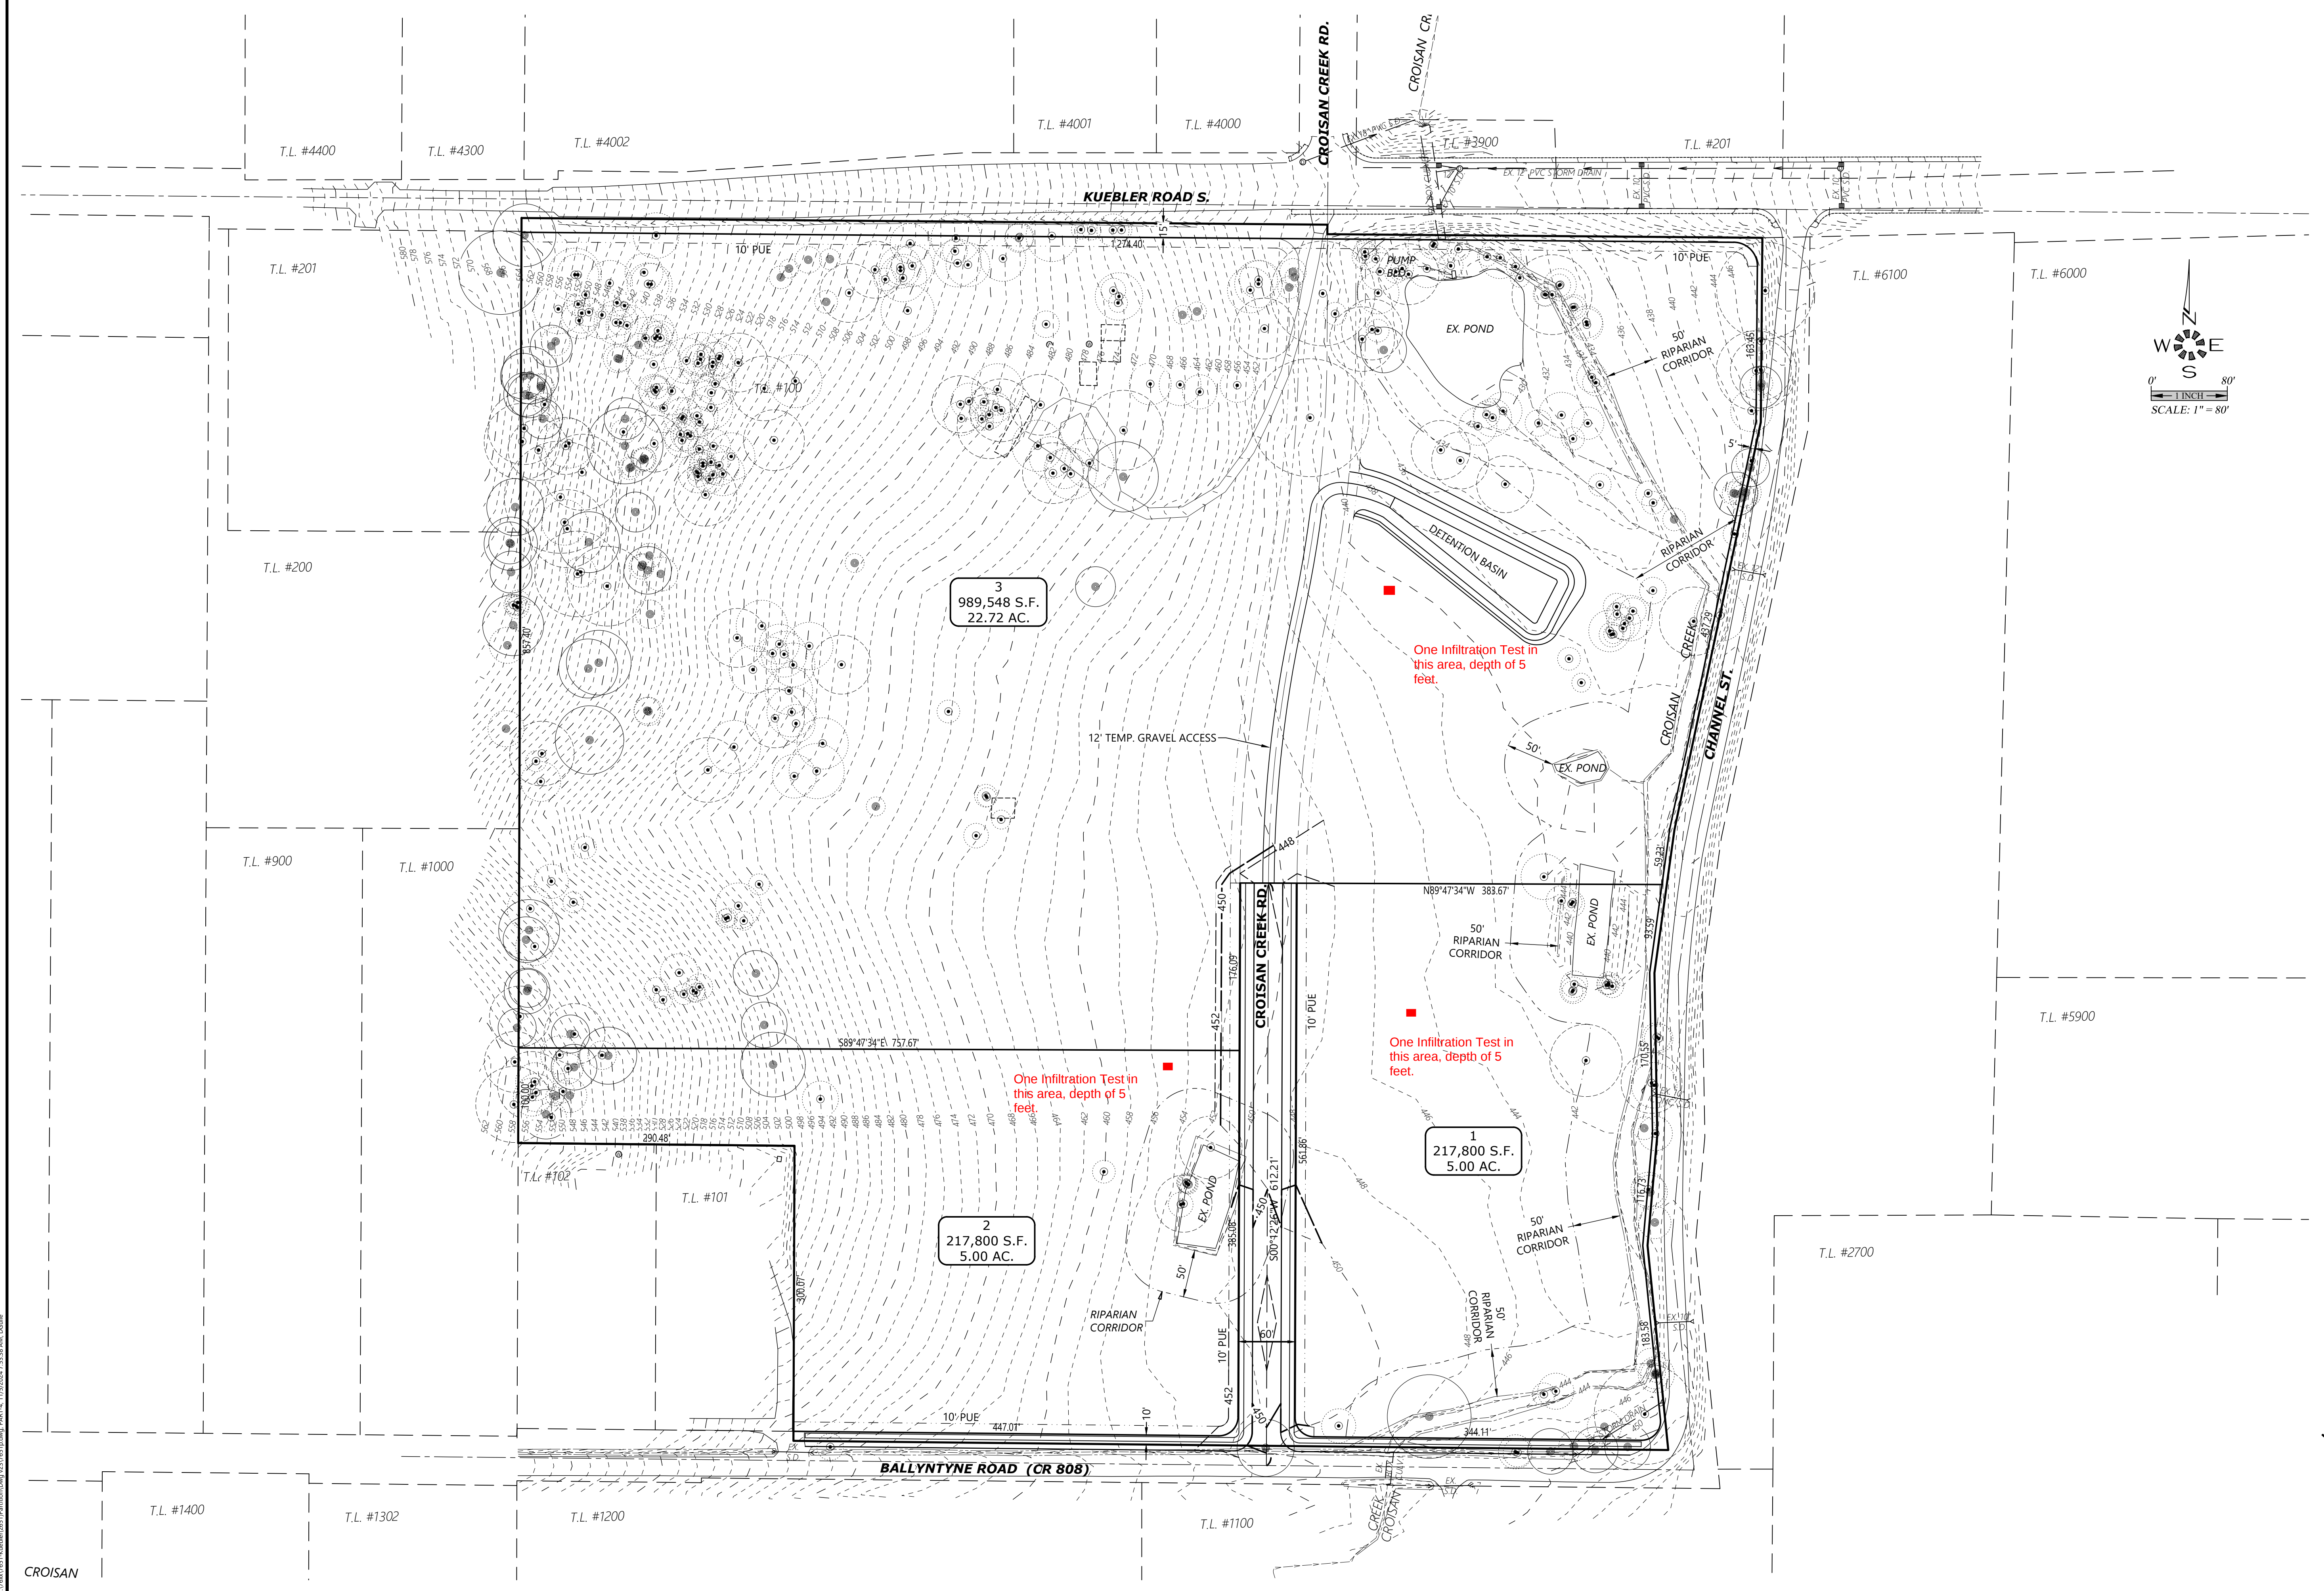


GRADING PLAN

KUEBLER PARTITION

NO CHANGES, MODIFICATIONS
OR REVISIONS TO BE
MADE WITHOUT WRITTEN
AUTHORIZATION FROM THE
DESIGN ENGINEER.
DIMENSIONS & NOTES TAKE
PRECEDENCE OVER
GRAPHICAL REPRESENTATION.

Design: M.D.G.
Drawn: D.G.G.
Checked: M.D.G.
Issue Date: 11/5/24
Scale: AS SHOWN
As-Built: ----

REGISTERED PROFESSIONAL
ENGINEER
OREGON
JULY 14, 1978
MARK D. GREGG
EXPIRES: 6-30-2025
JOB # 7651