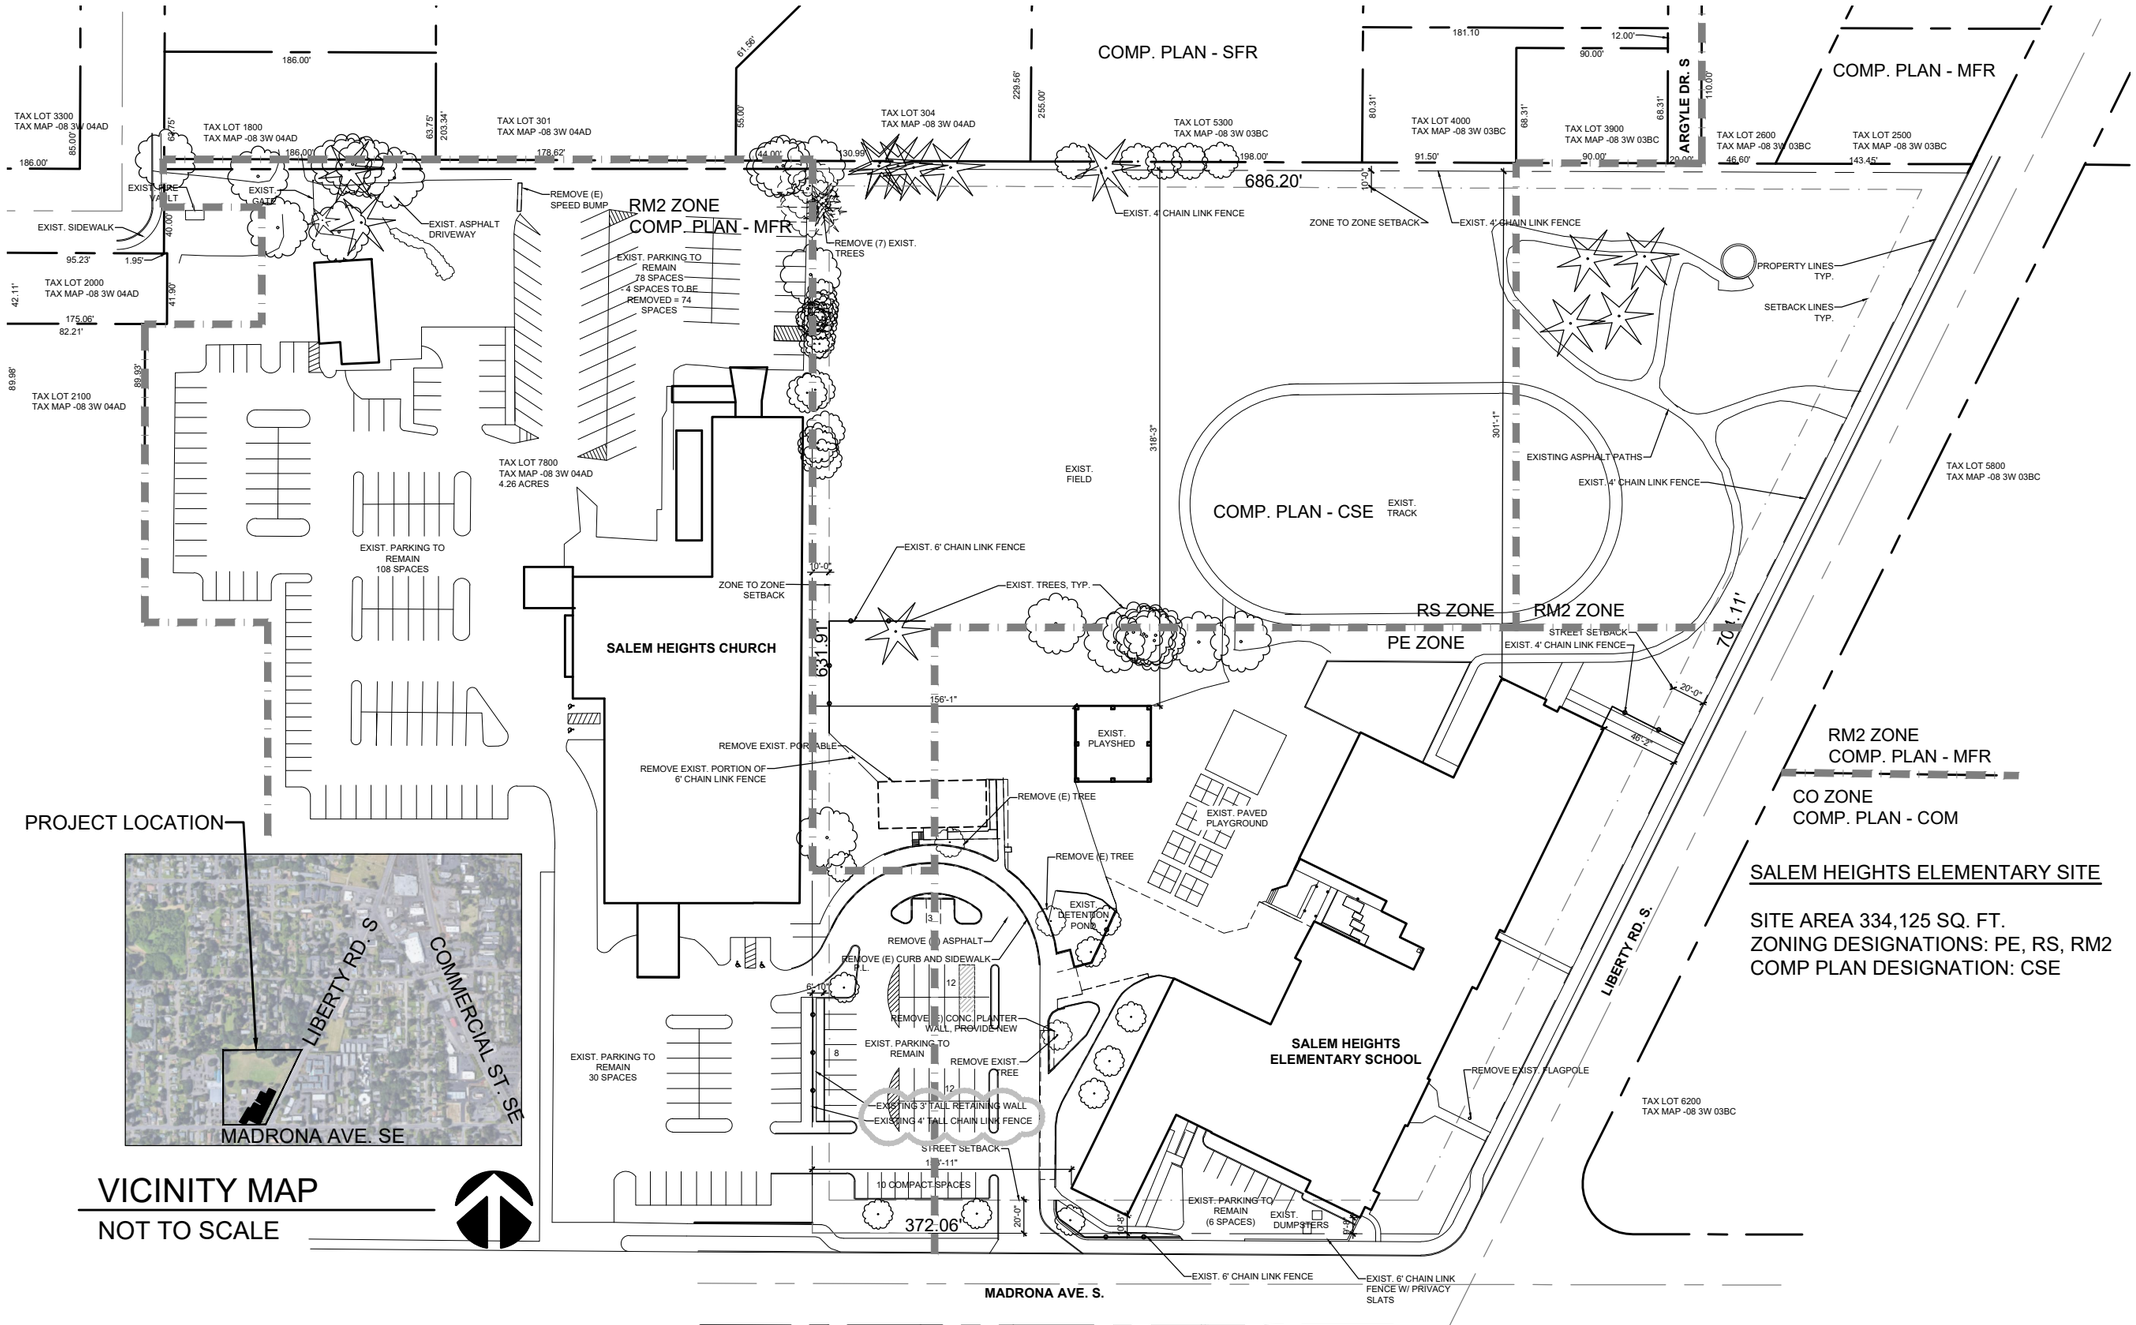

VICINITY MAP

NOT TO SCALE

1 / A0.1 EXISTING SITE PLAN

SCALE: 1" = 90'

RM2 ZONE
COMP. PLAN - MFR

CO ZONE
COMP. PLAN - COM

SALEM HEIGHTS ELEMENTARY SITE

SITE AREA 334,125 SQ. FT.
ZONING DESIGNATIONS: PE, RS, RM2
COMP PLAN DESIGNATION: CSE

ANDERSON SHIRLEY ARCHITECTS
695 COMMERCIAL ST. SE SUITE 5 SALEM, OR 97301
OFFICE: 503-371-1140 FAX: 503-364-6751

CONSULTANT

REV

DESC. REMODEL AND SEISMIC UPGRADE

PROJECT SALEM HEIGHTS ELEMENTARY SCHOOL

ADDRESS 3495 LIBERTY RD S.
SALEM, OREGON 97302

STAMP

REGISTERED ARCHITECT
JOHN M. SHIRLEY
SALEM, OREGON
STATE OF OREGON

JOB 2103 DWG OF Total
DRAWN: KMJ DATE: 10/5/21

TITLE EXISTING SITE PLAN

SHEET A0.1

ISSUE SITE PLAN REVIEW