

NOTICE OF DECISION

PLANNING DIVISION
555 LIBERTY ST. SE, RM 305
SALEM, OREGON 97301
PHONE: 503-588-6173
FAX: 503-588-6005



*Si necesita ayuda para comprender esta informacion, por forvor llame
503-588-6173*

PLANNING ADMINISTRATOR DECISION FOR SITE PLAN REVIEW AND DESIGN REVIEW

CASE TYPE: Class 1 Design Review
AMANDA NO.: 23-117301-DR
DATE OF DECISION: September 15, 2023
PROPERTY LOCATION: 2530 Hyacinth Street NE
APPLICANT: Chandler Cavell
ZONE: MU-III (Mixed-Use III)
COMPREHENSIVE PLAN: Mixed Use
OVERLAY: None

REQUEST

A Class 1 Design Review for a siding replacement for an existing multiple family complex on a 7.22-acre property in the MU-III (Mixed Use III) Zone and located at 2530 Hyacinth Street NE (Marion County Assessor Map and Tax Lot 073W12AC / 1800 / 2200).

Land Use

The proposed development includes the replacement of the siding of an existing multiple-family complex. The multiple family use is listed as a permitted use in the MU-III zone per SRC Chapter 535, Table 535-1. The applicant's proposal is not changing or intensifying the existing multiple family use.

Historic Property Status

The subject property is not listed as a historic resource and subject property it is not within an historic overlay zone.

Previous Land Use Actions

No previous land use actions.

1. Class 1 Design Review Approval Criteria

The purpose of Design Review is to create a process to review development applications that are subject to design review guidelines and design review standards.

SRC 225.005(e)(1) provides that a Class 1 Design Review shall be approved if all of the applicable design review standards are met.

Except as provided under SRC 702.005(b), and unless otherwise provided in the UDC, design review under SRC chapter 225 is required for all multiple family development.

A summary of the applicable design standards of SRC Chapter 702 is included below:

SRC 702.020 - Design Review Standards for Multiple Family Development with Thirteen or More Units.

(a) *Open Space Standards.*

- (1) To encourage the preservation of natural open qualities that may exist on a site and to provide opportunities for active and passive recreation, all newly constructed multiple family developments shall provide a minimum 30 percent of the gross site area in designated and permanently reserved open space. For the purposes of this subsection, the term "newly constructed multiple family developments" shall not include multiple family developments created through only construction or improvements to the interior of an existing building(s). Indoor or covered recreation space may count toward this open space requirement.
- (A) To ensure usable open space that is of sufficient size, at least one common open space area shall be provided that meets the size and dimension standards set forth in Table 702-3.

TABLE 702-3. COMMON OPEN SPACE AREA SIZE AND DIMENSIONS		
Number of Dwelling Units	Minimum Open Space Area Size	Minimum Horizontal Dimension
13 to 20	750 sq. ft.	25 ft.
More than 20	1,000 sq. ft., plus an additional 250 sq. ft. for every 20 units, or portion thereof, over 20 units.	25 ft.

- (B) To ensure the provided open space is usable, a maximum of 15 percent of the common open space shall be located on land with slopes greater than 25 percent.
- (C) To allow for a mix of different types of open space areas and flexibility in site design, private open space, meeting the size and dimension standards set forth in Table 702-4, may count toward the open space requirement. All private open space must meet the size and dimension standards set forth in Table 702-4.

TABLE 702-4. PRIVATE OPEN SPACE SIZE AND DIMENSIONS		
Location of Dwelling Unit	Minimum Open Space Area Size	Minimum Dimension
Not more than 5 feet above finished grade	96 sq. ft.	6 ft.
More than 5 feet above finished grade	48 sq. ft.	6 ft.

- (D) To ensure a mix of private and common open space in larger developments, private open space, meeting the size and dimension standards set forth in Table 702-4, shall be provided for a minimum of 20 percent of the dwelling units in all newly constructed multiple family developments with 20 or more dwelling units. Private open space shall be located contiguous to the dwelling unit, with direct access to the private open space provided through a doorway.
- (E) To encourage active recreational opportunities for residents, the square footage of an improved open space area may be counted twice toward the total amount of required open space, provided each such area meets the standards set forth in this subsection. Example: a 750-square-foot improved open space area may count as 1,500 square feet toward the open space requirement.
 - (i) Be a minimum 750 square feet in size with a minimum dimension of 25 feet for all sides; and
 - (ii) Include at least one of the following types of features:
 - a. Covered pavilion.
 - b. Ornamental or food garden.
 - c. Developed and equipped children's play area, with a minimum 30-inch tall fence to separate the children's play area from any parking lot, drive aisle, or street.
 - d. Sports area or court (e.g., tennis, handball, volleyball, basketball, soccer).
 - e. Swimming pool or wading pool.
- (F) To encourage proximity to and use of public parks, the total amount of required open space may be reduced by 50 percent for developments that are located within one-quarter mile of a public urban, community, or neighborhood park as measured along a route utilizing public or private streets that are existing or will be constructed with the development.

Finding: The proposal is for a siding replacement for an existing multiple family complex. No changes are proposed to expand existing parking lots or building footprints or to reduce any existing open space areas, common or private. This standard does not apply to the proposed development.

(b) *Landscaping standards.*

- (1) To encourage the preservation of trees and maintain or increase tree canopy, a minimum of one tree shall be planted or preserved for every 2,000 square feet of gross site area.
- (2) Where a development site abuts property that is zoned Residential Agricultural (RA) or Single Family Residential (RS), a combination of landscaping and screening shall be provided to buffer between the multiple family development and the abutting RA or RS zoned property. The landscaping and screening shall include the following:
 - (A) A minimum of one tree, not less than 1.5 inches in caliper, for every 30 linear feet of abutting property width; and

- (B) A minimum six-foot tall, decorative, sight-obscuring fence or wall. The fence or wall shall be constructed of materials commonly used in the construction of fences and walls, such as wood, stone, rock, brick, or other durable materials. Chainlink fencing with slats shall be not allowed to satisfy this standard.
- (3) To define and accentuate primary entryways, a minimum of two plant units, shall be provided adjacent to the primary entryway of each dwelling unit, or combination of dwelling units.
- (4) To soften the visual impact of buildings and create residential character, new trees shall be planted, or existing trees shall be preserved, at a minimum density of ten plant units per 60 linear feet of exterior building wall. Such trees shall be located not more than 25 feet from the edge of the building footprint.
- (5) Shrubs shall be distributed around the perimeter of buildings at a minimum density of one plant unit per 15 linear feet of exterior building wall.
- (6) To ensure the privacy of dwelling units, ground level private open space shall be physically and visually separated from common open space with perimeter landscaping or perimeter fencing.
- (7) To provide protection from winter wind and summer sun and to ensure trees are distributed throughout a site and along parking areas, a minimum of one canopy tree shall be planted along every 50 feet of the perimeter of parking areas. Trunks of the trees shall be located within ten feet of the edge of the parking area (see Figure 702-3).
 - (A) A minimum of one canopy tree shall be planted within each planter bay.
 - (B) A landscaped planter bay a minimum of nine feet in width shall be provided at a minimum spacing of one for every 12 spaces. (see Figure 702-3).
- (8) Multiple family developments with 13 or more units are exempt from the landscaping requirements in SRC chapter 806.

Finding: The proposal is for a siding replacement for an existing multiple family complex. No changes are proposed to expand existing parking lots, change building footprints, or to develop any new entries that would reduce any existing common or private open space areas, or landscaping. This standard does not apply to the proposed development.

(c) *Site safety and security.*

- (1) Windows shall be provided in all habitable rooms, other than bathrooms, on each wall that faces common open space, parking areas, and pedestrian paths to encourage visual surveillance of such areas and minimize the appearance of building bulk.
- (2) Lighting shall be provided that illuminates all exterior dwelling unit entrances, parking areas, and pedestrian paths within the development to enhance visibility and resident safety.
- (3) Fences, walls, and plant materials shall not be installed between street-facing dwelling units and public or private streets in locations that obstruct the visibility of dwelling unit entrances from the street. For purposes of this standard, the term

"obstructed visibility" means the entry is not in view from the street along one-half or more of the dwelling unit's frontage.

- (4) Landscaping and fencing adjacent to common open space, parking areas, and dwelling unit entryways shall be limited to a maximum height of three feet to encourage visual surveillance of such areas.

Finding: The proposal is for a siding replacement for an existing multiple family complex. No changes to the existing windows, lighting, fences, landscaping, windows or dimensions are proposed and no new units or alterations to existing parking lots are proposed. This standard does not apply to the proposed development.

(d) *Parking and site design.*

- (1) To minimize large expanses of continuous pavement, parking areas greater than 6,700 square feet in area shall be physically and visually separated with landscaped planter bays that are a minimum of nine feet in width. Individual parking areas may be connected by an aisle or driveway (see Figure 702-3).
- (2) To minimize the visual impact of on-site parking and to enhance the pedestrian experience, off-street surface parking areas and vehicle maneuvering areas shall be located behind or beside buildings and structures. Off-street surface parking areas and vehicle maneuvering areas shall not be located between a building or structure and a street.
- (3) Where a development site abuts, and is located uphill from, property zoned Residential Agriculture (RA) or Single Family Residential (RS), and the slope of the development site within 40 feet of the abutting RA or RS zoned property is 15 percent or greater, parking areas shall be set back not less than 20 feet from the property line of the abutting RA or RS zoned property to ensure parking areas are designed to consider site topography and minimize visual impacts on abutting residential properties.
- (4) To ensure safe pedestrian access to and throughout a development site, pedestrian pathways shall be provided that connect to and between buildings, common open space, and parking areas, and that connect the development to the public sidewalks.

Finding: The proposal is for a siding replacement for an existing multiple family complex. No expansion or alteration is proposed to the existing parking areas. This standard does not apply to the proposed development.

(e) *Façade and building design.*

- (1) To preclude long monotonous exterior walls, buildings shall have no dimension greater than 150 feet.
- (2) Where a development site abuts property zoned Residential Agricultural (RA) or Single Family Residential (RS), buildings shall be setback from the abutting RA or RS zoned property as set forth in Table 702-5 to provide appropriate transitions between new buildings and structures on site and existing buildings and structures on abutting sites.

TABLE 702-5. SETBACKS ABUTTING PROPERTY ZONED RA AND RS	
Number of Building Stories	Minimum Setback
1	Min. 1 foot for each 1 foot of building height, but in no case less than 14 ft.
2 or more	Min. 1 foot for each 1 foot of building height, but in no case less than 20 ft.

- (A) A 5-foot reduction is permitted to each required setback in Table 702-5 provided that the height of the required fence in Sec. 702.020(b)(2)(B) is increased to eight feet tall.
- (3) To enhance compatibility between new buildings on site and abutting residential sites, balconies located on building facades that face RA or RS zoned properties, unless separated by a street, shall have fully sight-obscuring railings.
- (4) On sites with 75 feet or more of buildable width, a minimum of 40 percent of the buildable width shall be occupied by building placed at the setback line to enhance visual interest and activity along the street. Accessory structures shall not apply towards meeting the required percentage.
- (5) To orient buildings to the street, any ground-level unit, cluster of units, interior lobbies, or portions thereof, located within 25 feet of the property line abutting a street shall have a building entrance facing that street, with direct pedestrian access to adjacent sidewalks.
- (6) A porch or architecturally defined entry area shall be provided for each ground level dwelling unit. Shared porches or entry areas shall be provided to not more than four dwelling units. Individual and common entryways shall be articulated with a differentiated roof, awning, stoop, forecourt, arcade or portico.
- (7) Roof-mounted mechanical equipment, other than vents or ventilators, shall be screened from ground level view. Screening shall be as high as the top of the mechanical equipment and shall be integrated with exterior building design.
- (8) To reinforce the residential character of the neighborhood, flat roofs, and the roof ridges of sloping roofs, shall not exceed a horizontal length of 100 feet without providing differences in elevation of at least four feet in height. In lieu of providing differences in elevation, a cross gable or dormer that is a minimum of four feet in length may be provided. (See Figure 702-4)
- (9) To minimize the appearance of building bulk, each floor of each building's vertical face that is 80 feet in length or longer shall incorporate one or more of the design elements below (see examples in Figure 702-5). Design elements shall vary from other wall surfaces by a minimum of four feet and such changes in plane shall have a minimum width of six feet.
- (A) Offsets (recesses and extensions).
- (B) Covered deck.
- (C) Covered balcony.
- (D) Cantilevered balcony provided at least half of its depth is recessed.

- (E) Covered entrance.
- (10) To visually break up the building's vertical mass, the first floor of each building, except for single-story buildings, shall be distinguished from its upper floors by at least one of the following (see examples in Figure 702-6):
 - (A) Change in materials.
 - (B) Change in color.
 - (C) Molding or other horizontally-distinguishing transition piece.

Finding: The proposal is for a siding replacement for an existing multiple family complex. The standards identified in SRC 702.020(1-8) do not apply to this proposal as no changes are proposed to the buildings' dimensions, setbacks, patios, decks, balconies, orientation, roofs, or entrances.

The applicant is proposing to replace the existing siding with similar siding in material and with a bellyband wrapping around the building above the first floor the same as the trim color to break up the building's vertical mass, consistent with SRC 702.020 (10). As proposed, the development meets this standard.

1. Conclusion

Based on conformance with the preceding requirements, the Planning Administrator finds that the proposed site plan for property located at 2530 Hyacinth complies with approval criteria provided in SRC 225.005(e)(1).

DECISION

Final approval of the attached site plan is hereby GRANTED subject to SRC Chapter 225 and the applicable standards of the Salem Revised Code and providing compliance occurs with any applicable items noted above. This decision is a final land use decision.

Please Note: Findings included in this decision by the direction of the Salem Fire Department are based on non-discretionary standards. Fire Code related findings are intended to inform the applicant of the clear and objective Fire Prevention Code standards of SRC Chapter 58 that will apply to this development proposal on application for building permit(s). Additional or different Fire Prevention Code standards may apply based on the actual building permit application submitted.

If a building permit application has not already been submitted for this project, please submit a copy of this decision with your building permit application for the work proposed.

If you have any questions regarding items in this site plan review, please contact Abigail Pedersen at 503-540-2309 or by email at apedersen@cityofsalem.com




Abigail Pedersen, Planner I, on behalf of
Lisa Anderson-Ogilvie, AICP
Planning Administrator

Application Deemed Complete:	<u>September 13, 2023</u>
Decision Mailing Date:	<u>September 15, 2023</u>
State Mandated Decision Date:	<u>January 11, 2024</u>

Attachments: A) Vicinity Map
 B) Proposed Elevations

G:\CD\PLANNING\CASE APPLICATION Files 2011-On\DESIGN REVIEW (Class 1)\2022\23-117301-DR.arp.docx

Vicinity Map 2530 Hyacinth Street NE

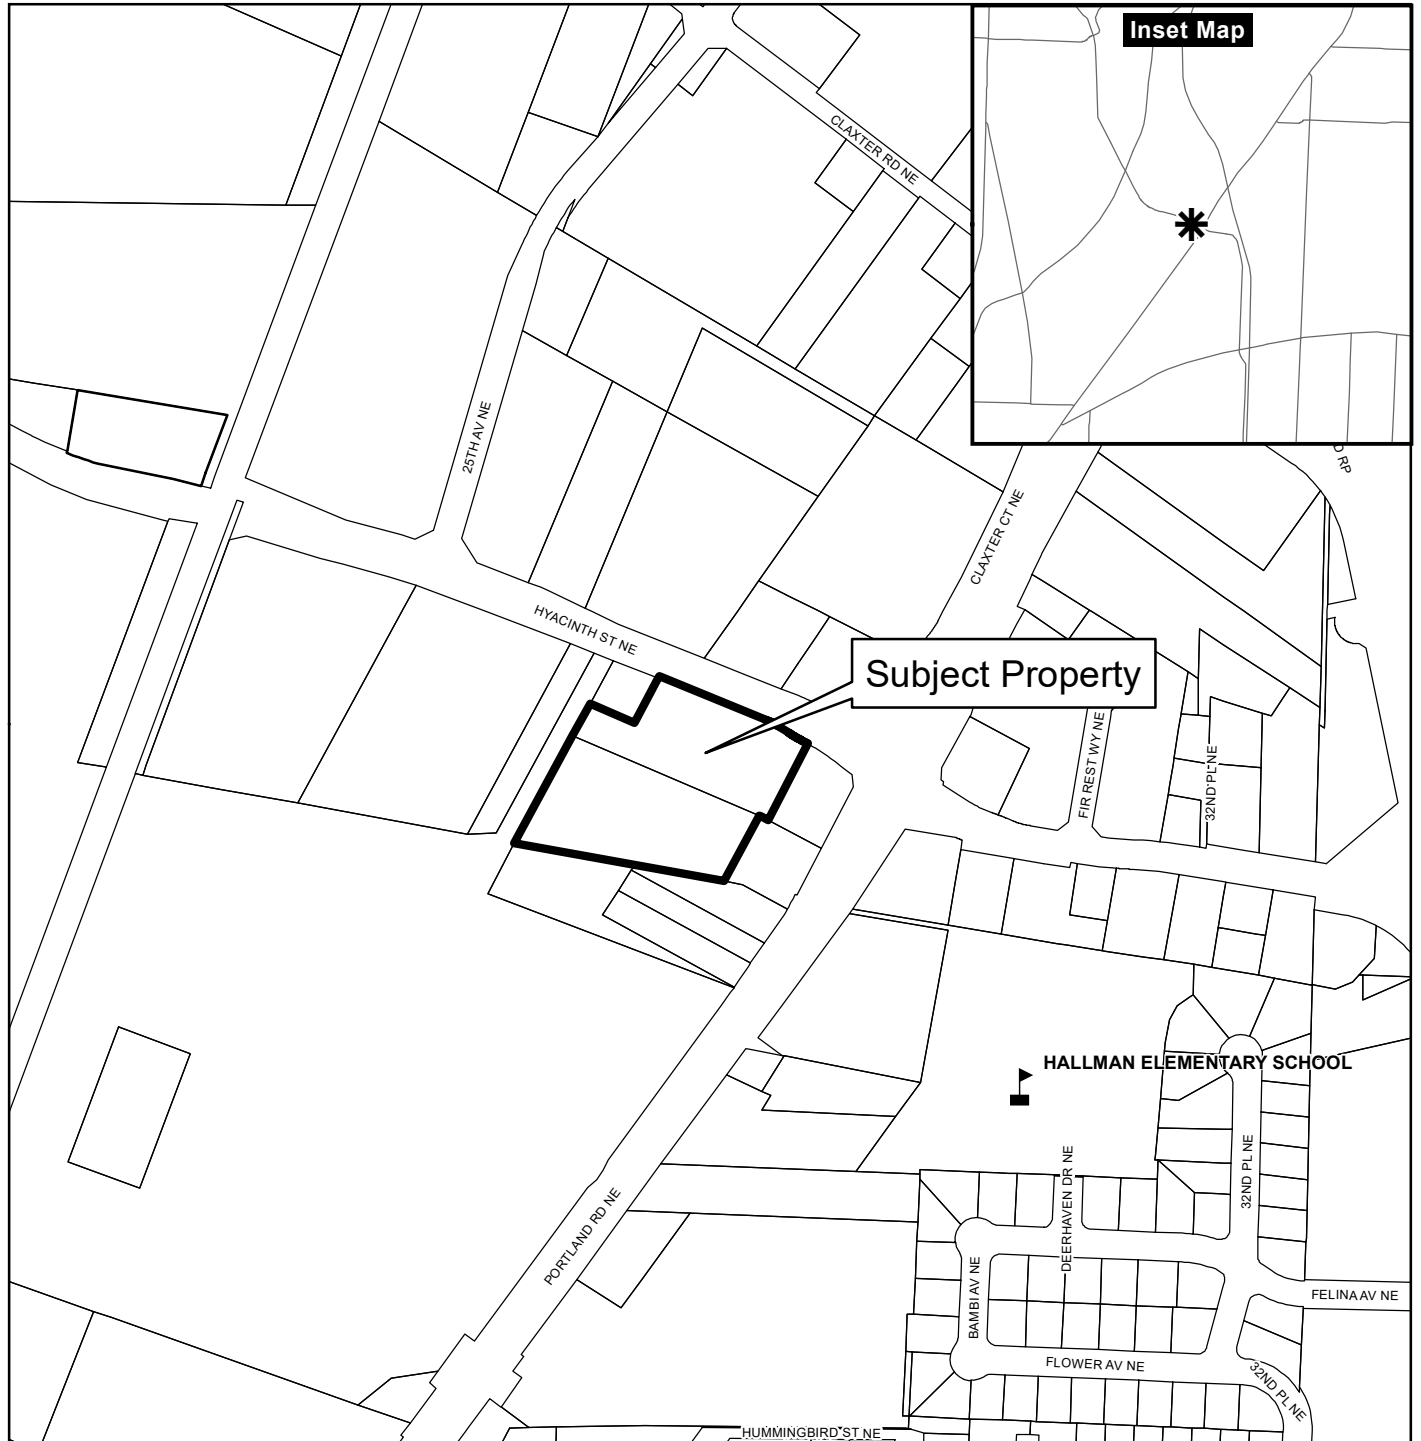

Legend

Taxlots

Urban Growth Boundary

City Limits

Outside Salem City Limits

Historic District

Schools


Parks

CITY OF Salem
AT YOUR SERVICE
Community Development Dept.

This product is provided as is, without warranty. In no event is the City of Salem liable for damages from the use of this product. This product is subject to license and copyright limitations and further distribution or resale is prohibited.

0 100 200 400 Feet



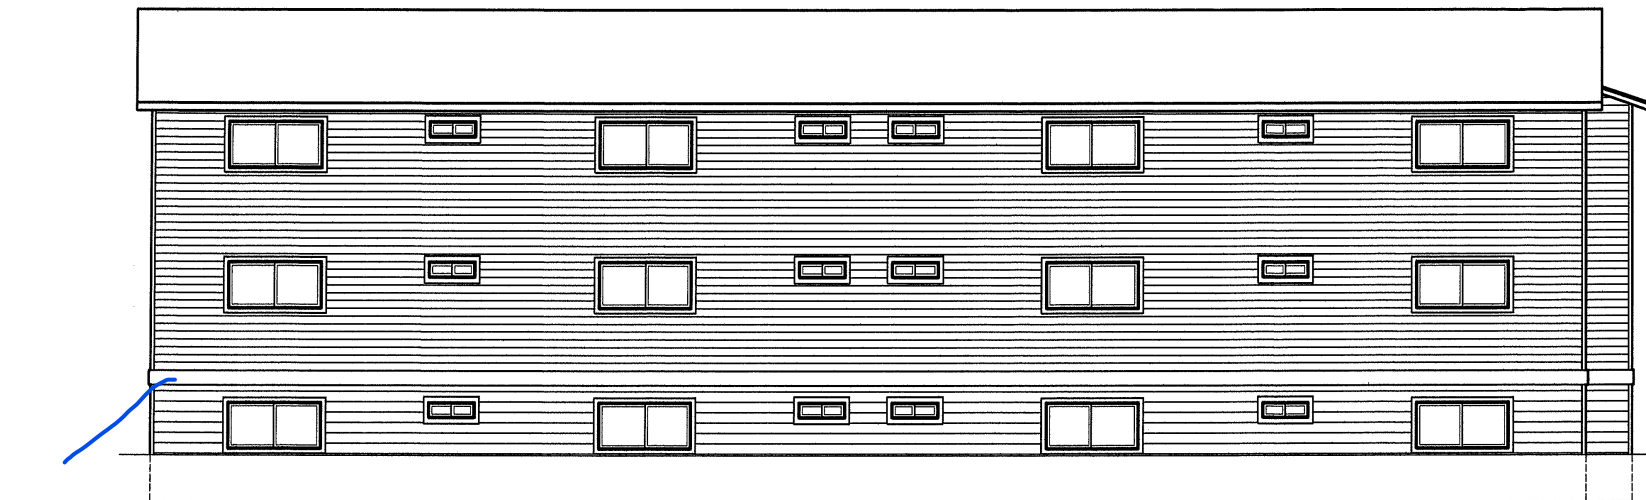

One row of trim colored siding

EAST ELEVATION



NORTH ELEVATION

ELEVATIONS

Scale
1/8" = 1'

DATE: 1-15-2012


SCALE: 1/8" = 1'-0"

FILE # 1088.TL


PROJECT: 1088

PAGE

1

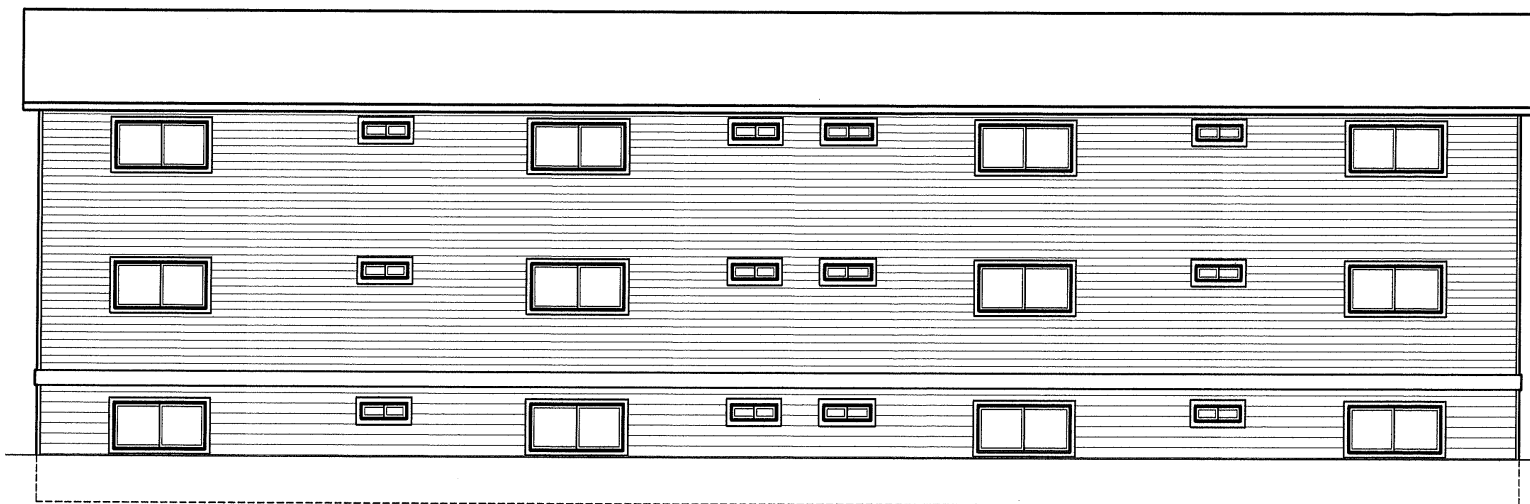

WEST ELEVATION

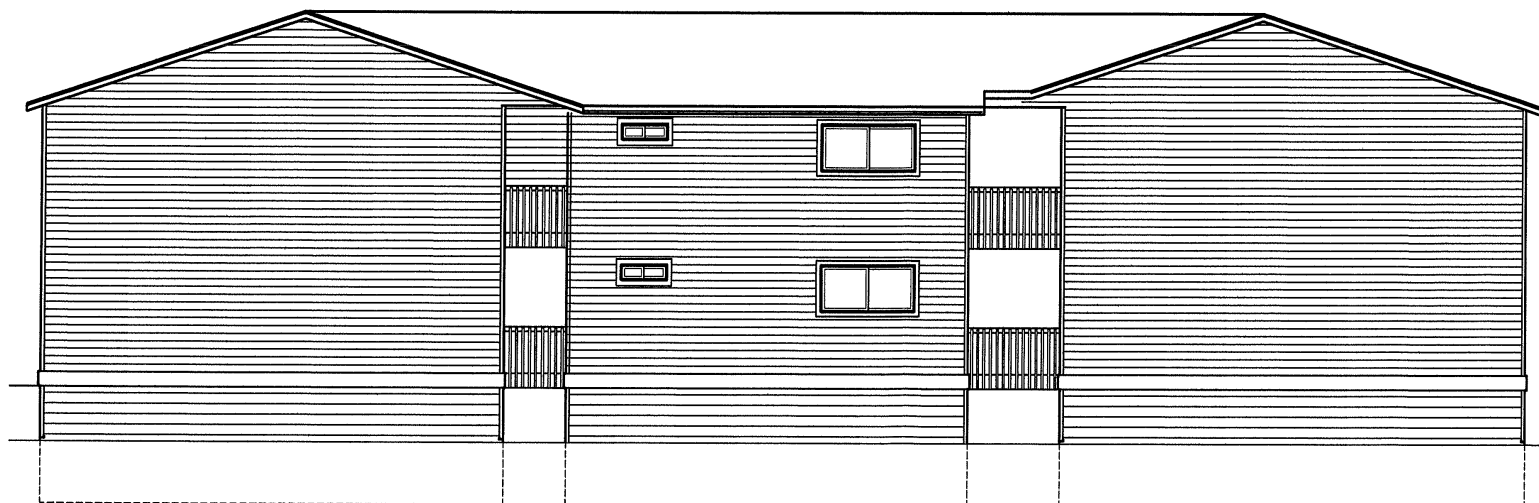

SOUTH ELEVATION

ELEVATIONS

Scale
 $1/8" = 1'$

DATE: 7-25-2012

SCALE: 1/8" = 1'-0"

FILE # 100811

PROJECT: 1008

PAGE

2